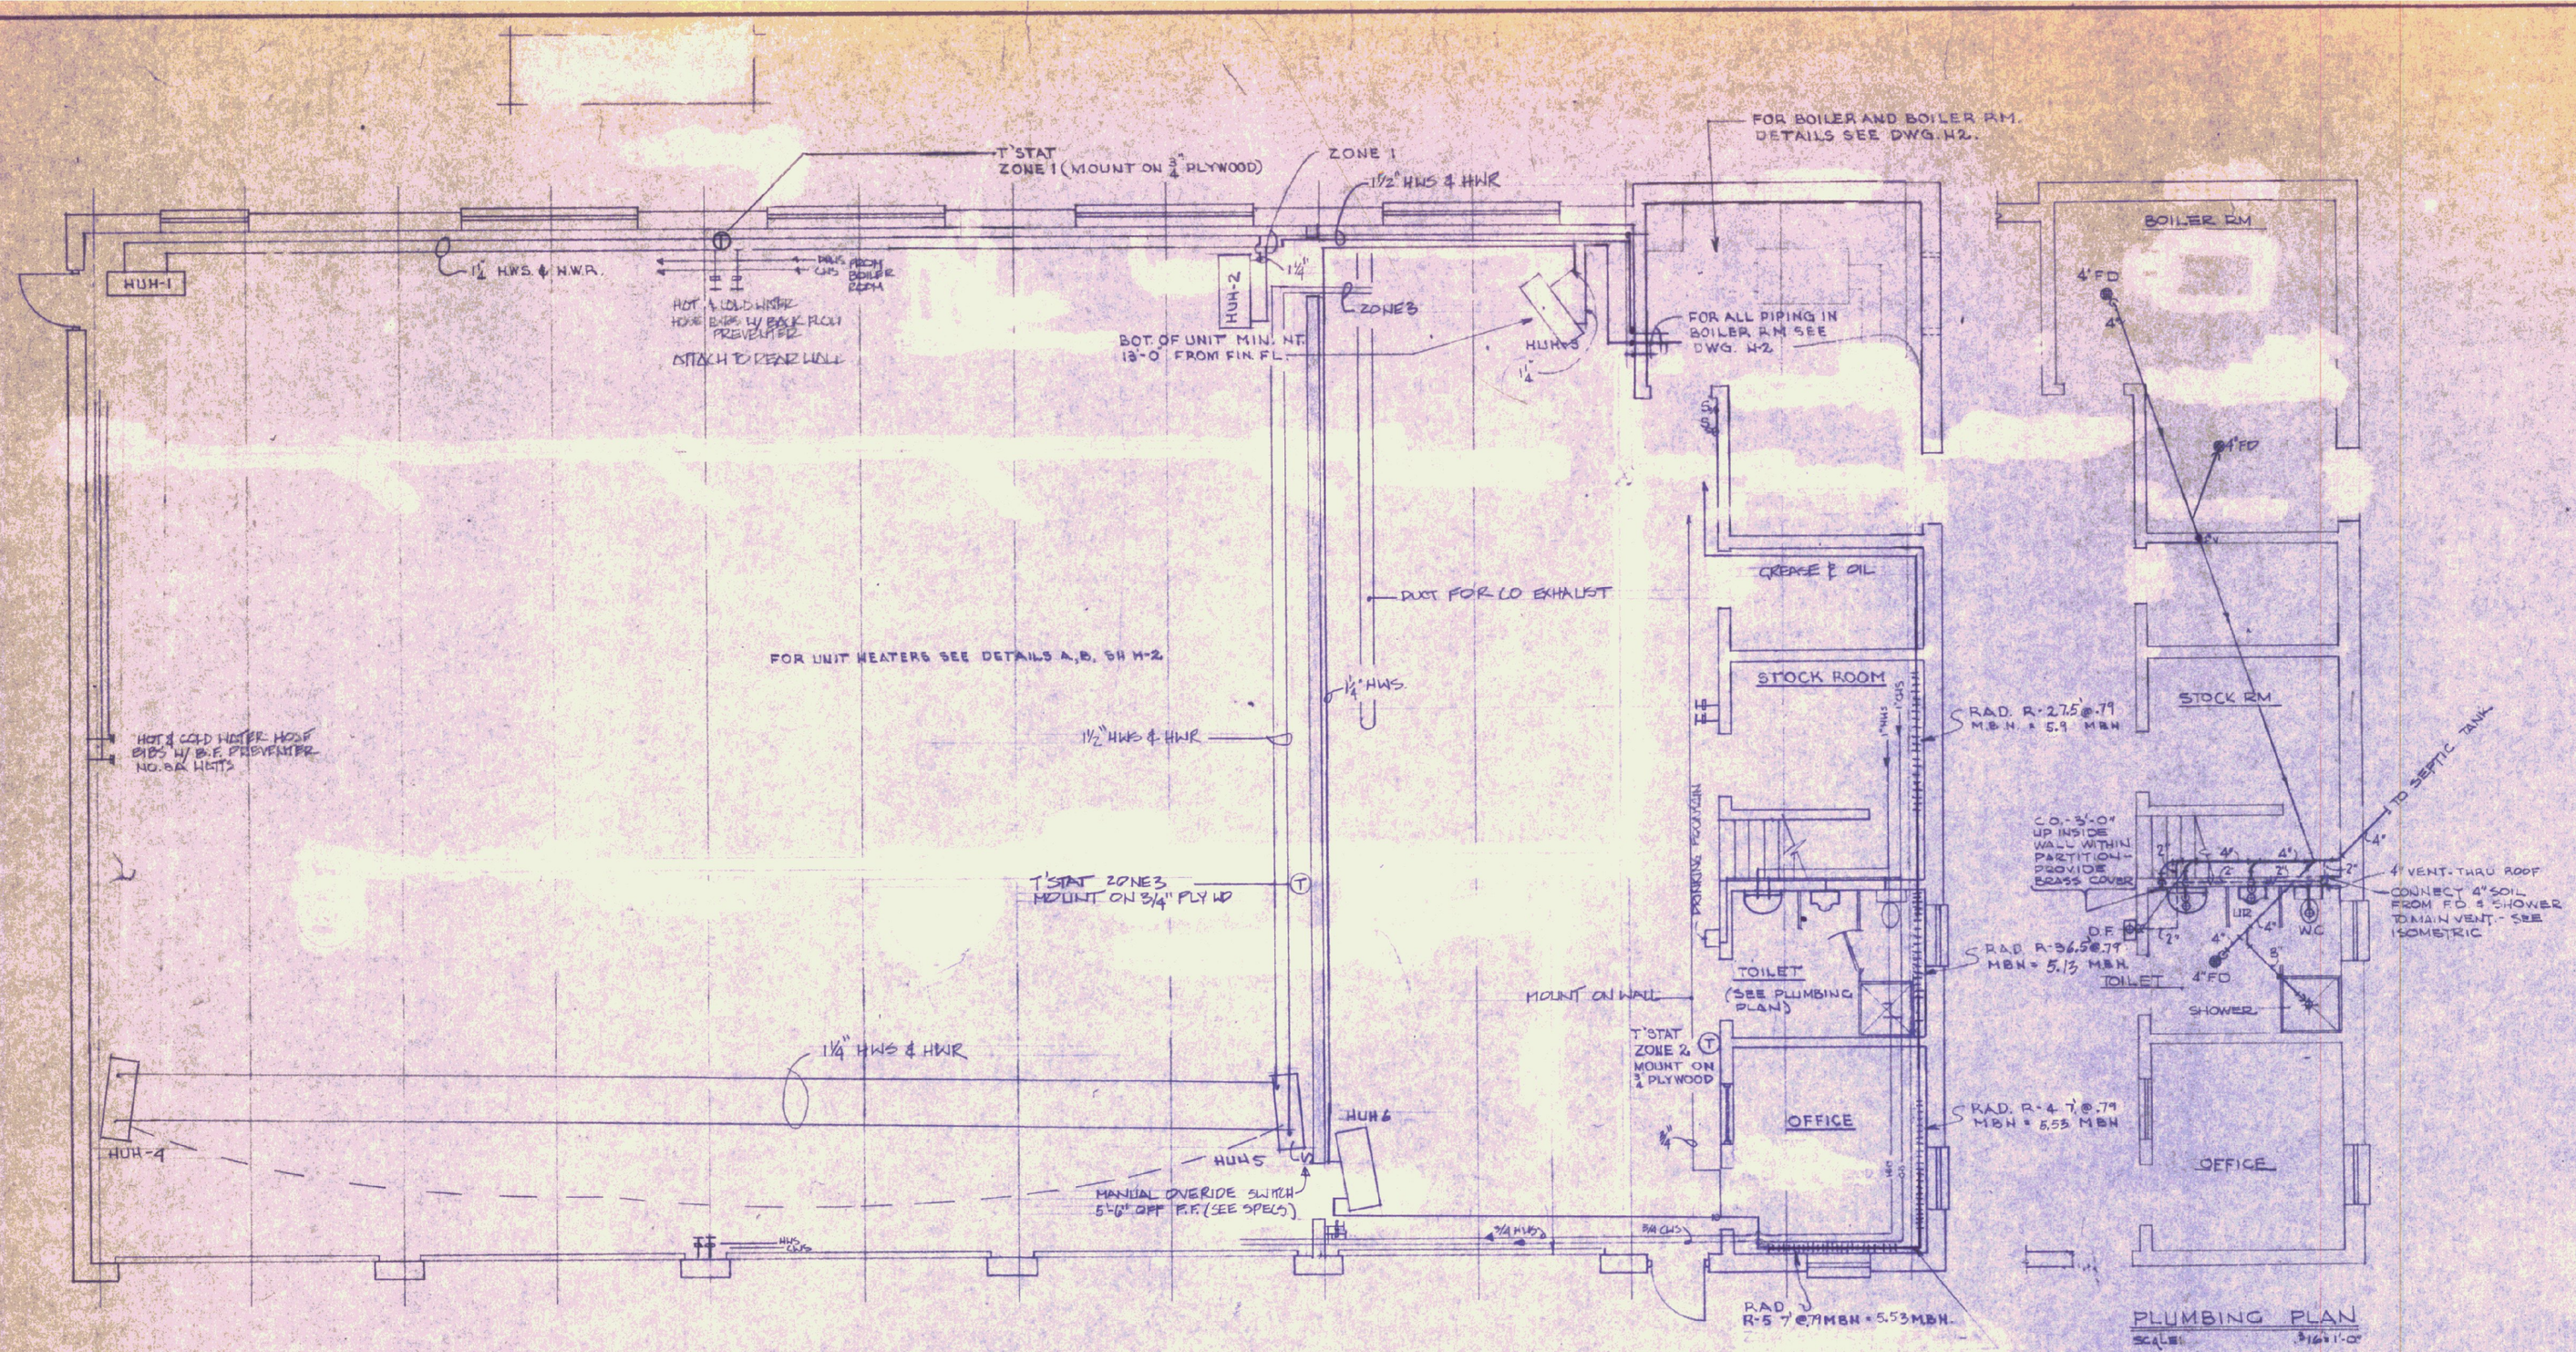

HEATING PLAN (5 BAY)

SCALE: 3/16" = 1'-0"

PLUMBING PLAN

SCALE: 3/16" = 1'-0"

N O T E

SEE DRAWING H-2 FOR SCHEDULE & GENERAL NOTES

LEGEND

H.W.S.	
H.W.R.	
S	BURNER SAFETY SWITCH (MTD @ 5' ABOVE FIN. FL.)
T	T'STATS
VUH	PIPE SUPPLY TO BOTTOM & RETURN TO TOP.
HUH	" " " "
	GATE VALVE
	CHECK VALVE
	BALANCING COCK
	FLOW CONTROL VALVE
	UNION
	FUSIBLE LEVER-MATIC VALVE
	STRAINER
	P.R.V. - ALL BRONZE
	BACK FLOW PREVENTER

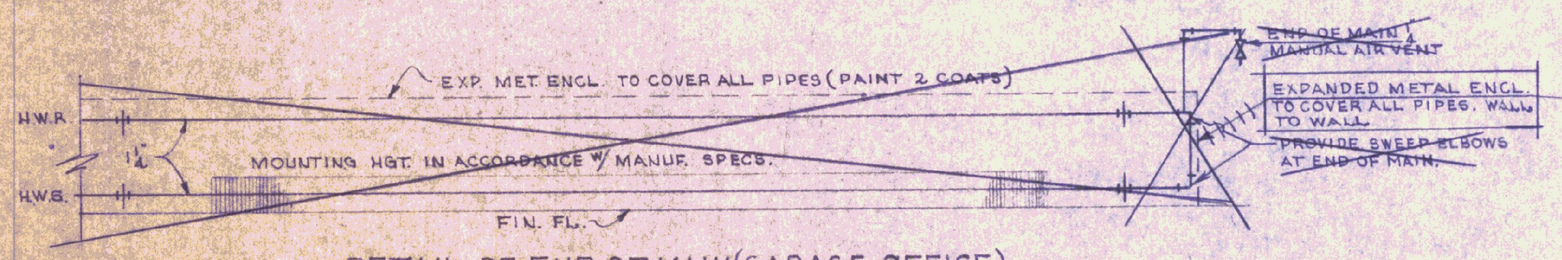

DETAIL OF END OF MAIN (GARAGE OFFICE)

SCALE: 1" = 1'-0"

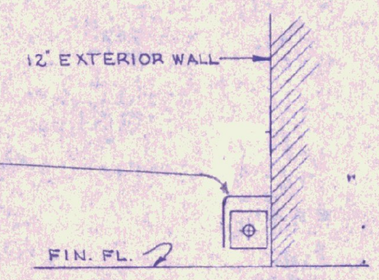

TYPICAL SECTION

SCALE: 1" = 1'-0"

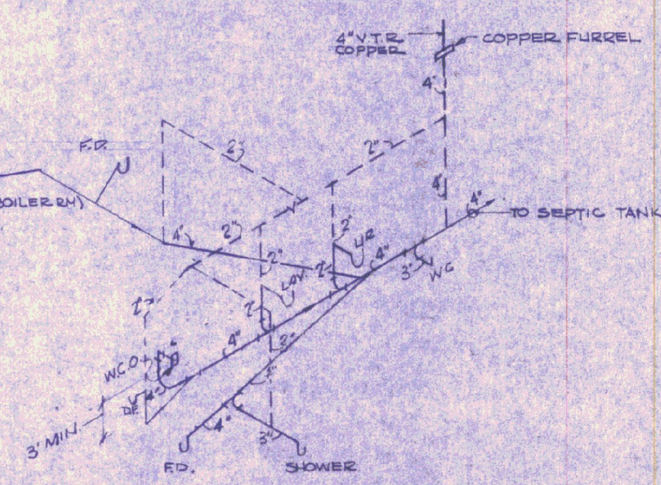

PLUMBING ISOMETRIC DIAGRAM

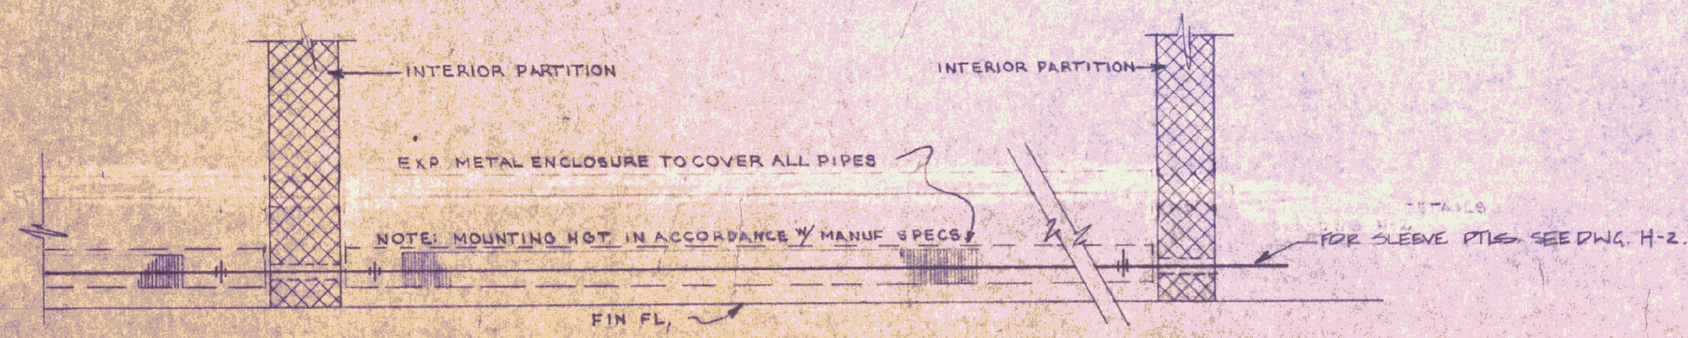

TYPICAL BASEBOARD RADIATION PIPING (1 PIPE SYSTEM)

SCALE: 1" = 1'-0"

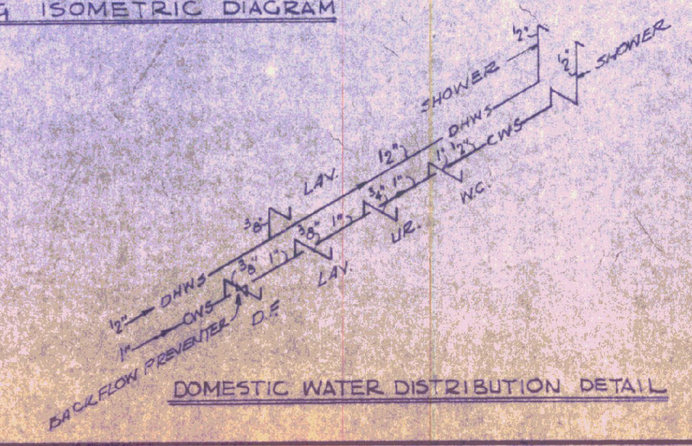

DOMESTIC WATER DISTRIBUTION DETAIL

REVISIONS	DATE	REVISION
	10-16-78	ADD - WORK SHEET NO. 2 SHEET, USE OF TERMS DRAWING - D.F., & ISOMETRIC PLUMBING
	6-15-79	WORK

STATE OF VERMONT
DIVISION OF STATE BUILDINGS
AGENCY OF ADMINISTRATION
MONTPELIER, VERMONT

Standard Five Bay Highway Garage Bldg.

HEATING PLAN

SCALE: As noted

RSW

DATE: 10-18-74	DESIGNED BY: GUS MASTRO	DWG. NO. H1
DRAWN BY: STUDIO SEVEN INC.	APPROVED BY: Thomas J. Salt	1 OF 1