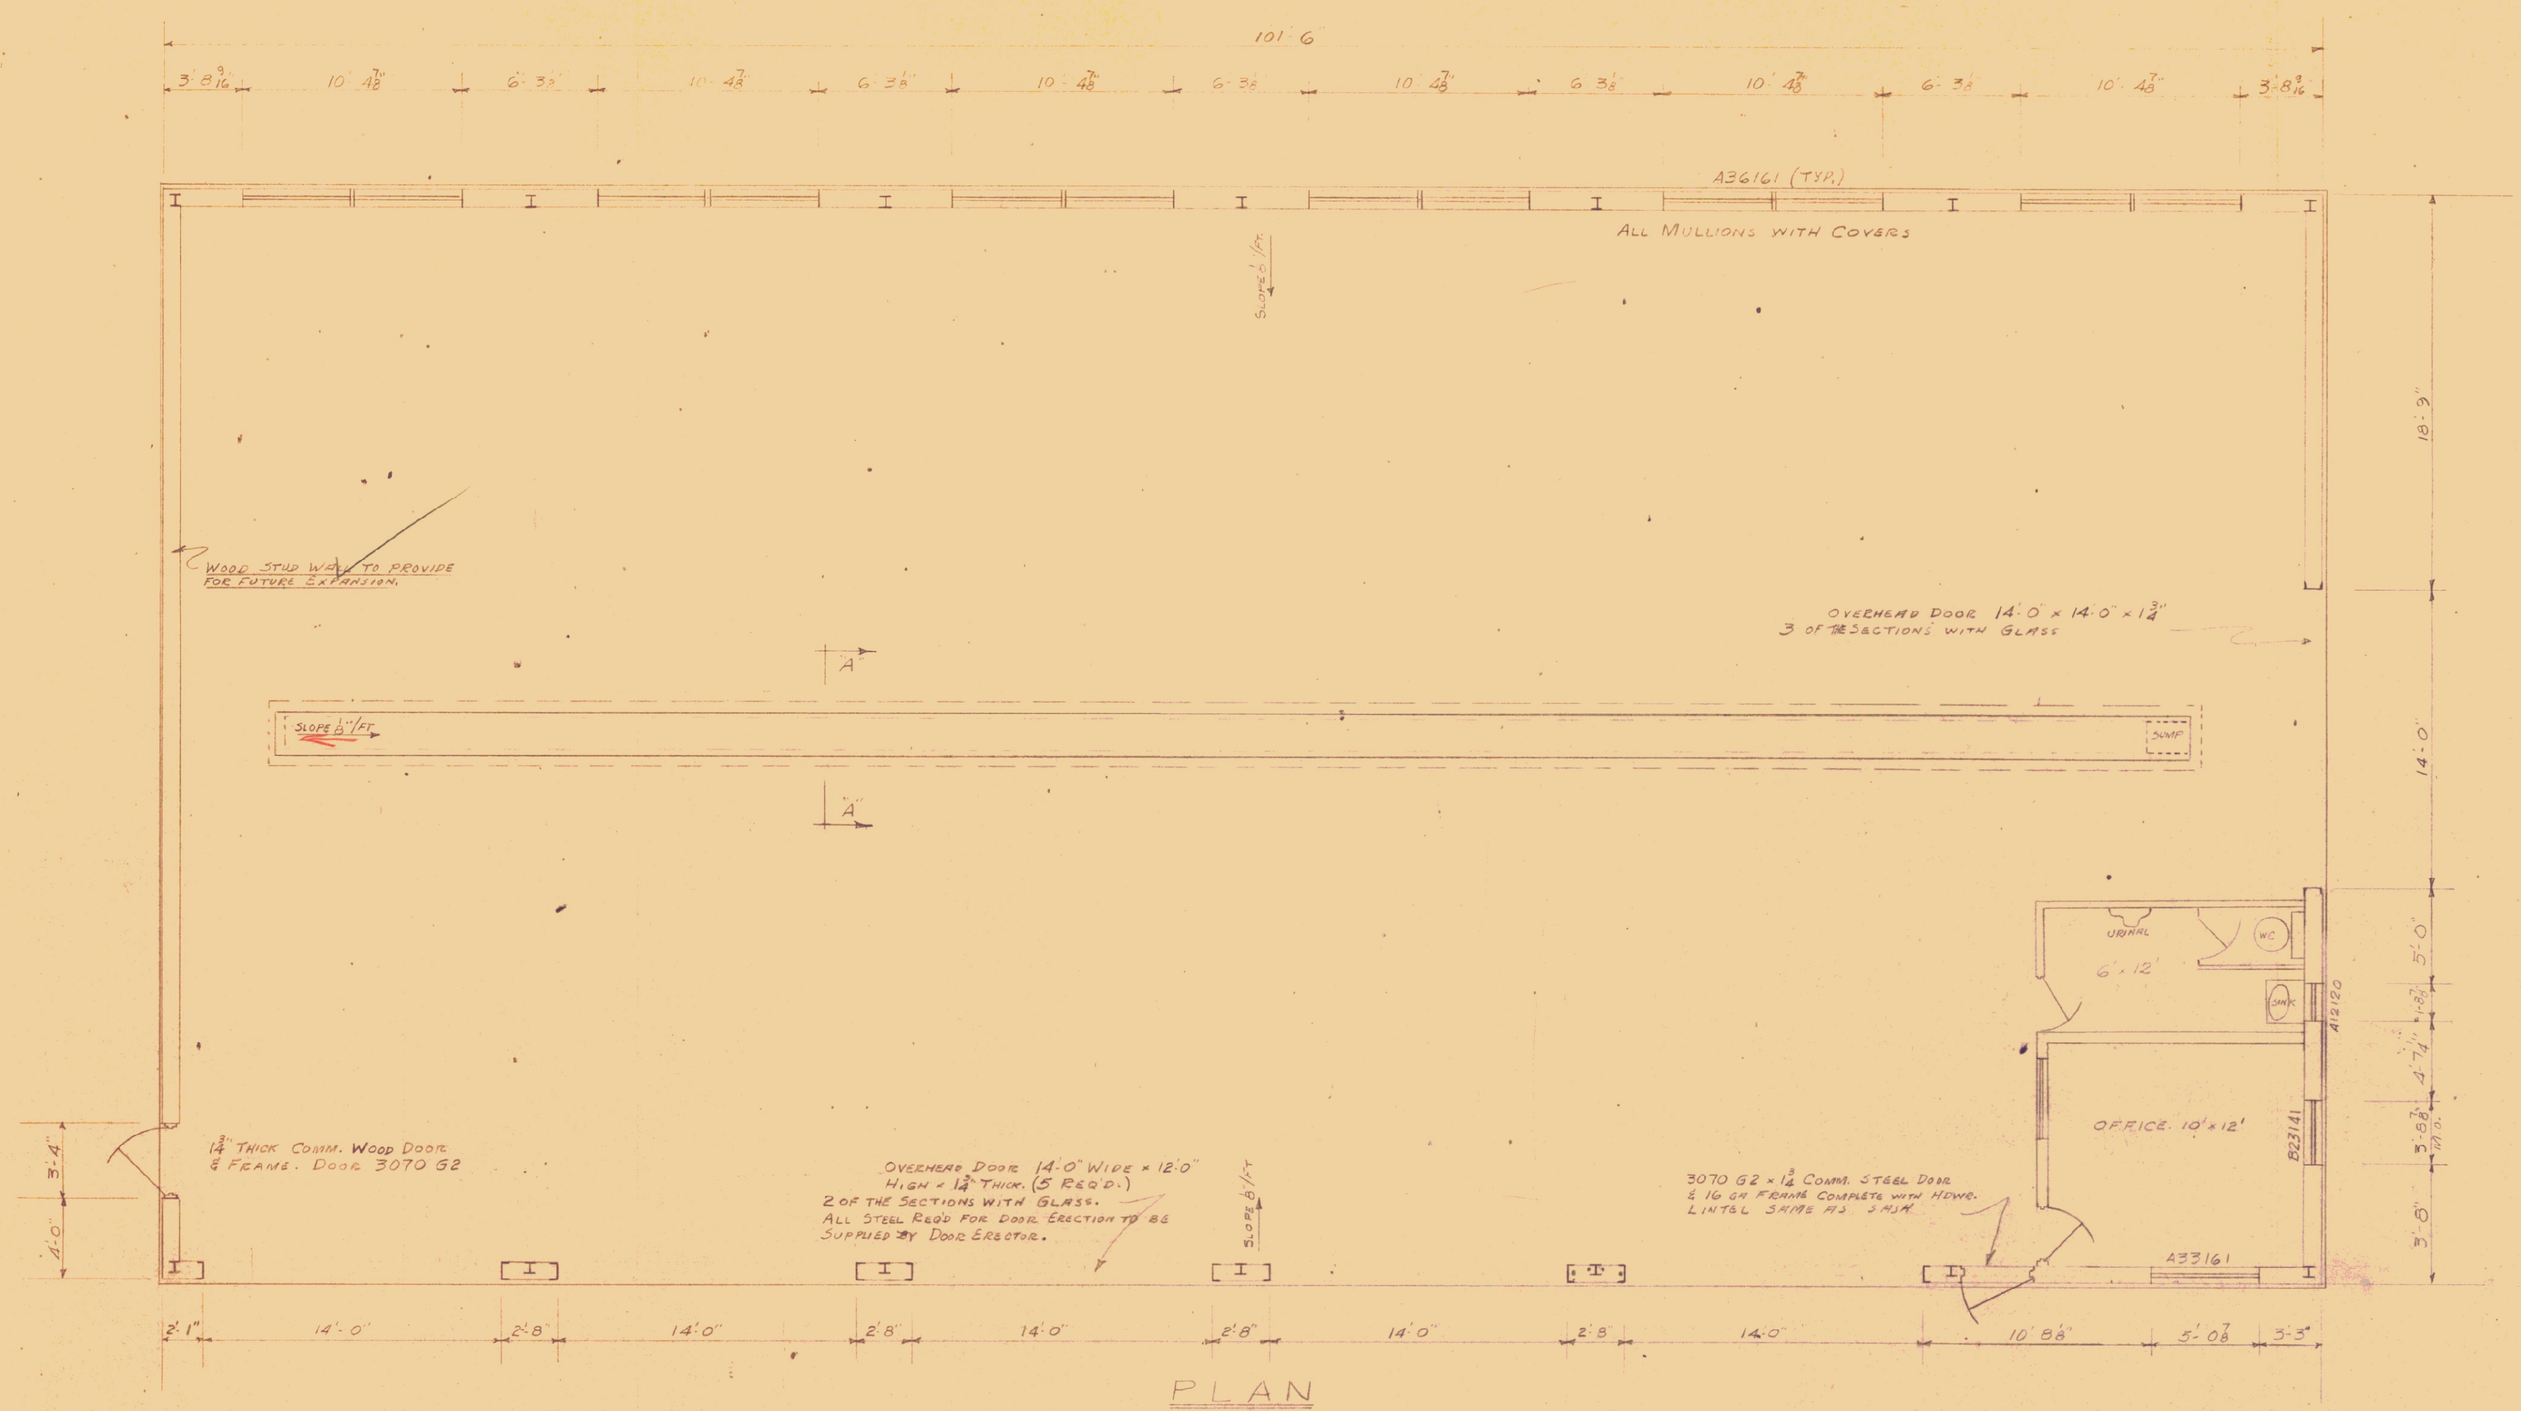

PLAN
SCALE 3/16"

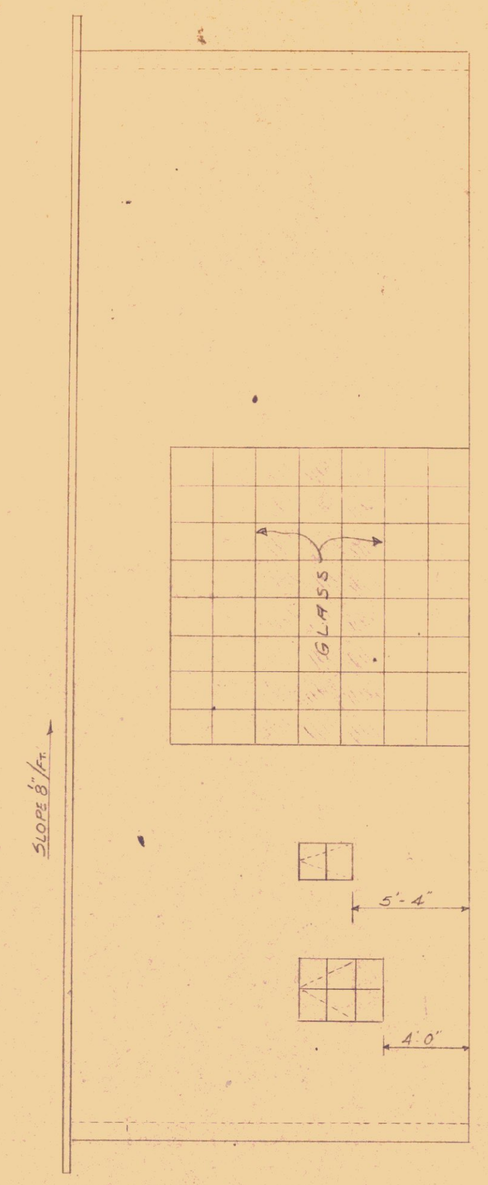

END ELEVATION
SCALE 3/16"

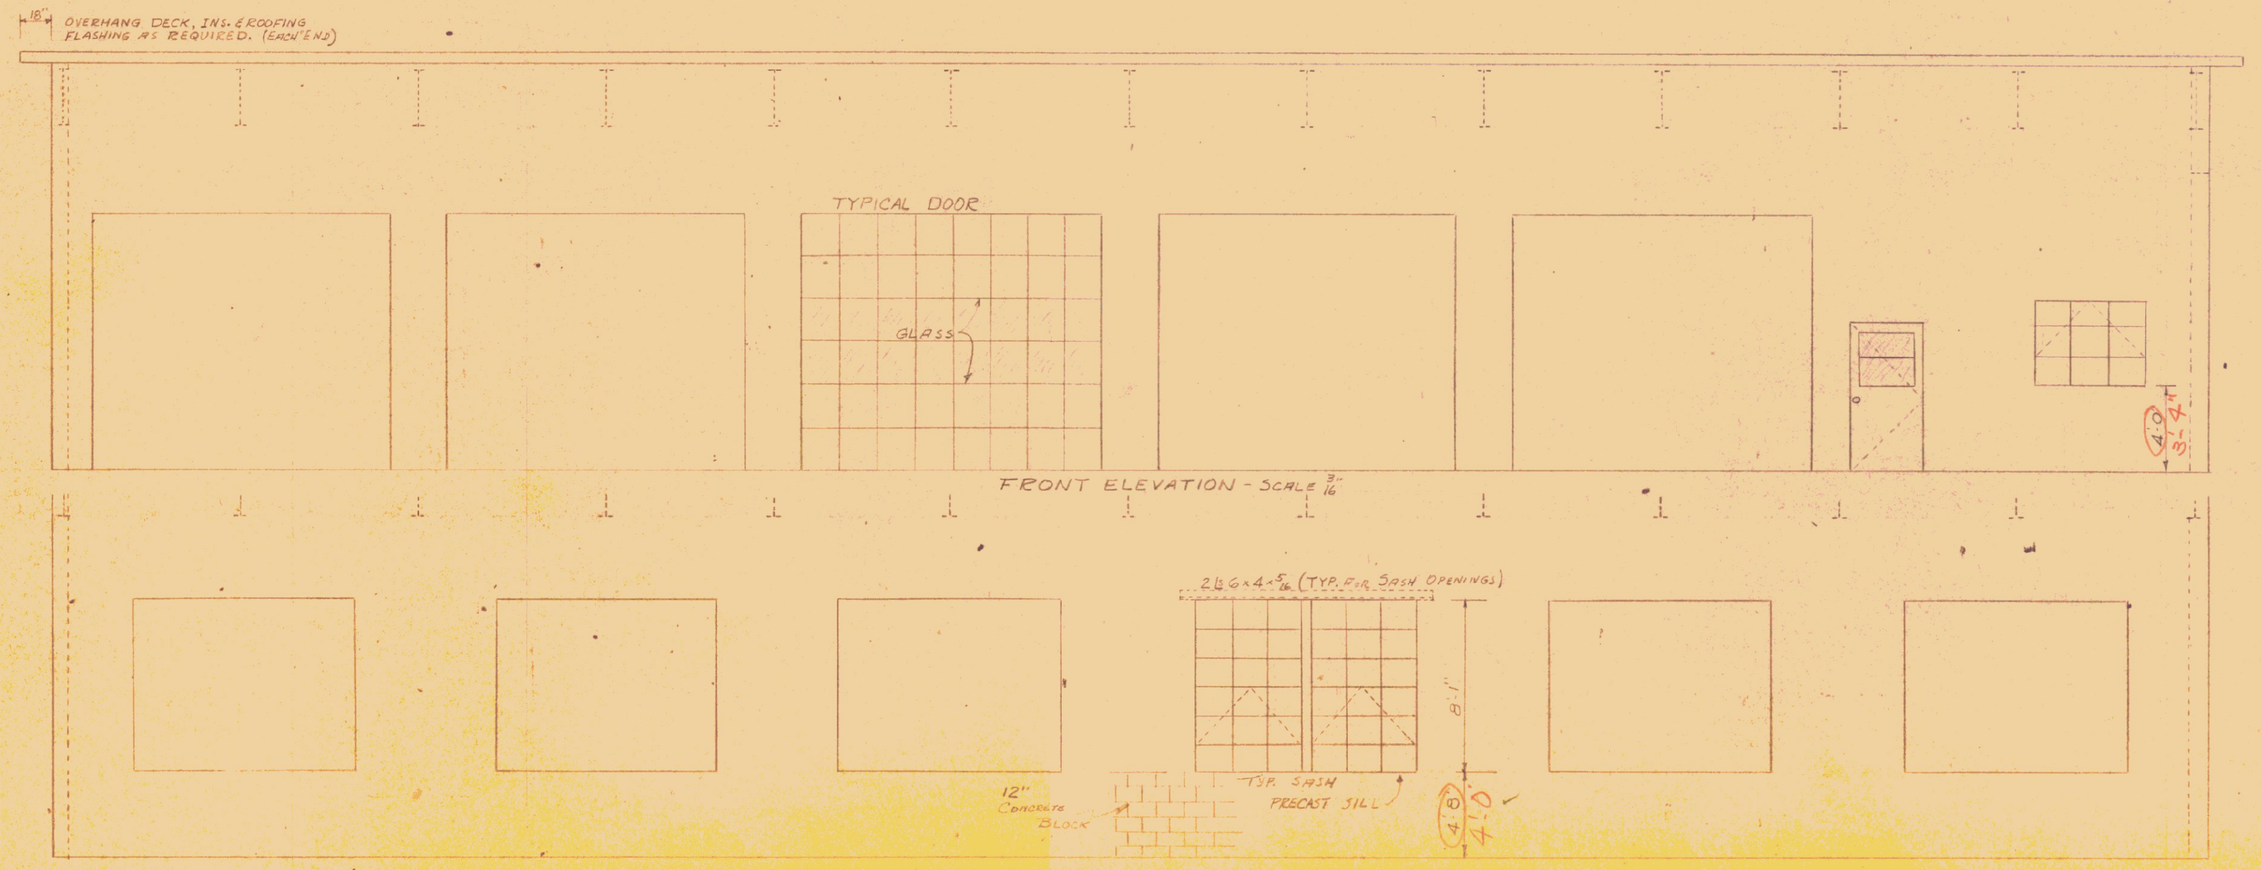

FRONT ELEVATION - SCALE 3/16"

REAR ELEVATION - SCALE 3/16"

SHOP DRAWINGS ARE TO BE SUBMITTED FOR APPROVAL BEFORE FABRICATION IS BEGUN

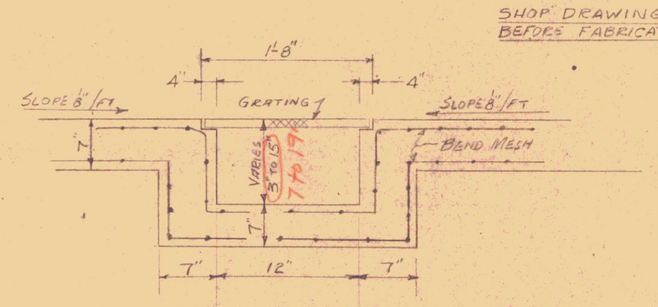

SECTION A-A
SCALE 3/4"

STATE OF VERMONT
HIGHWAY DEPARTMENT

GARAGE FOR DISTRICT NO. 9
U.S. ROUTE 2
MIDDLESEX

DESIGN BY: E.C.NAZCO
OCTOBER 1955

SH. 2