


North →

← TO PLAINFIELD RT 214 TO NORTH MONTPELIER →

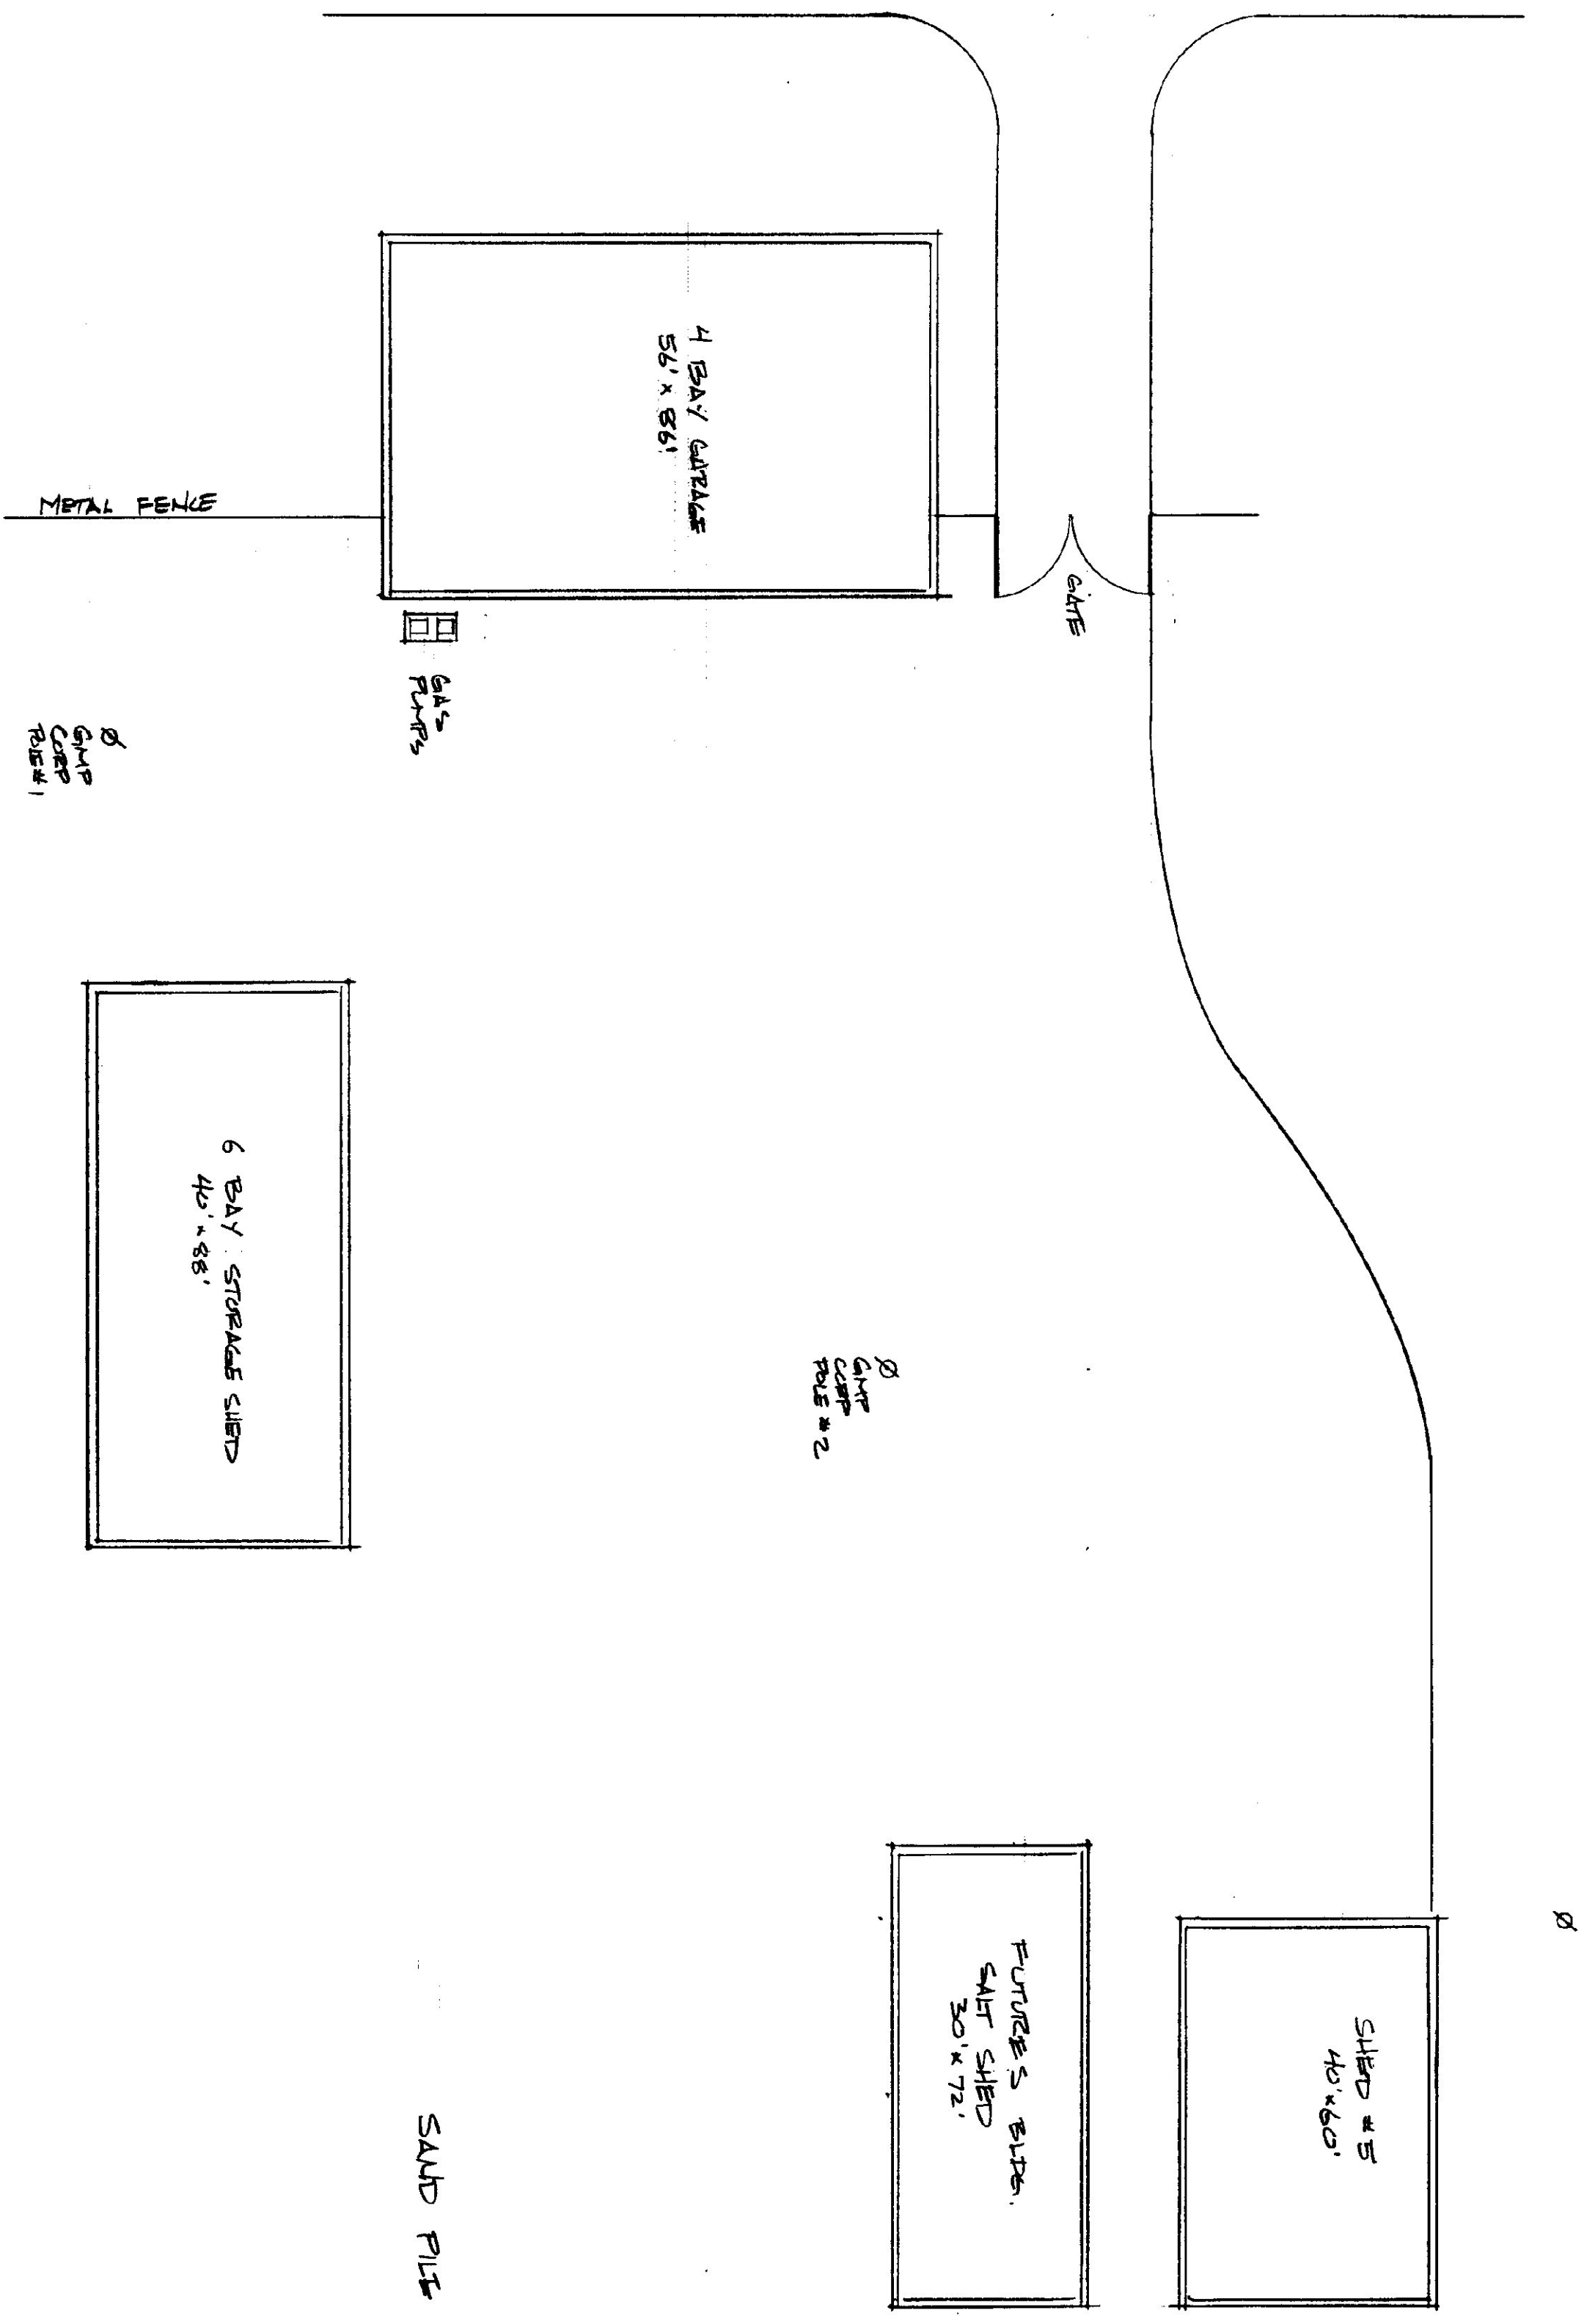

SITE PLAN
 1" = 20'
 DISTANCES ARE APPROXIMATE - MEASURED W/ CLOTH TAPE

STATE OF VERMONT			
DIVISION OF STATE BUILDINGS			
AGENCY OF ADMINISTRATION			
MONTPELIER, VERMONT			
AGENCY OF TRANSPORTATION			
HIGHLAND GARAGE SITE			
NORTH MONTPELIER, VERMONT			
DATE:	SCALE:	REVISIONS:	DWG. NO.
DEC. 1985	1" = 20'		
DRAWN BY:	APPROVED BY:		OF
SR			