


#1 LIONEL & ROSANNA REMILARD
 to WENDEL & RITA HART
 BK 20 P 234 0.9 Acres
 GRANTEE BARRETRUST Co.

#2 RAYMOND P CAMAIRE
 BOX 66 BARRE, Vt.
 BK P 456 4.1 Acres

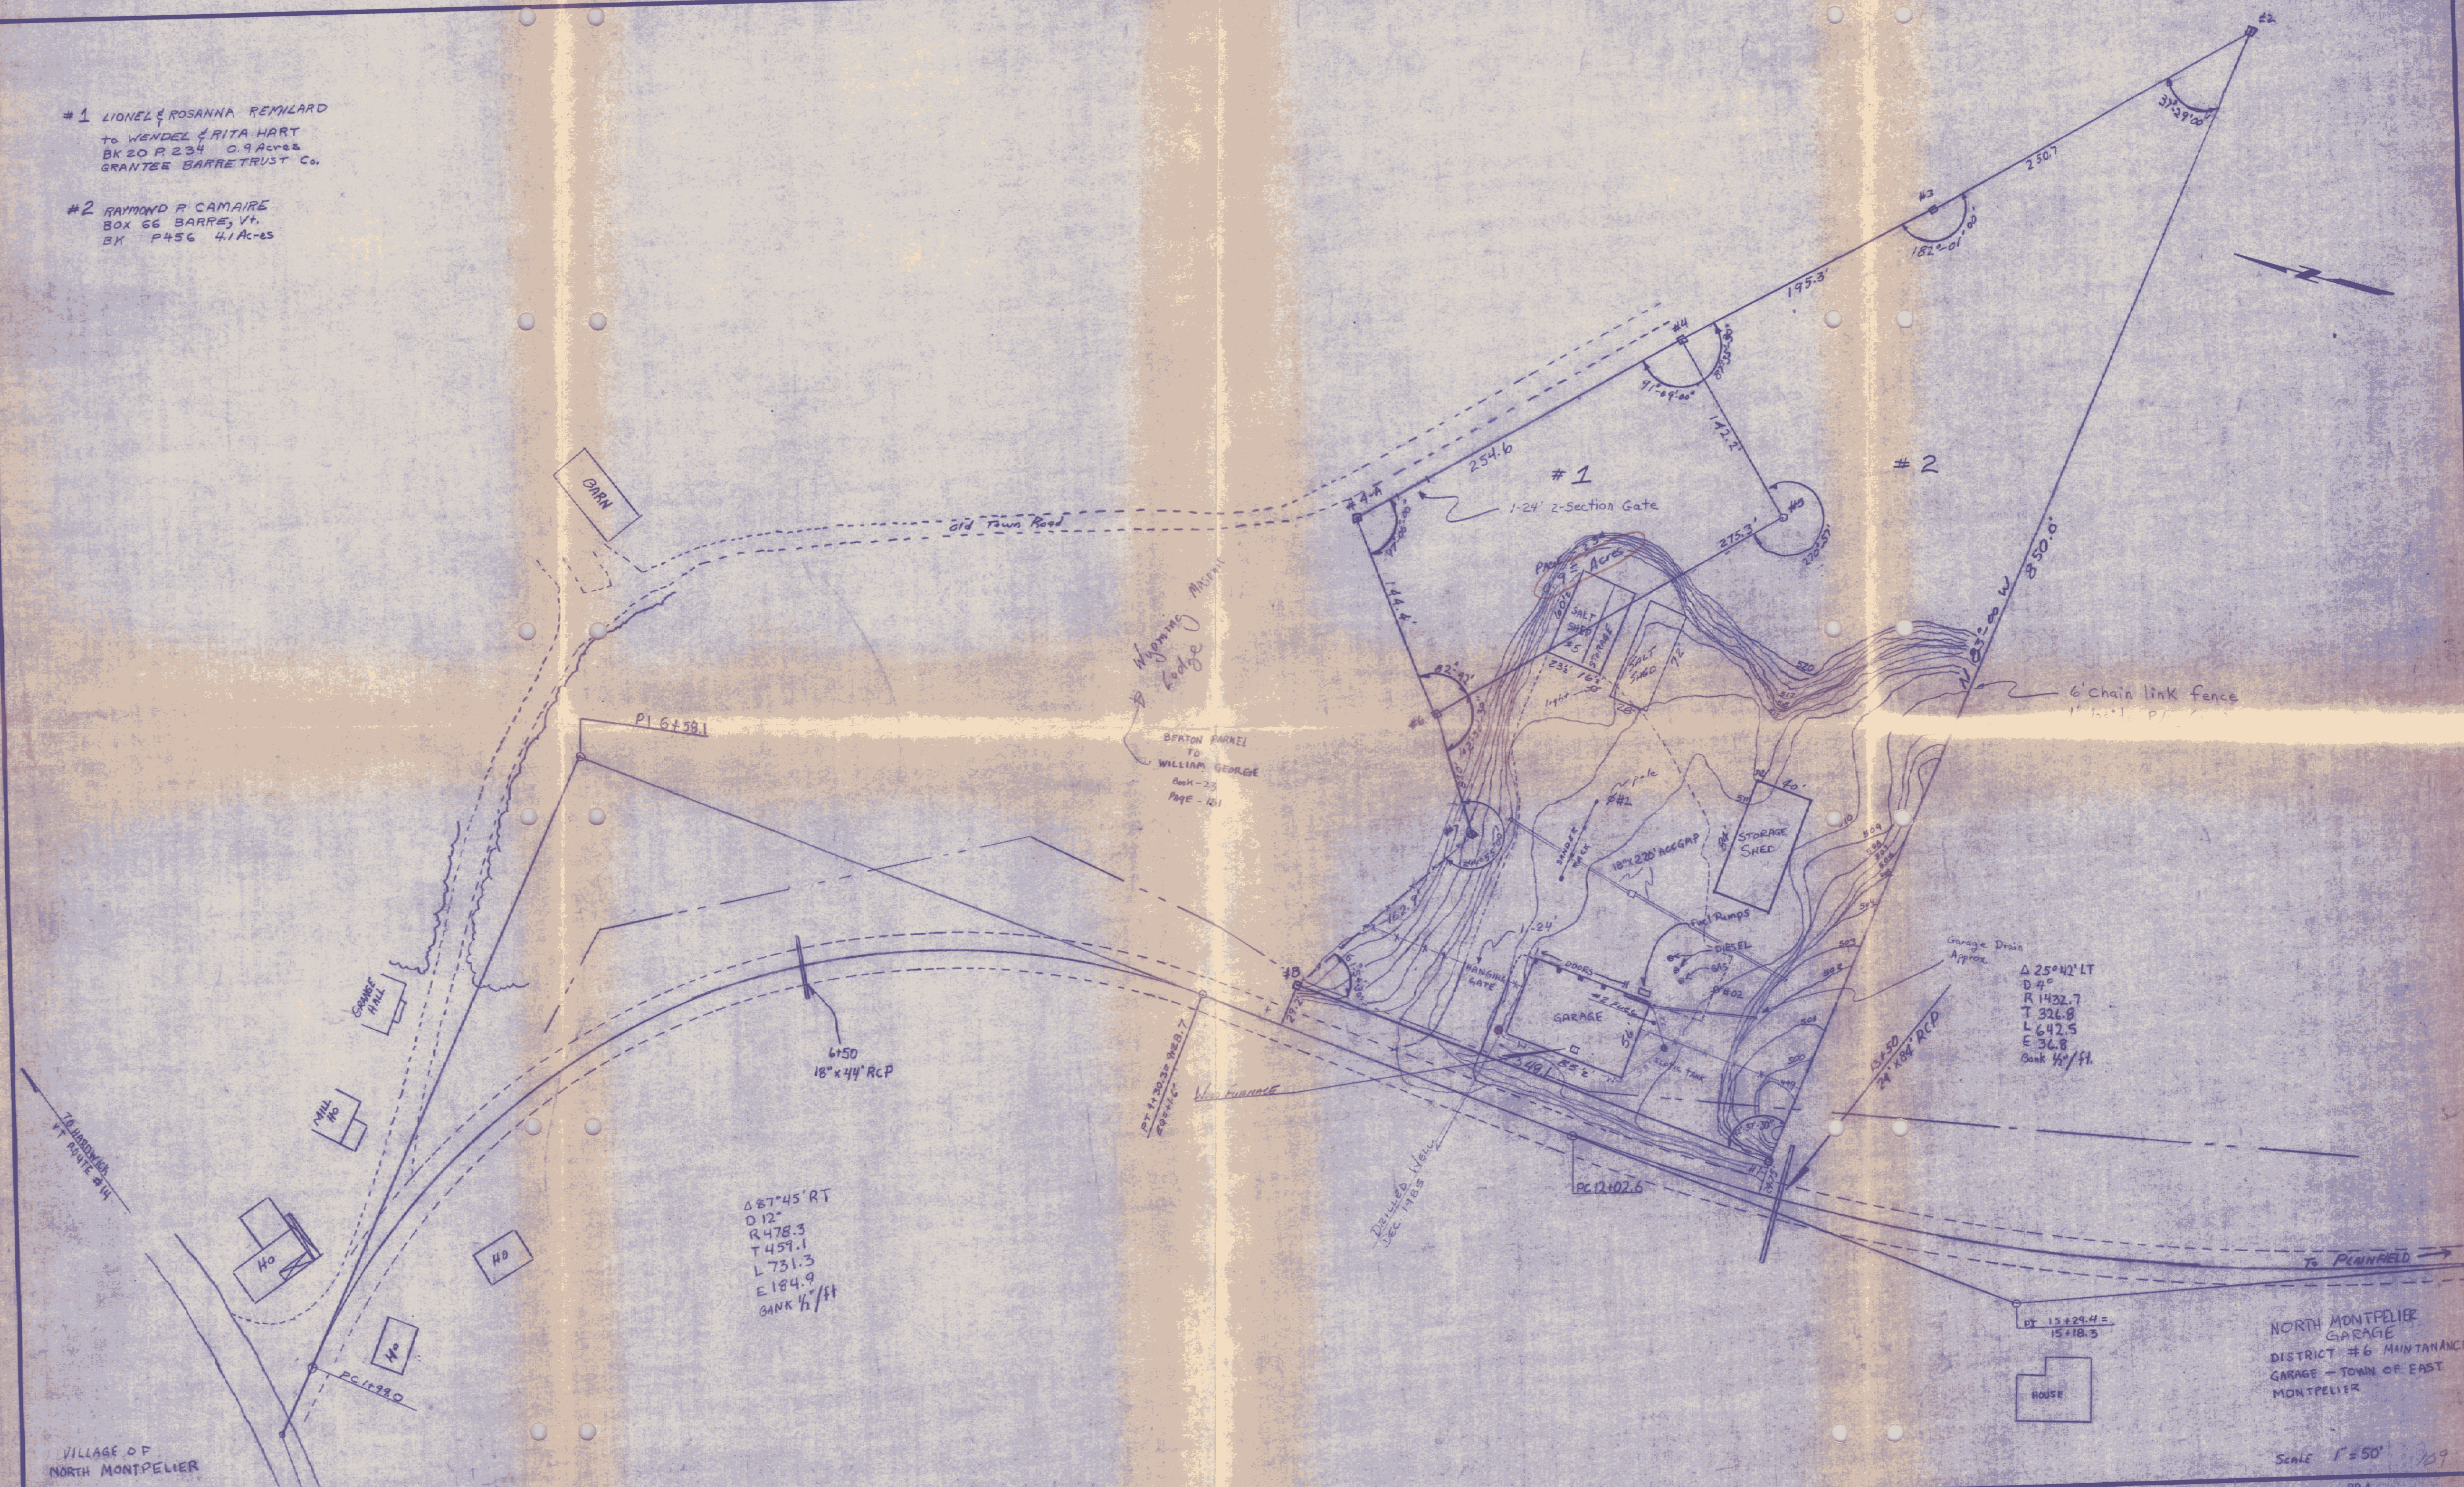

BERTON PARCEL
 TO
 WILLIAM GEORGE
 Book-25
 Page-101

Garage Drain
 Approx.
 $\Delta 25^{\circ}42' LT$
 $R 1432.7$
 $T 326.8$
 $L 642.5$
 $E 36.8$
 Bank $\frac{1}{2}$ "/ft.

$\Delta 87^{\circ}45' RT$
 $D 12$
 $R 478.3$
 $T 459.1$
 $L 731.3$
 $E 184.9$
 Bank $\frac{1}{2}$ "/ft

NORTH MONTPELIER
 GARAGE
 DISTRICT #6 MAINTANANCE
 GARAGE - TOWN OF EAST
 MONTPELIER

Scale 1" = 50'