


**ELECTRICAL FLOOR PLAN**  
SCALE: 3/16" = 1'-0"

- NOTES**
- 1. SWITCHES: "TECU" 90-TEC-2-40'S (MOUNT ON BOT OF JOIST)
  - 2. WRESTING-OUTLET: 1-TUBE, RS STRIP 5 STRONG (MOUNT ON BOT OF JOIST)
  - 3. SWITCHES: CONTINUED TO DIMA-2-40 SURFACE MOUNT TO CEILING
  - 4. CONDUIT TO CIRCUIT "A" & "B" TO SWITCHES, CIR. 4
  - 5. 100 AMP WELDER CUTLET
  - 6. RUN "I" CONDUIT FROM MAIN PANEL THRU MOTOR STARTER TO WALL AT AIR COMPRESSOR.

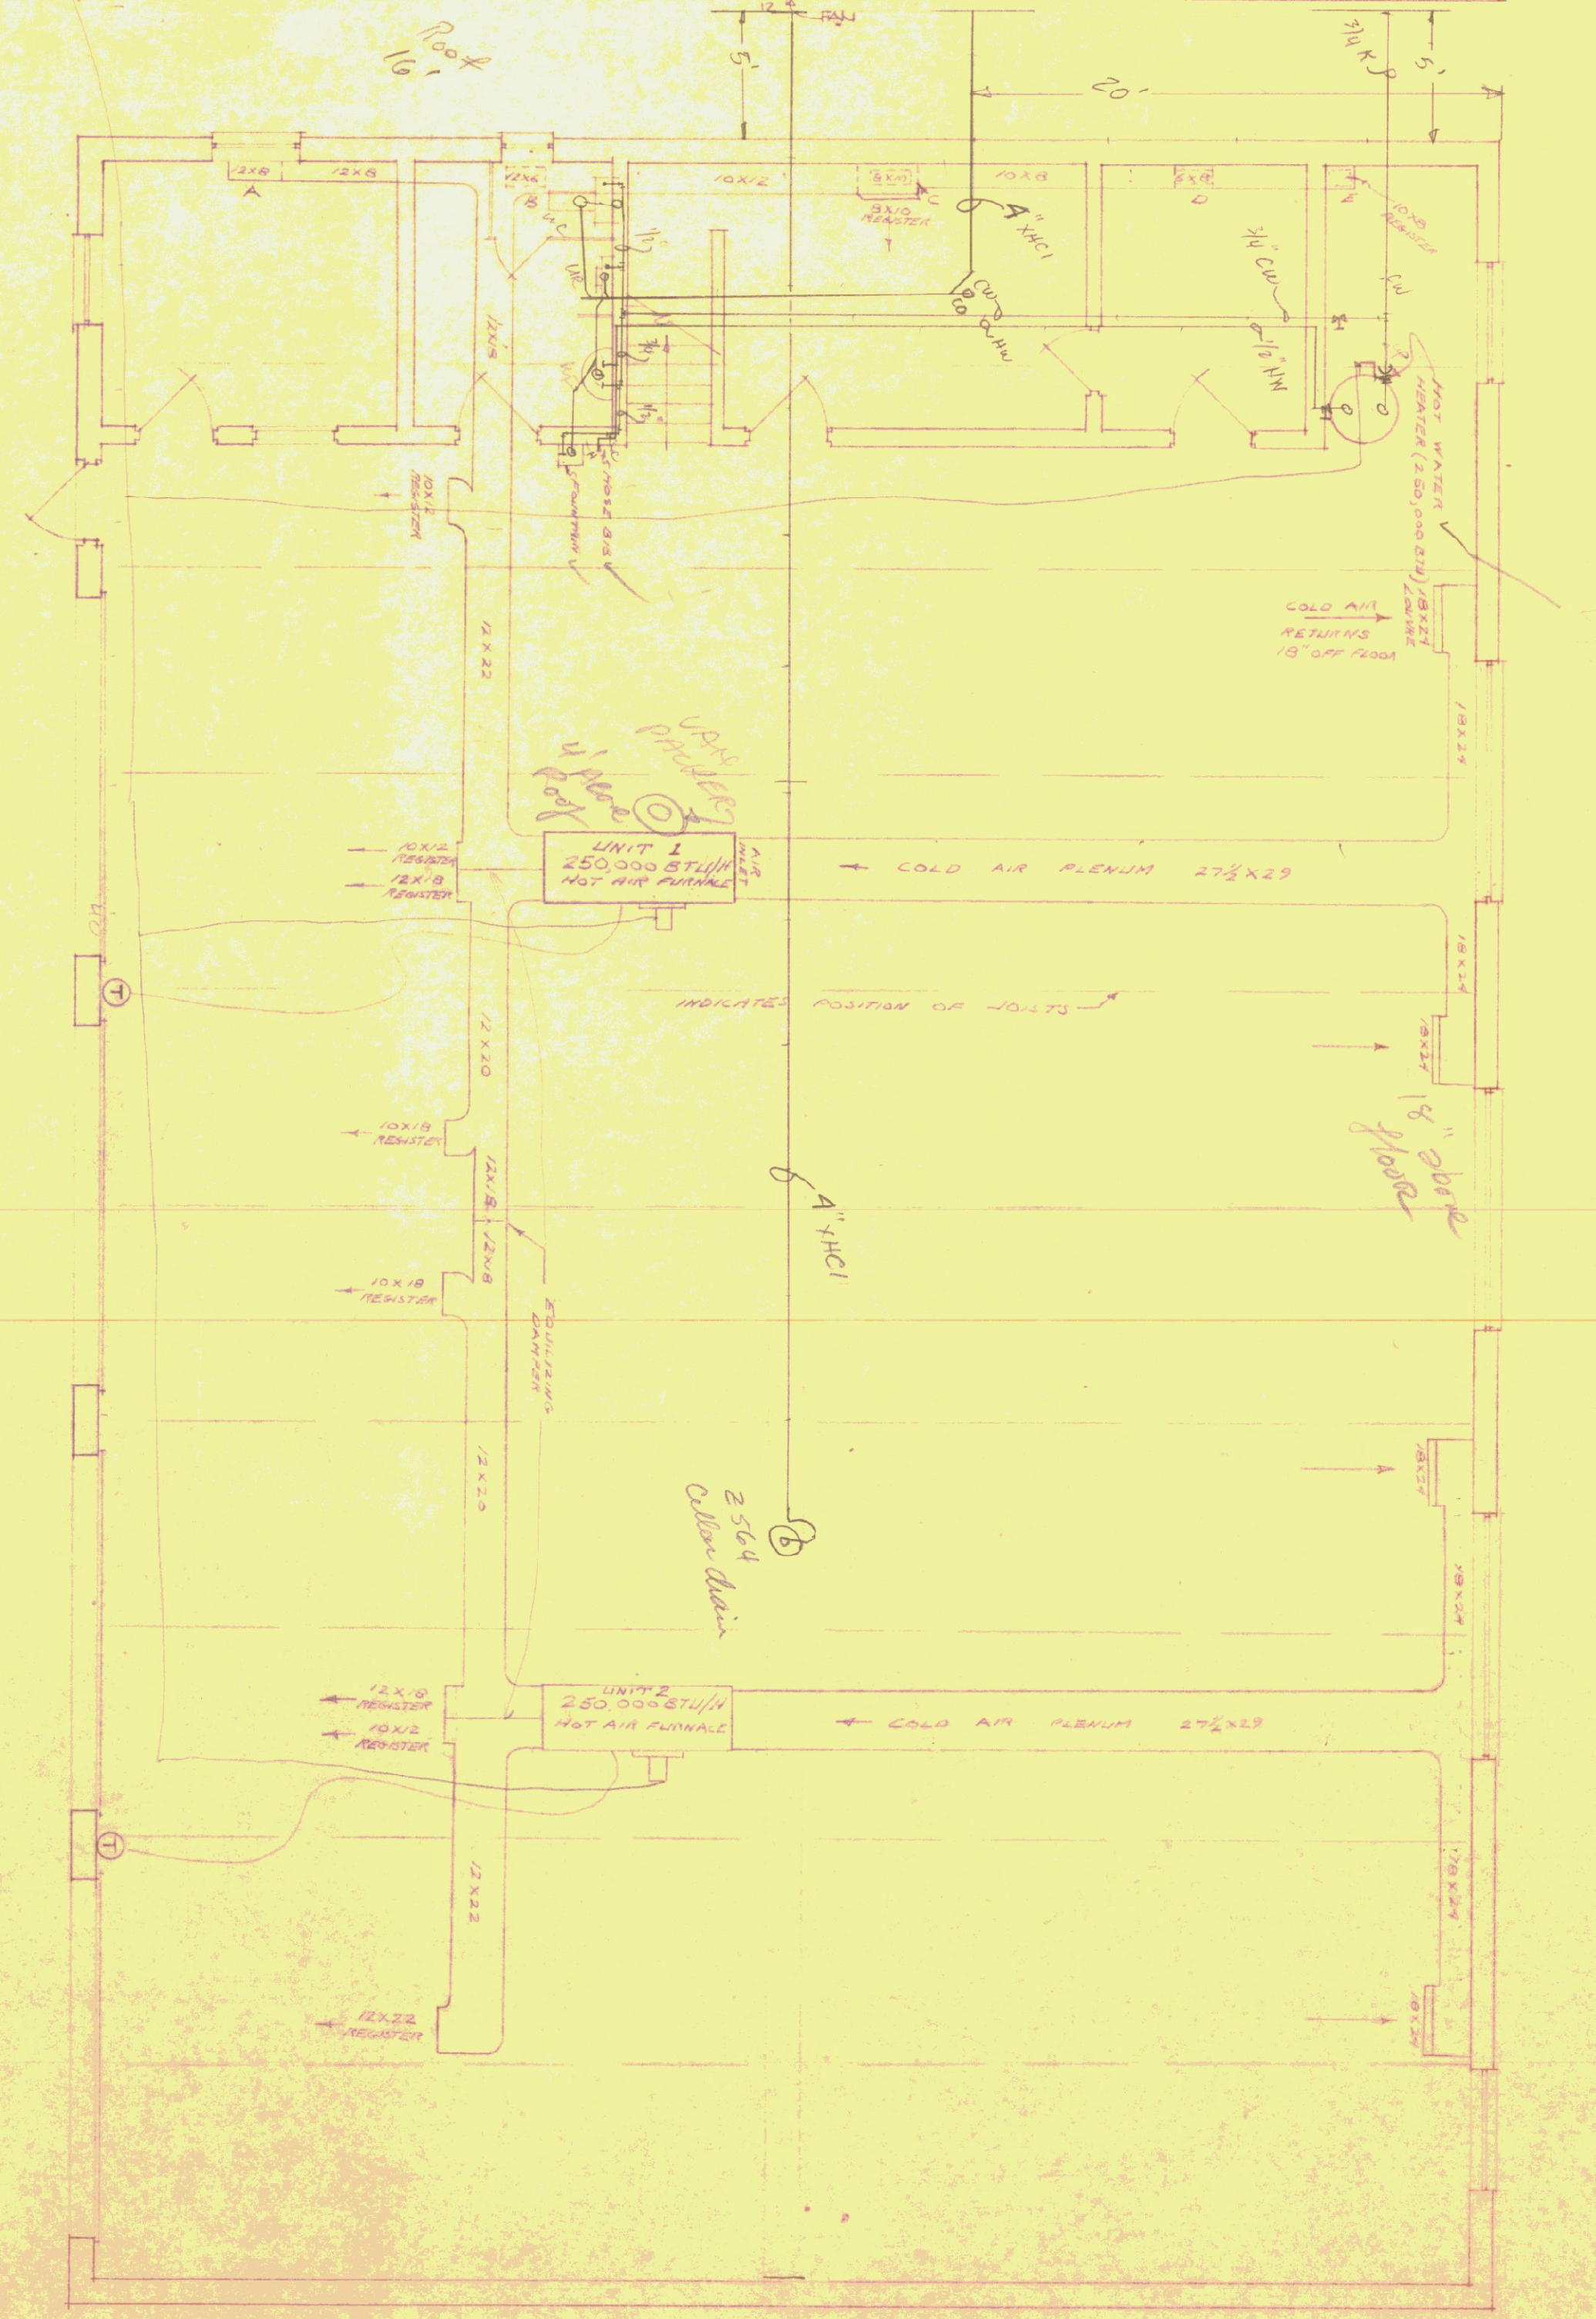

**MECHANICAL FLOOR PLAN**  
SCALE: 3/16" = 1'-0"

- NOTES**
- 1. A, B, C, UY, UZ, VA, ZZ.

STANDARD GARAGE BUILDING FOR  
VERMONT DEPARTMENT OF HIGHWAYS  
NO. 1 - NORTH MONT PELIER

DATE: MAR 27, 1946  
STATE BUILDINGS DIVISION  
DEPT. OF ADMINISTRATION  
MONTPELIER, VERMONT

DRAWING NO. 1-4