

VERMONT STATE BUILDINGS DIVISION
MONTPELIER, VERMONT

JOB: This is an exposed structural member & must be finished as such. All welds to be ground smooth. All paint to be free from drips, runs & sags.

APPROVED
 APPROVED AS CORRECTED
 NOT APPROVED
 REVISE AND RE-APPROVE



Shop drawings approved in general and approved for intent of contract with the design engineer's approval. Approval shall not relieve Contractor of responsibility for intent of contract documents, for accuracy, dimensioning, quantity, etc.

BY: *[Signature]*
DATE: 11/19/67

NO.	QUANTITY	DESCRIPTION	MARK	WEIGHT
8	BR3	7/8" 1 1/2" x 1 1/2" x 8'	DO	7 11/8' RES @ 20.0
8	BR4	7/8" 1 1/2" x 1 1/2" x 8'	DO	7 11/8' RES @ 20.0

BILL OF MATERIAL

PROJECT: VERMONT HIGHWAY GARAGE
 LOCATION: MORRISVILLE, VT
 CUSTOMER: TRAHAN CONST. CO.
 ARCHITECT: VT DEPT. OF HIGHWAYS STATE BLDG DIV.
 SHEET NO. 12

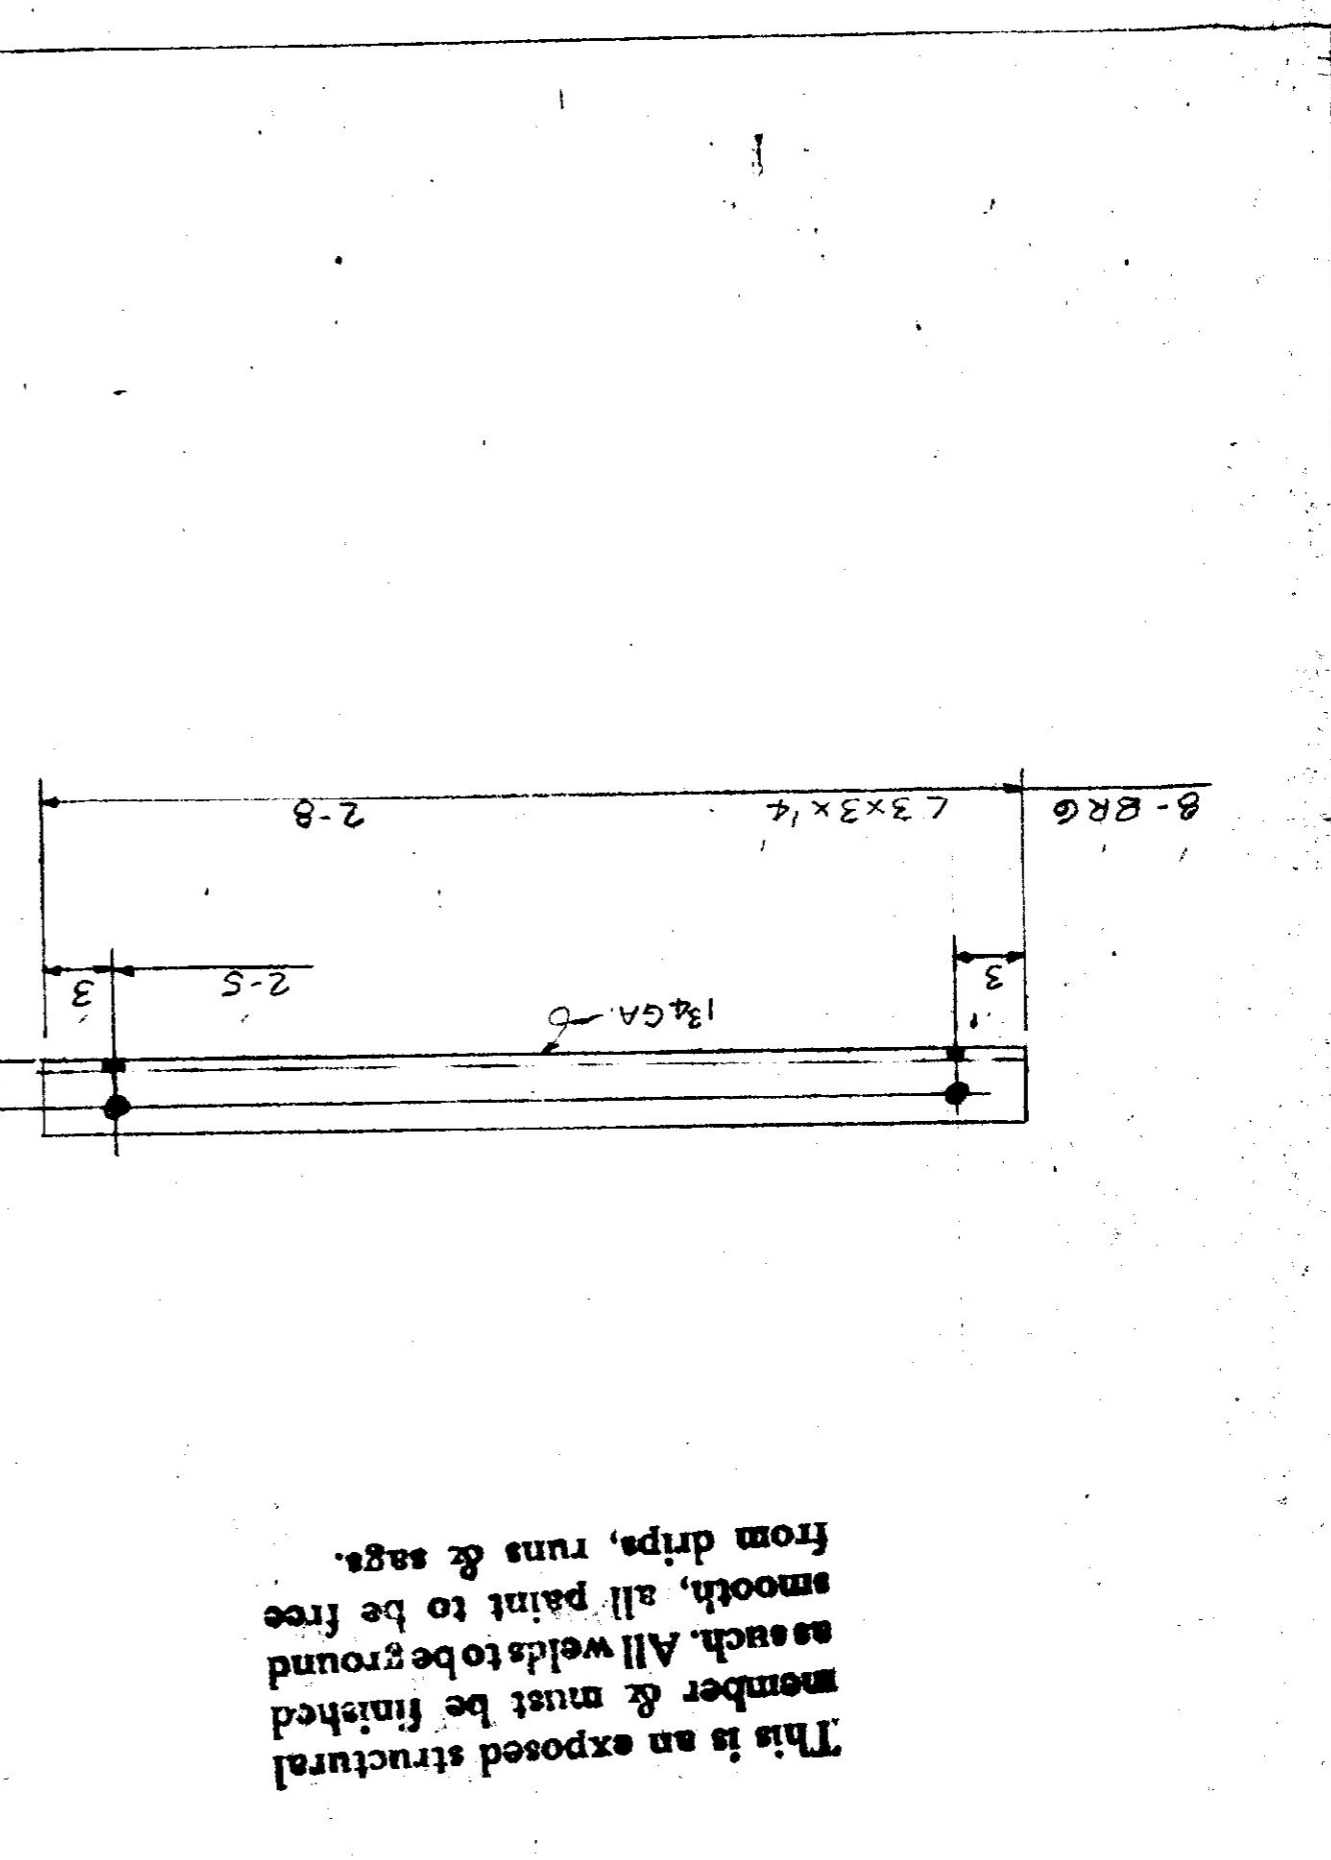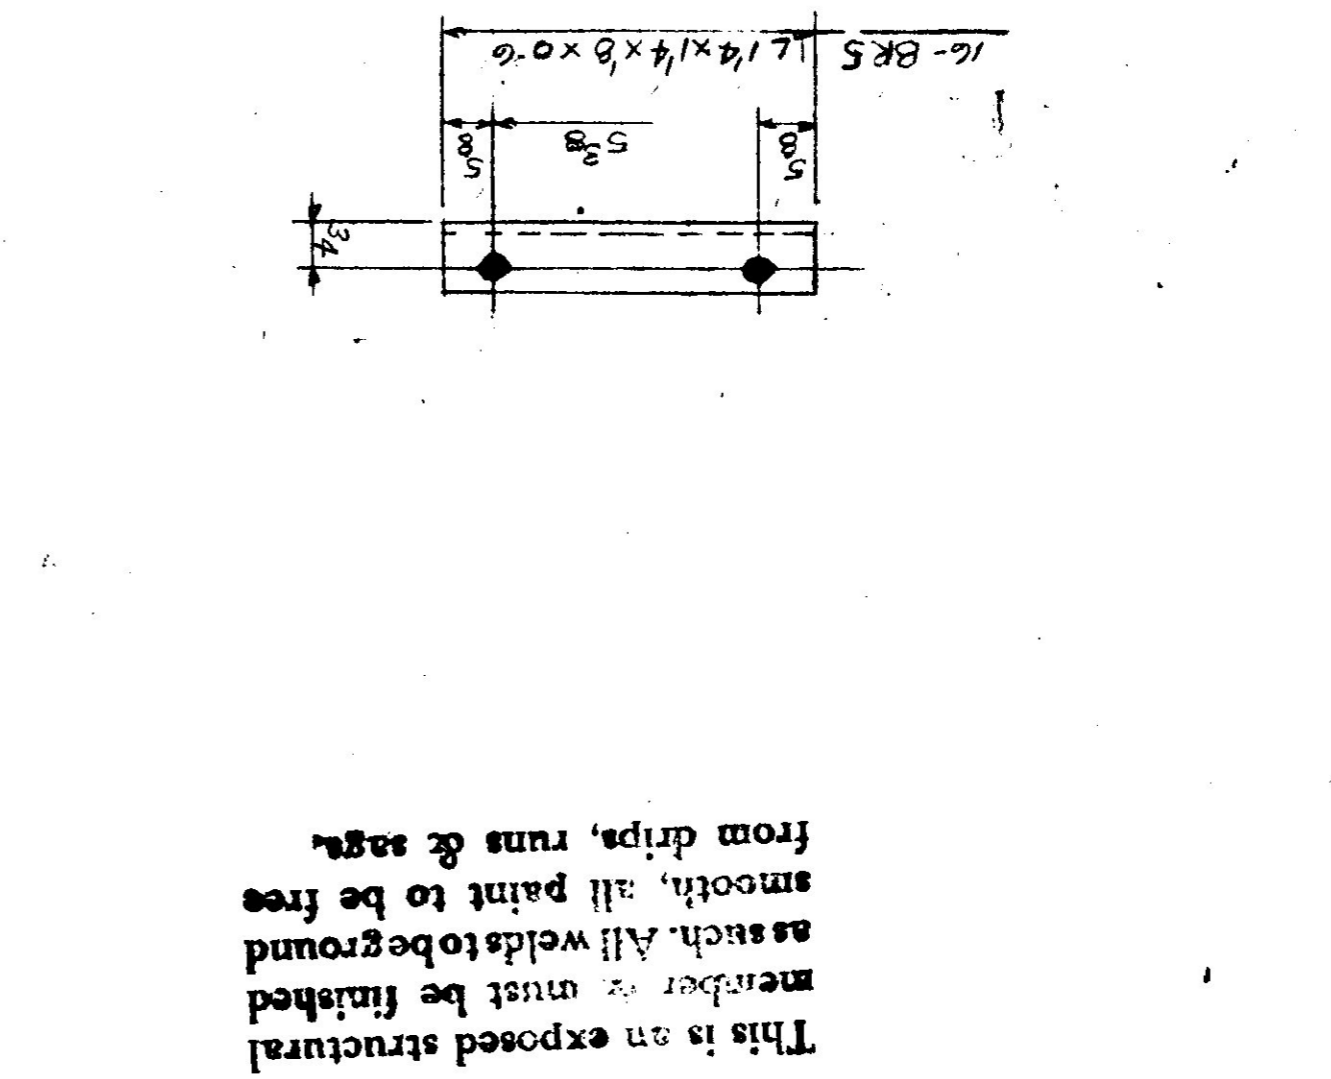

NO.	QUANTITY	DESCRIPTION	MARK	WEIGHT
16	BR5	1 1/2" 1 1/2" x 1 1/2" x 8'	0 @	0 @ STK

BILL OF MATERIAL

PROJECT: VT. HIGHWAY GARAGE
 LOCATION: MORRISVILLE, VT
 CUSTOMER: TRAHAN CONST. CO.
 ARCHITECT: VT DEPT. OF HIGHWAYS STATE BLDG DIV.
 SHEET NO. 14

NO.	QUANTITY	DESCRIPTION	MARK	WEIGHT
8	BR6	3/8" 1 1/2" x 3" x 12'	2 8	2 8 STK
310		3/8" BOLTS	0 1	0 1 STK
310		3/8" WASH		
16		3/8" LAGS & SHIELDS	0 4	0 4

BILL OF MATERIAL

PROJECT: VT. HIGHWAY GARAGE
 LOCATION: MORRISVILLE, VT
 CUSTOMER: TRAHAN CONST. CO.
 ARCHITECT: VT DEPT. OF HIGHWAYS STATE BLDG DIV.
 SHEET NO. 15