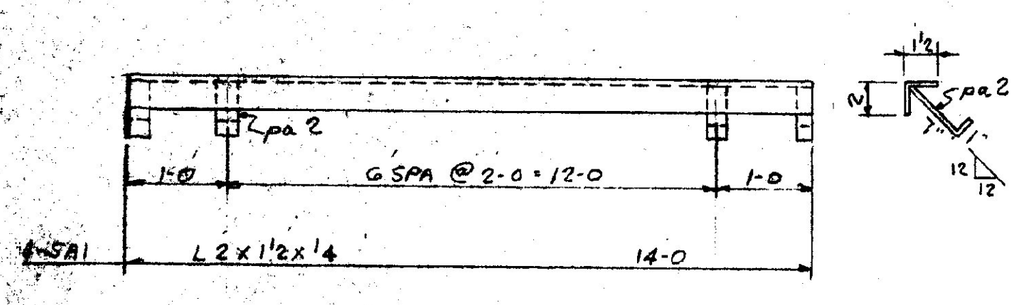

This is an exposed structural member & must be finished as such. All welds to be ground smooth, all paint to be free from drips, runs & sags.

BILL OF MATERIAL — WELDED CONST.

NO. PIECES	MARK	DESCRIPTION	LENGTH FT.	LENGTH IN.		WEIGHT
4	SA1	L 2 x 1½ x ¼	14	0	RES @ 20-0	
36	pa2	BAR 1 x ¼	0	8		

VERMONT STRUCTURAL STEEL CORPORATION
BURLINGTON, VERMONT

		DATE
DRAWN BY	Zack	10-23-67
CK'D BY	K.T.	10-24-67

HOLES NONE
BOLTS
PAINT RUSTOLEUM #960

PROJECT VT. HIGHWAY GARAGE
LOCATION MORRISVILLE, VT.
CUSTOMER TRAHAN CONST. CO.
ARCHITECT VT. DEPT OF HIGHWAYS STATE BLDG. DIV.
JOB NO. 67-1426 SHEET NO. 2

PRINT RECORD NO.	FOR	DATE
4	APP	10-30

SM 6-65 OCP

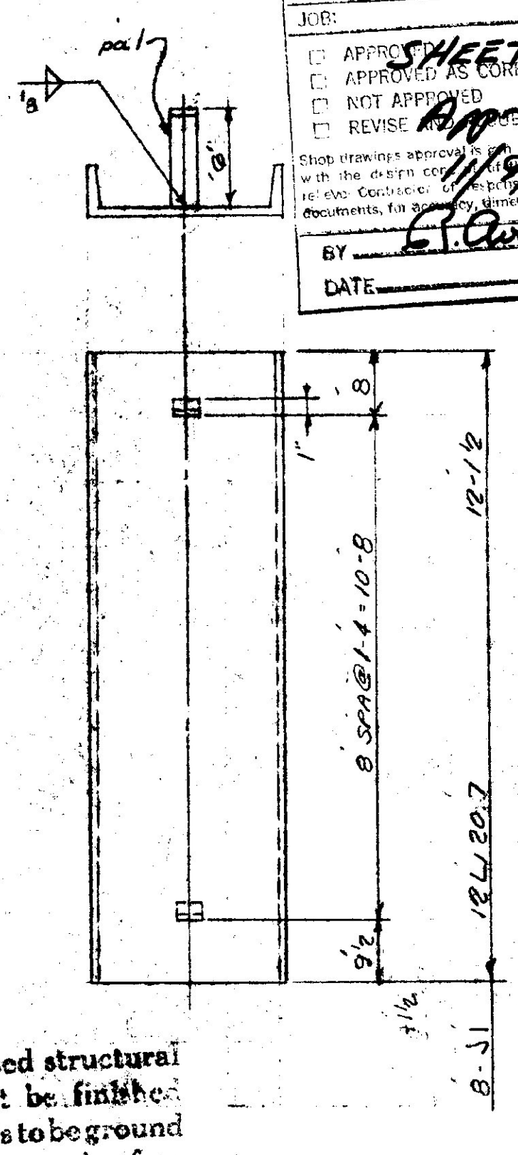

VERMONT STATE BUILDINGS DIVISION
MONTPELIER, VERMONT
JOB:
☐ APPROVED
☐ APPROVED AS CORRECTED SHEETS 1-6
☐ NOT APPROVED
☐ REVISE AND RESUBMIT
Shop drawings approval is given for and only for conformance with the design concept of the project. Approval shall not relieve Contractor of responsibility for intent of Contract documents, for accuracy, dimensioning, quantity, etc.
BY G. Avery Hill
DATE 11/9/67

This is an exposed structural member & must be finished as such. All welds to be ground smooth, all paint to be free from drips, runs & sags.

BILL OF MATERIAL

NO. PIECES	MARK	DESCRIPTION	LENGTH FT.	LENGTH IN.		WEIGHT
					SA CUT 2 ENDS	
8	J1	12 J 20.7	12	1½	ORD	
72	pa1	BAR 1½ x 3/16	0	7	STK	

VERMONT STRUCTURAL STEEL CORPORATION
BURLINGTON, VERMONT

		DATE
DRAWN BY	Zack	10-23-67
CK'D BY	K.T.	10-24-67

HOLES NONE
BOLTS
PAINT RUSTOLEUM #960

PROJECT VT. HIGHWAY GARAGE
LOCATION MORRISVILLE, VT.
CUSTOMER TRAHAN CONST. CO.
ARCHITECT VT. DEPT OF HIGHWAYS STATE BLDG. DIV.
JOB NO. 67-1426 SHEET NO. 1

PRINT RECORD NO.	FOR	DATE
4	APP	10-30

SM 6-65 OCP

This is an exposed structural member & must be finished as such. All welds to be ground smooth, all paint to be free from drips, runs & sags.

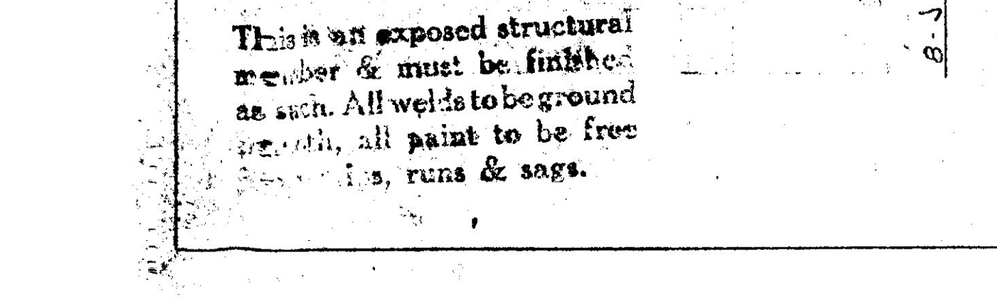

BILL OF MATERIAL

NO. PIECES	MARK	DESCRIPTION	LENGTH FT.	LENGTH IN.		WEIGHT
16	BR2	L 2½ x 2½ x 3/16	8	2¼	RES @ 20-0	

VERMONT STRUCTURAL STEEL CORPORATION
BURLINGTON, VERMONT

		DATE
DRAWN BY	Zack	10-25-67
CK'D BY	K.T.	10-31-67

HOLES 7/16 ϕ
BOLTS
PAINT RUSTOLEUM #960

PROJECT VT. HIGHWAY GARAGE
LOCATION MORRISVILLE, VT.
CUSTOMER TRAHAN CONST. CO.
ARCHITECT VT. DEPT OF HIGHWAYS STATE BLDG. DIV.
JOB NO. 67-1426 SHEET NO. 3

PRINT RECORD NO.	FOR	DATE
4	APP	10/31