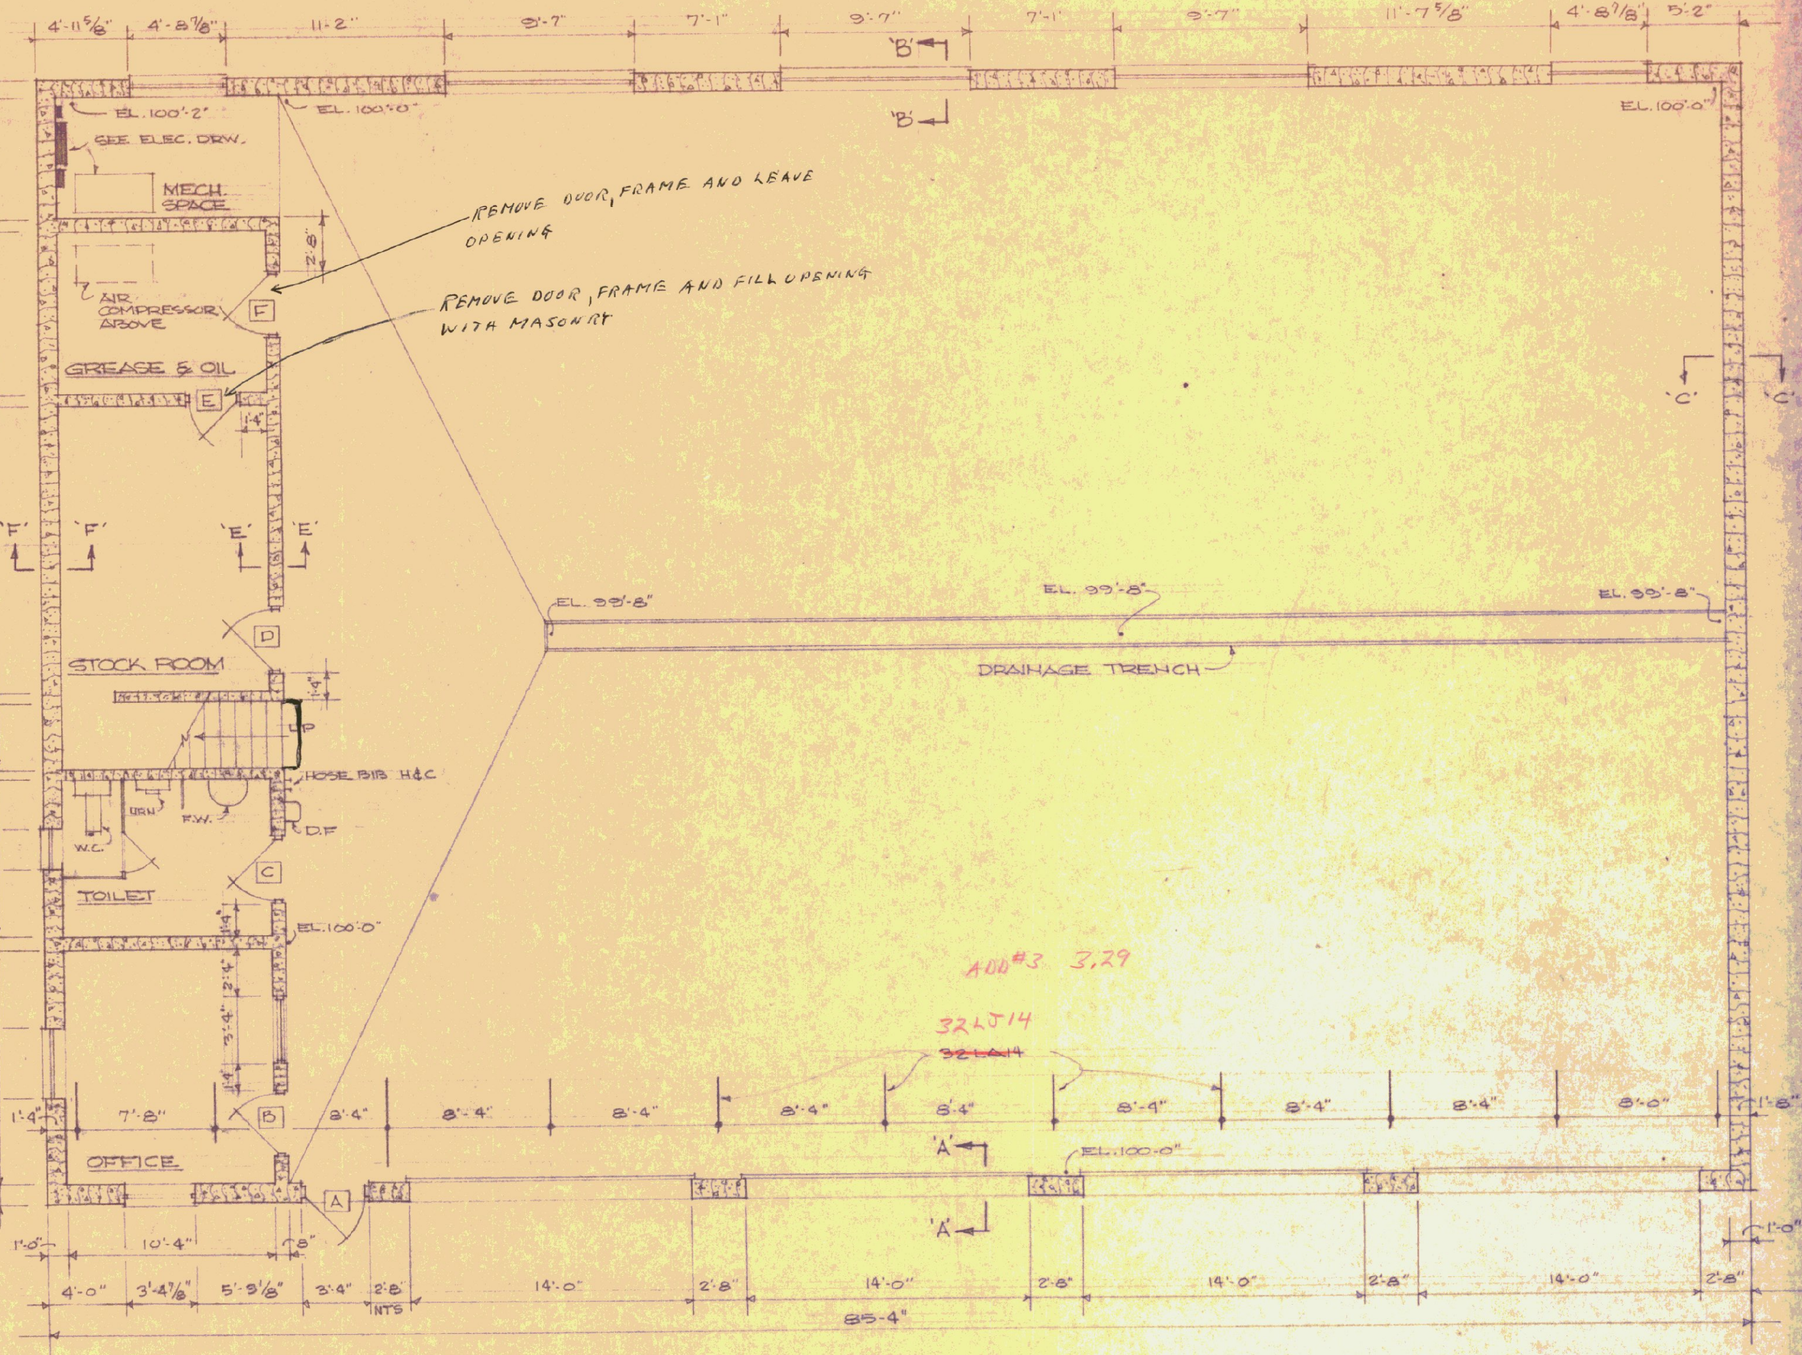

FLOOR PLAN

SCALE: 3/16" = 1'-0"

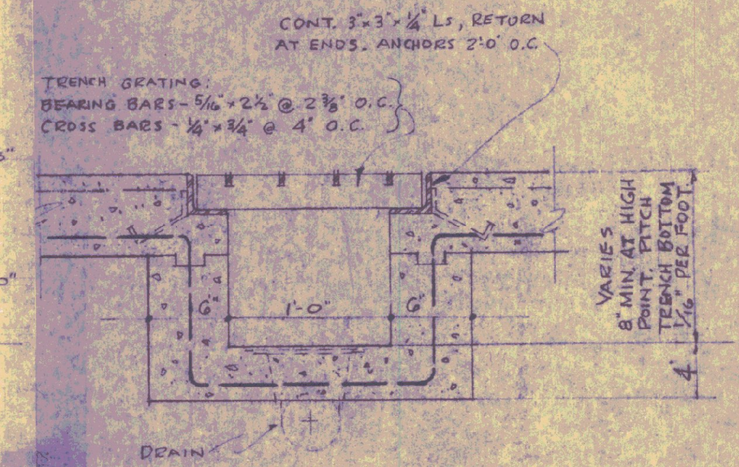

SECTION THRU TRENCH

SCALE 1 1/2" = 1'-0"

DOOR SCHEDULE

TYPE	SIZE	
A	3'-0" x 7'-0" x 1 3/4"	26" x 36" UPPER GLAZED LIGHT
B	3'-0" x 6'-6" x 1 3/4"	26" x 30" UPPER GLAZED LIGHT
C	3'-0" x 6'-6" x 1 3/4"	12" x 24" BOTTOM LOUVER
D	3'-0" x 6'-6" x 1 3/4"	DUTCH DOOR WITH SHELF
E	2'-4" x 6'-10" x 1 3/4"	
F	3'-0" x 6'-6" x 1 3/4"	

NOTES: ALL DOORS AND DOOR FRAMES TO BE HOLLOW METAL. ALL GLASS TO BE 1/4" POL. PL GLASS. FOR FRAME DETAILS SEE ELSEWHERE ON THIS SHEET.

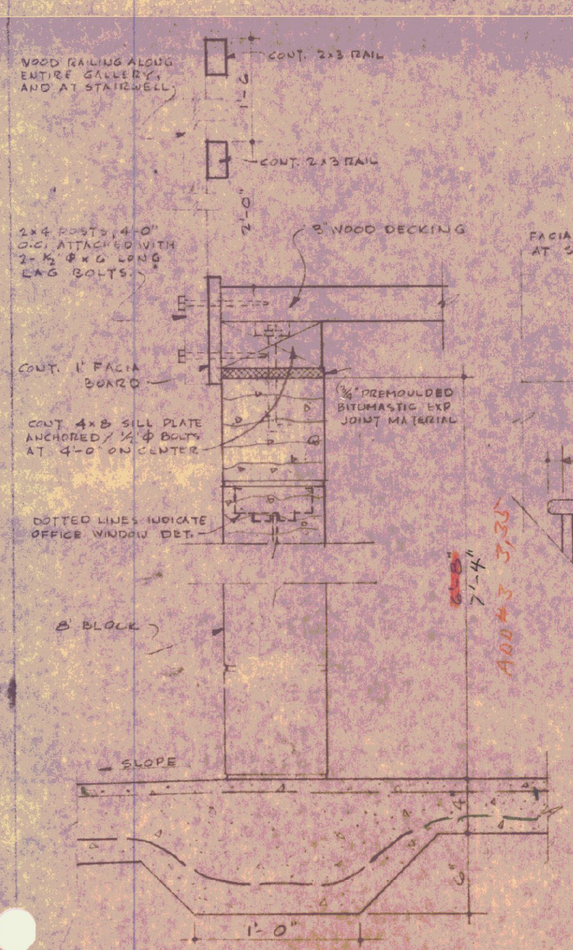

SECTION E

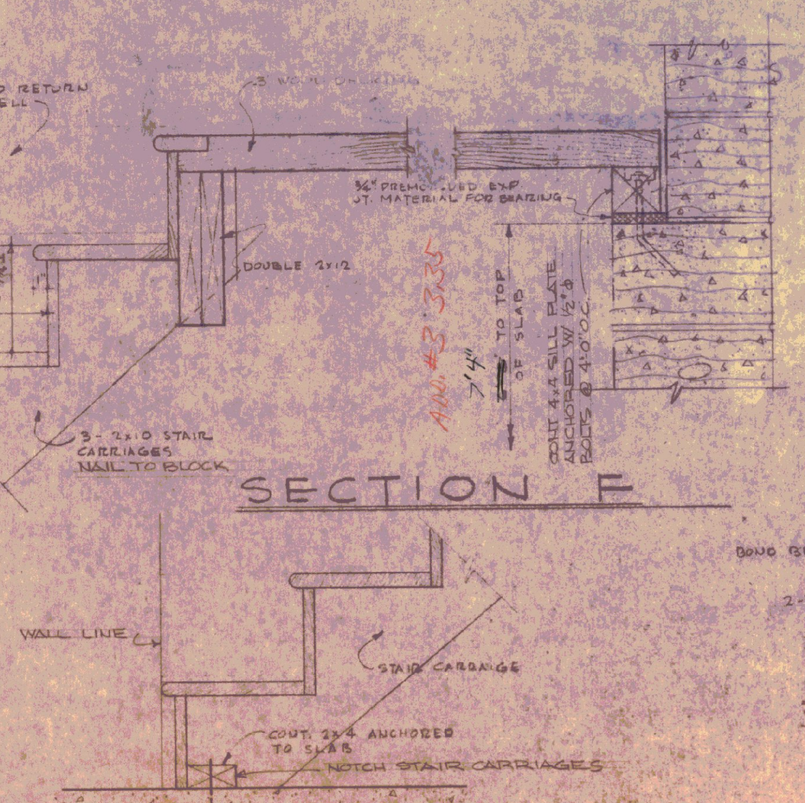

DET. AT BOTTOM OF STAIRS

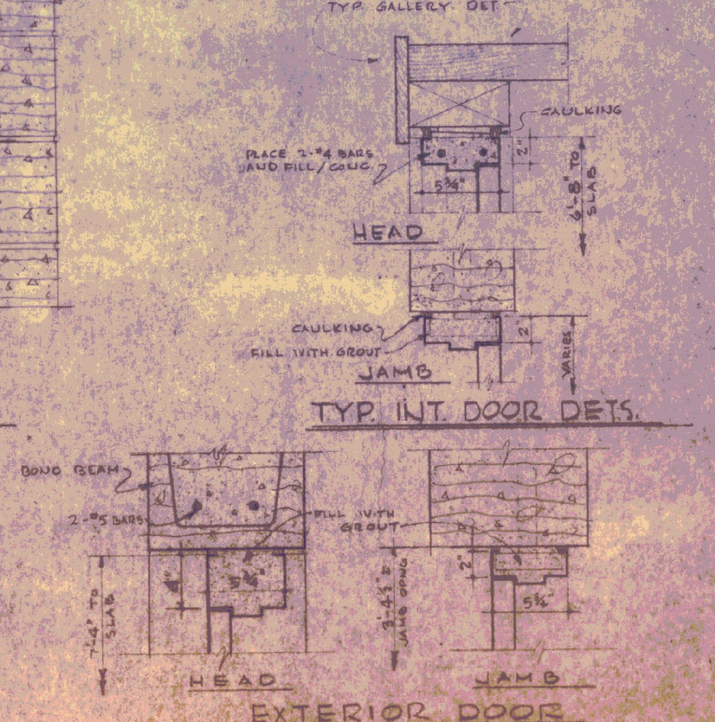

TYP. INT. DOOR DETS.

EXTERIOR DOOR

HOL. MET DOOR FRAME DETS.

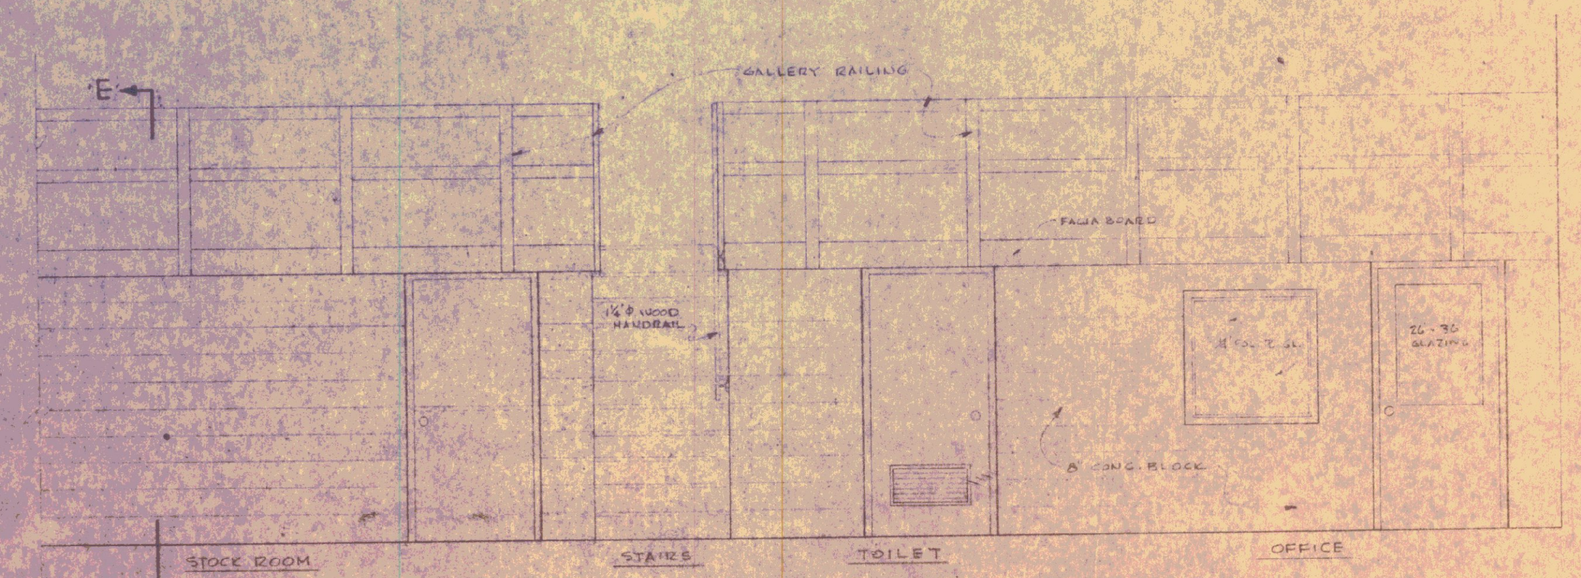

PARTIAL ELEV. LOOKING TOWARDS GALLERY 3/8" = 1'-0"

STANDARD GARAGE BUILDING FOR VERMONT DEPARTMENT OF HIGHWAYS
NO. 1 - NORTH MONTPELIER
[redacted]

DATE MAY 27, 1948

STATE BUILDINGS DIVISION
DEPT. OF ADMINISTRATION
MONTPELIER, VERMONT

DWG. NO. 1-2
[redacted]