
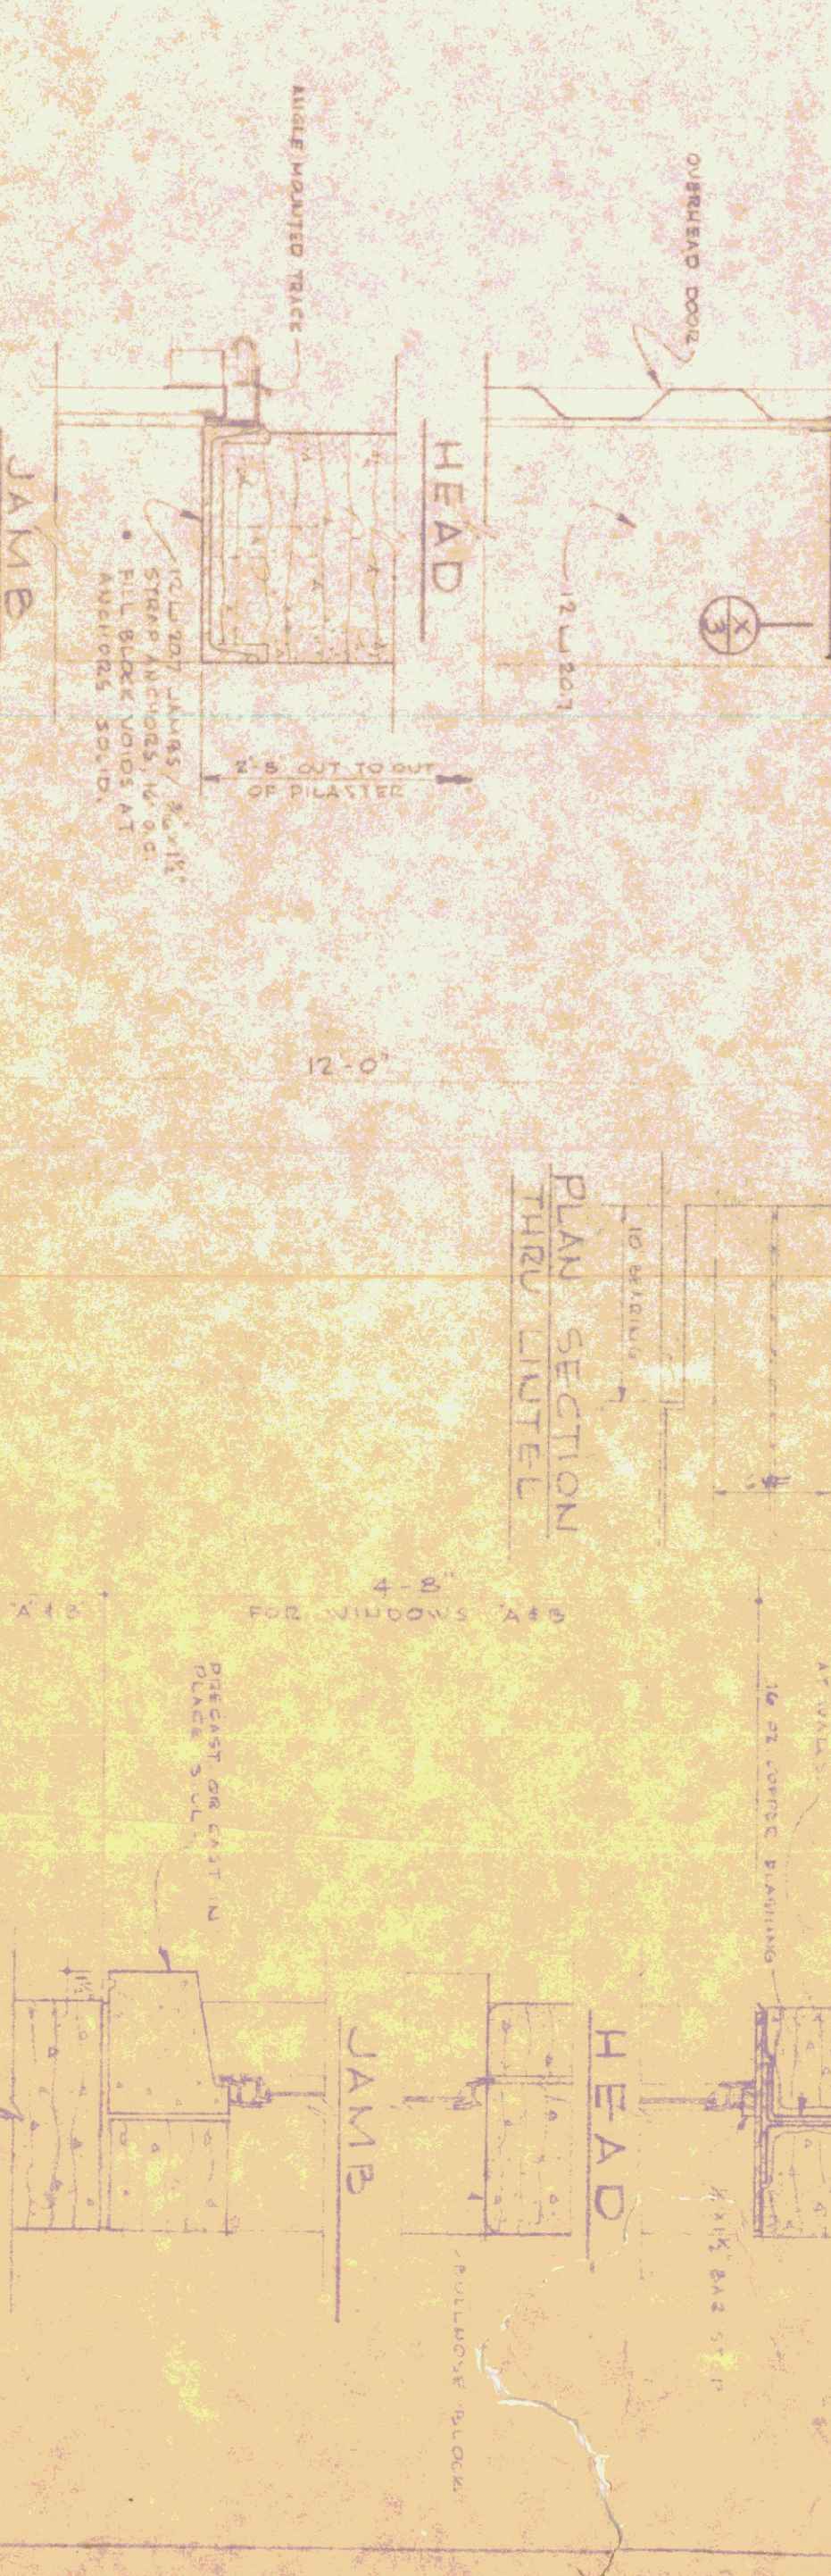
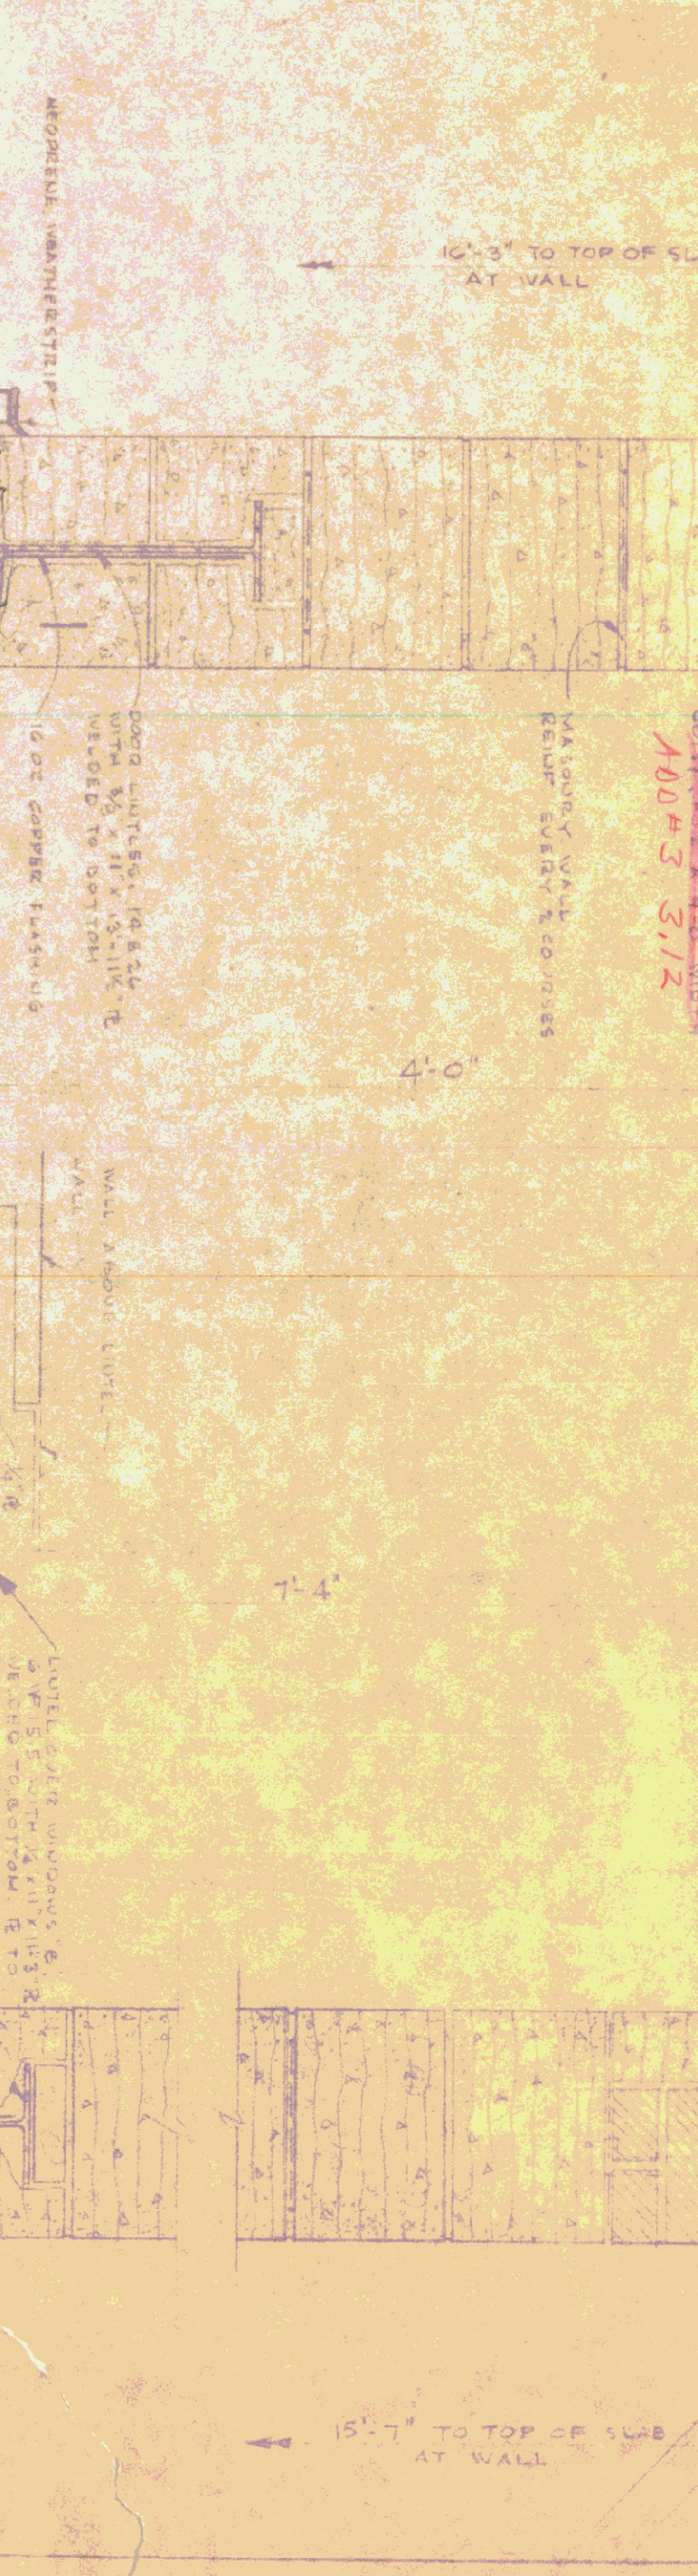
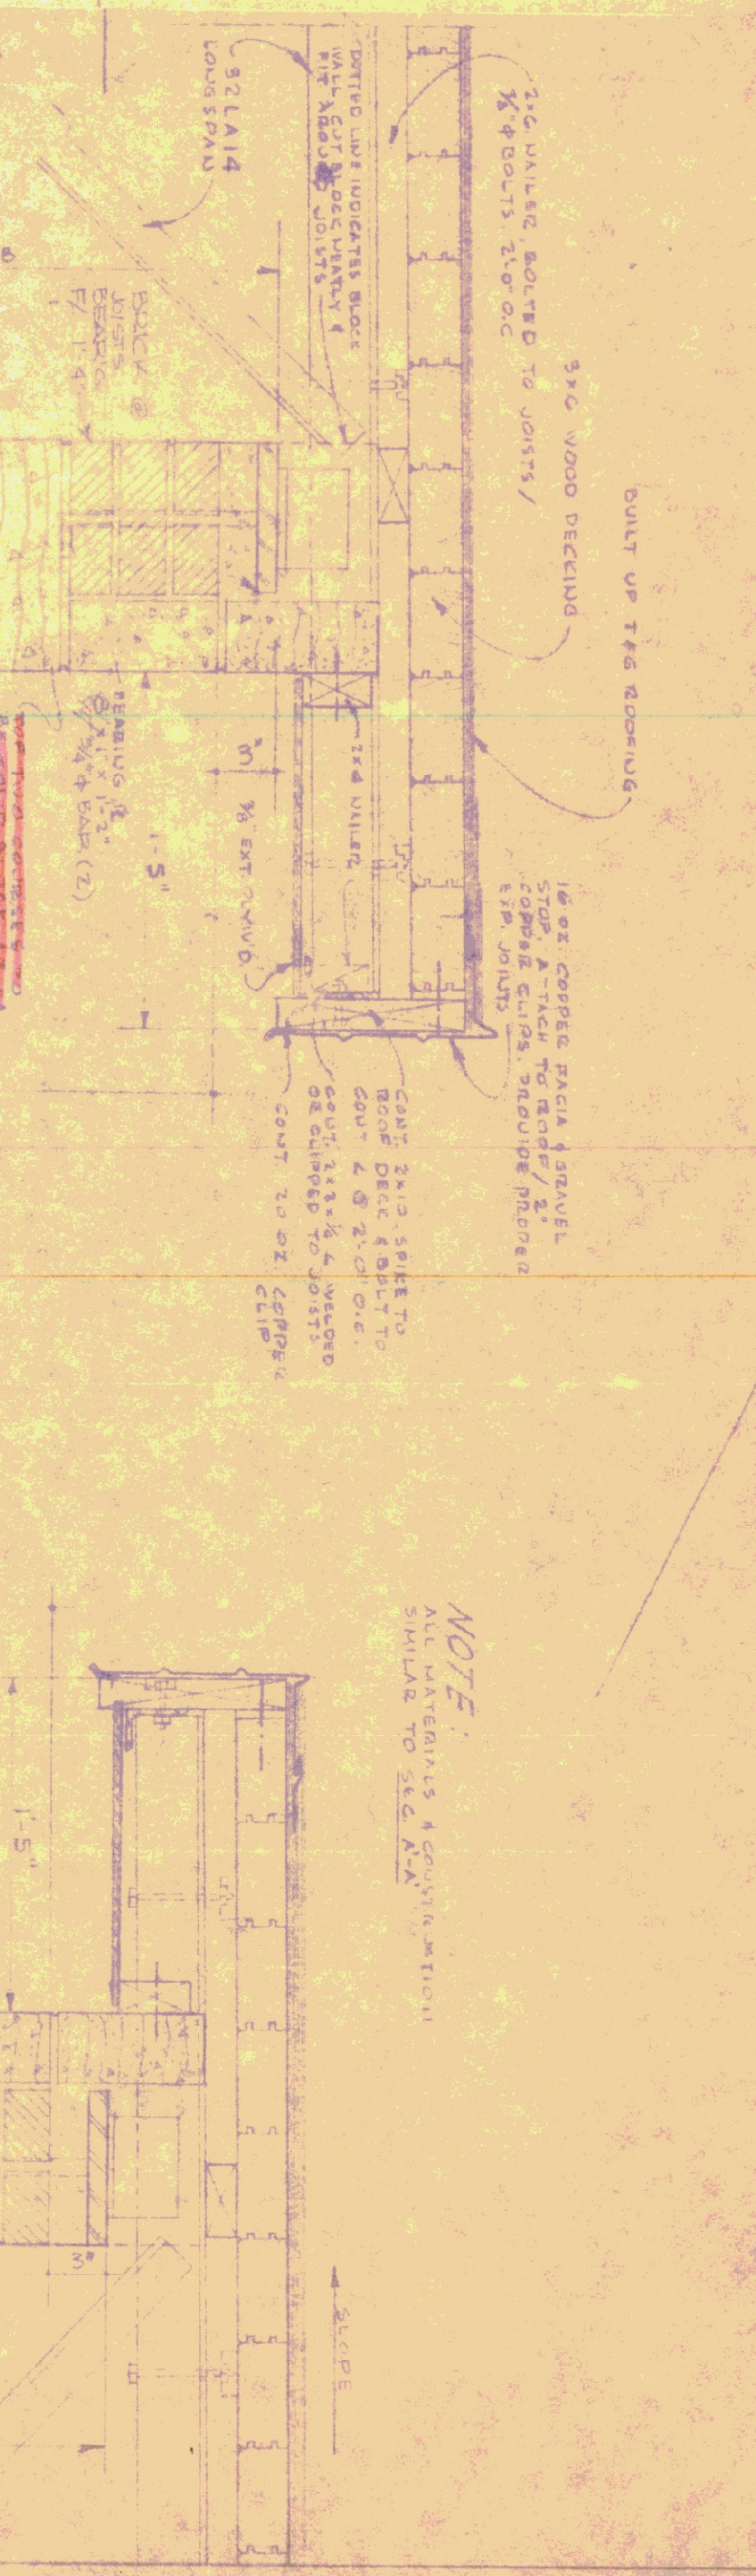
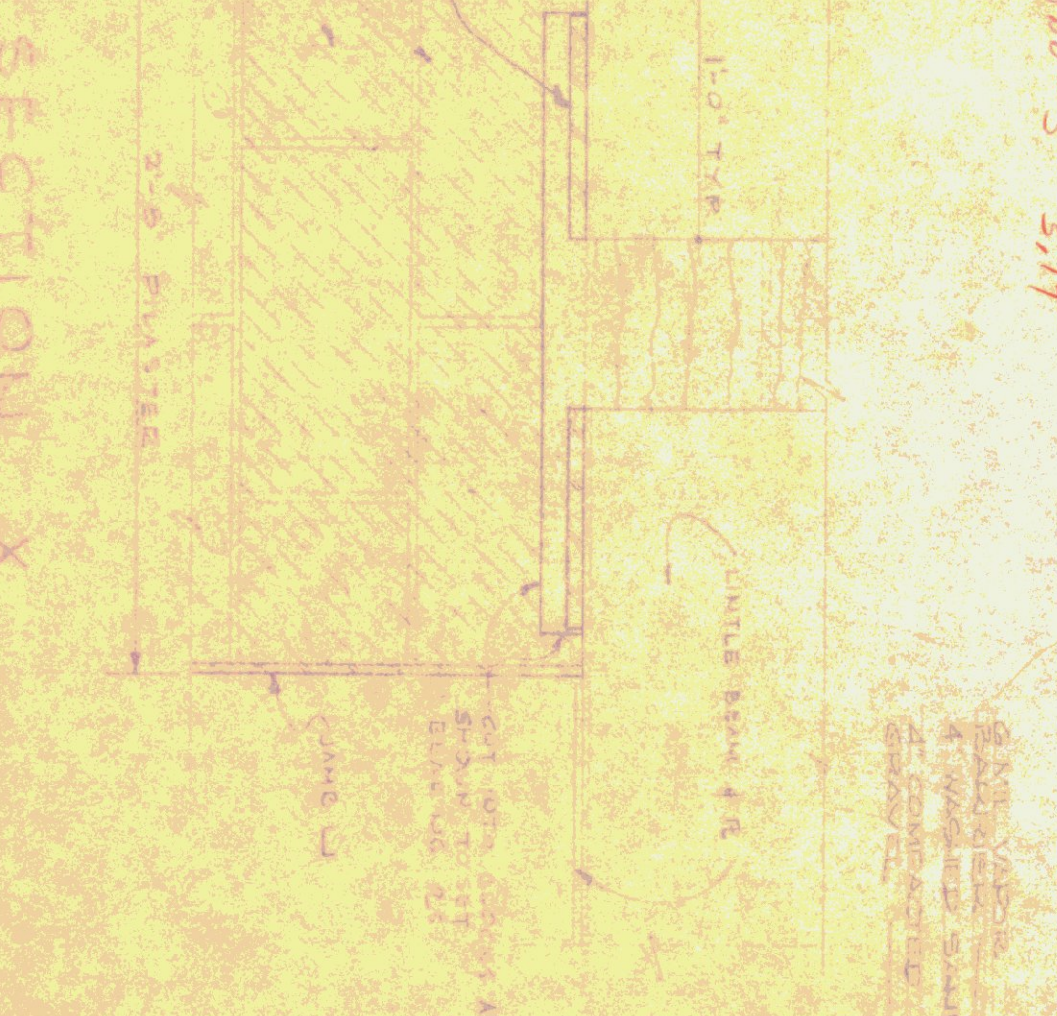
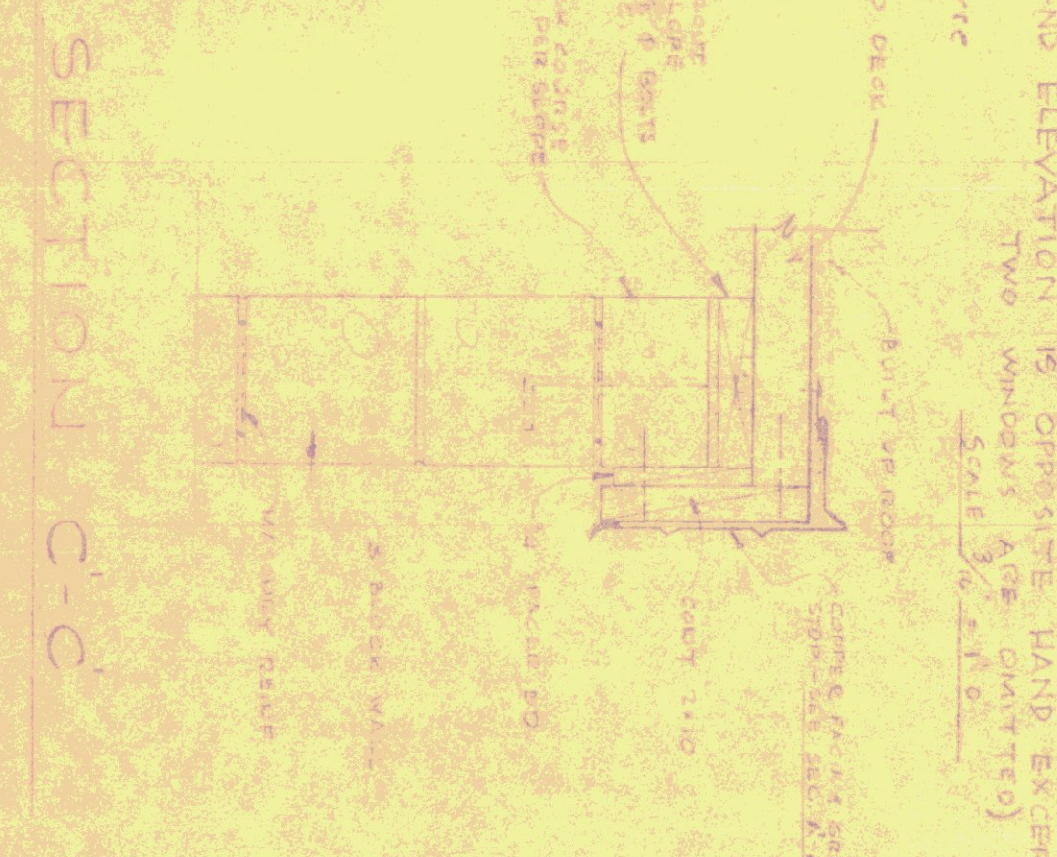


**OFFICE END ELEVATION**  
 LEFT END ELEVATION IS OPPOSITE HAND EXCEPT THAT THE TWO WINDOWS ARE OMITTED.  
 SCALE: 3/4"=1'-0"

**THIS ELEV IS TO BE READ AS IF IT WERE DRAWN OPPOSITE HAND, PER ADD#3 314**

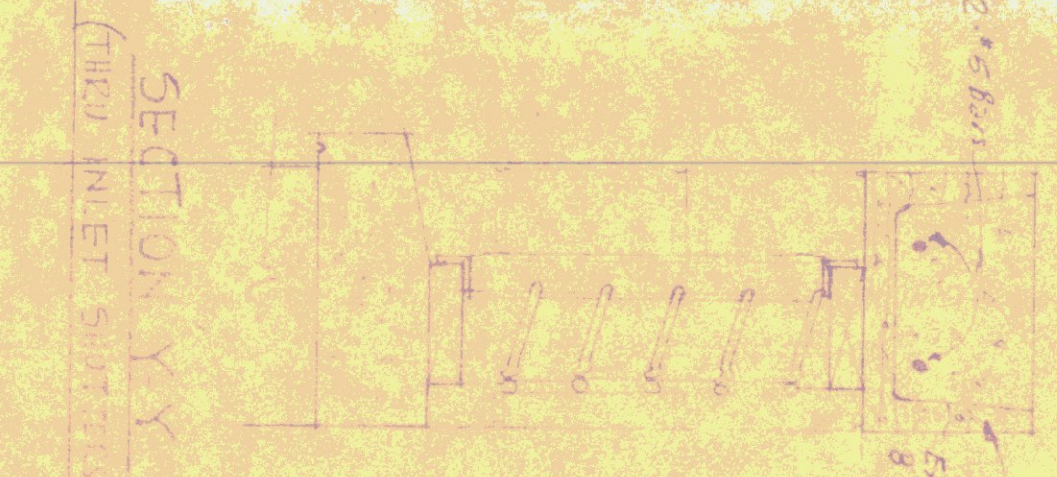

**NOTE:**  

STANDARD GARAGE BUILDING FOR  
 VERMONT DEPARTMENT OF HIGHWAYS  
 NO. 1 - NORTH MOUNTAIN  
 DEPT. OF ADMINISTRATION  
 STATE BUILDINGS DIVISION  
 DEPT. OF ADMINISTRATION  
 WINDFELDER  
 PERMITS