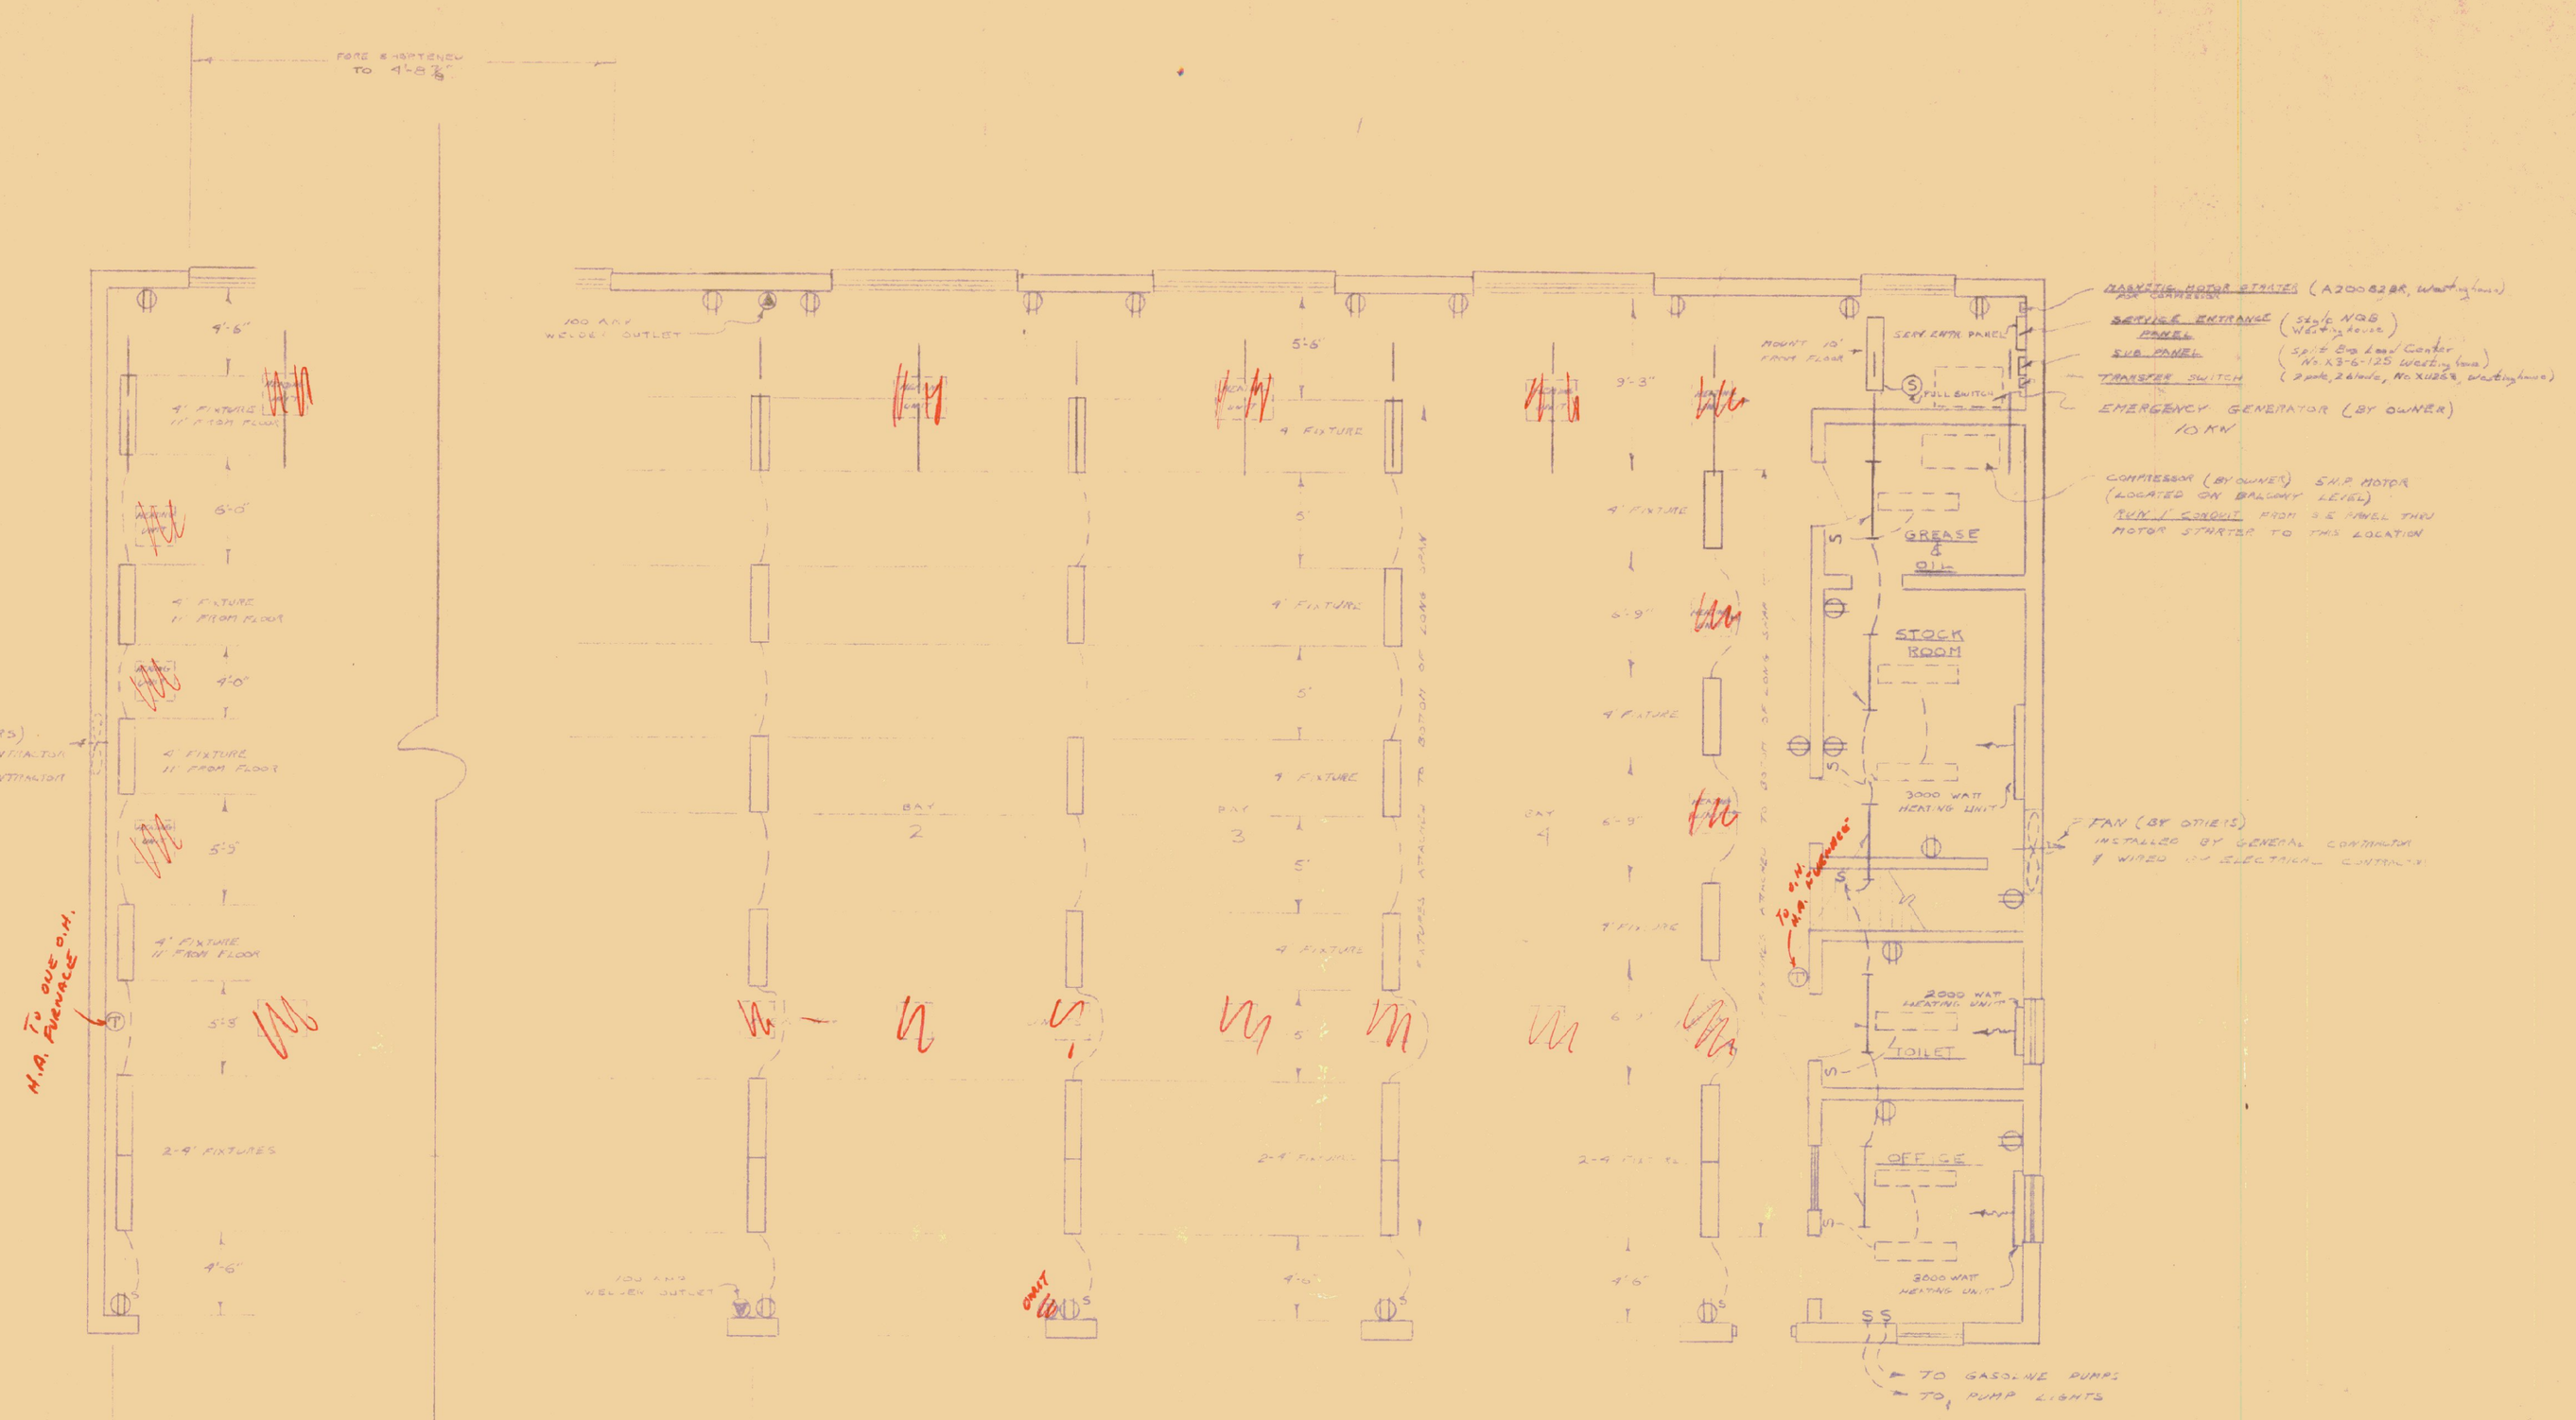

PLAN SCALE = 3/16" = 1'-0"

: INDICATES SATCHCRAFT "TECH", 30-TEC-2-40B or equal TO BE MOUNTED ON SOUTH OF LONG SPAN (EXCEPT 4 UNITS IN BAY 2 ALONG SOUTH WALL & UNIT IN BEHAVIORAL AREA)

: INDICATES WESTINGHOUSE 1-TUBE 1'12 STRIP, 5-STM-0/R or equal TO BE MOUNTED ON BOTTOM OF LONG SPAN.

: INDICATES SMITHCRAFT DOWNLIGHT, 6-DRA-2-40 TO BE MOUNTED ON CEILING

Ⓣ : INDICATES THERMOSTATS BY HEATING CONTRACTOR ELECTRICAL CONTRACTOR RUN CONDUIT TO Ⓣ LOCATION FROM S.E. PANEL

STANDARD GARAGE BUILDING
FOR
VERMONT DEPARTMENT OF HIGHWAYS

DATE AUG 1, 1967	STATE BUILDINGS DIV.	Drawn by R.G.H.
SCALE 3/16"=1'0"	DEPT OF ADMINISTRATION MONTPELIER VERMONT	DRWG. NO 4E