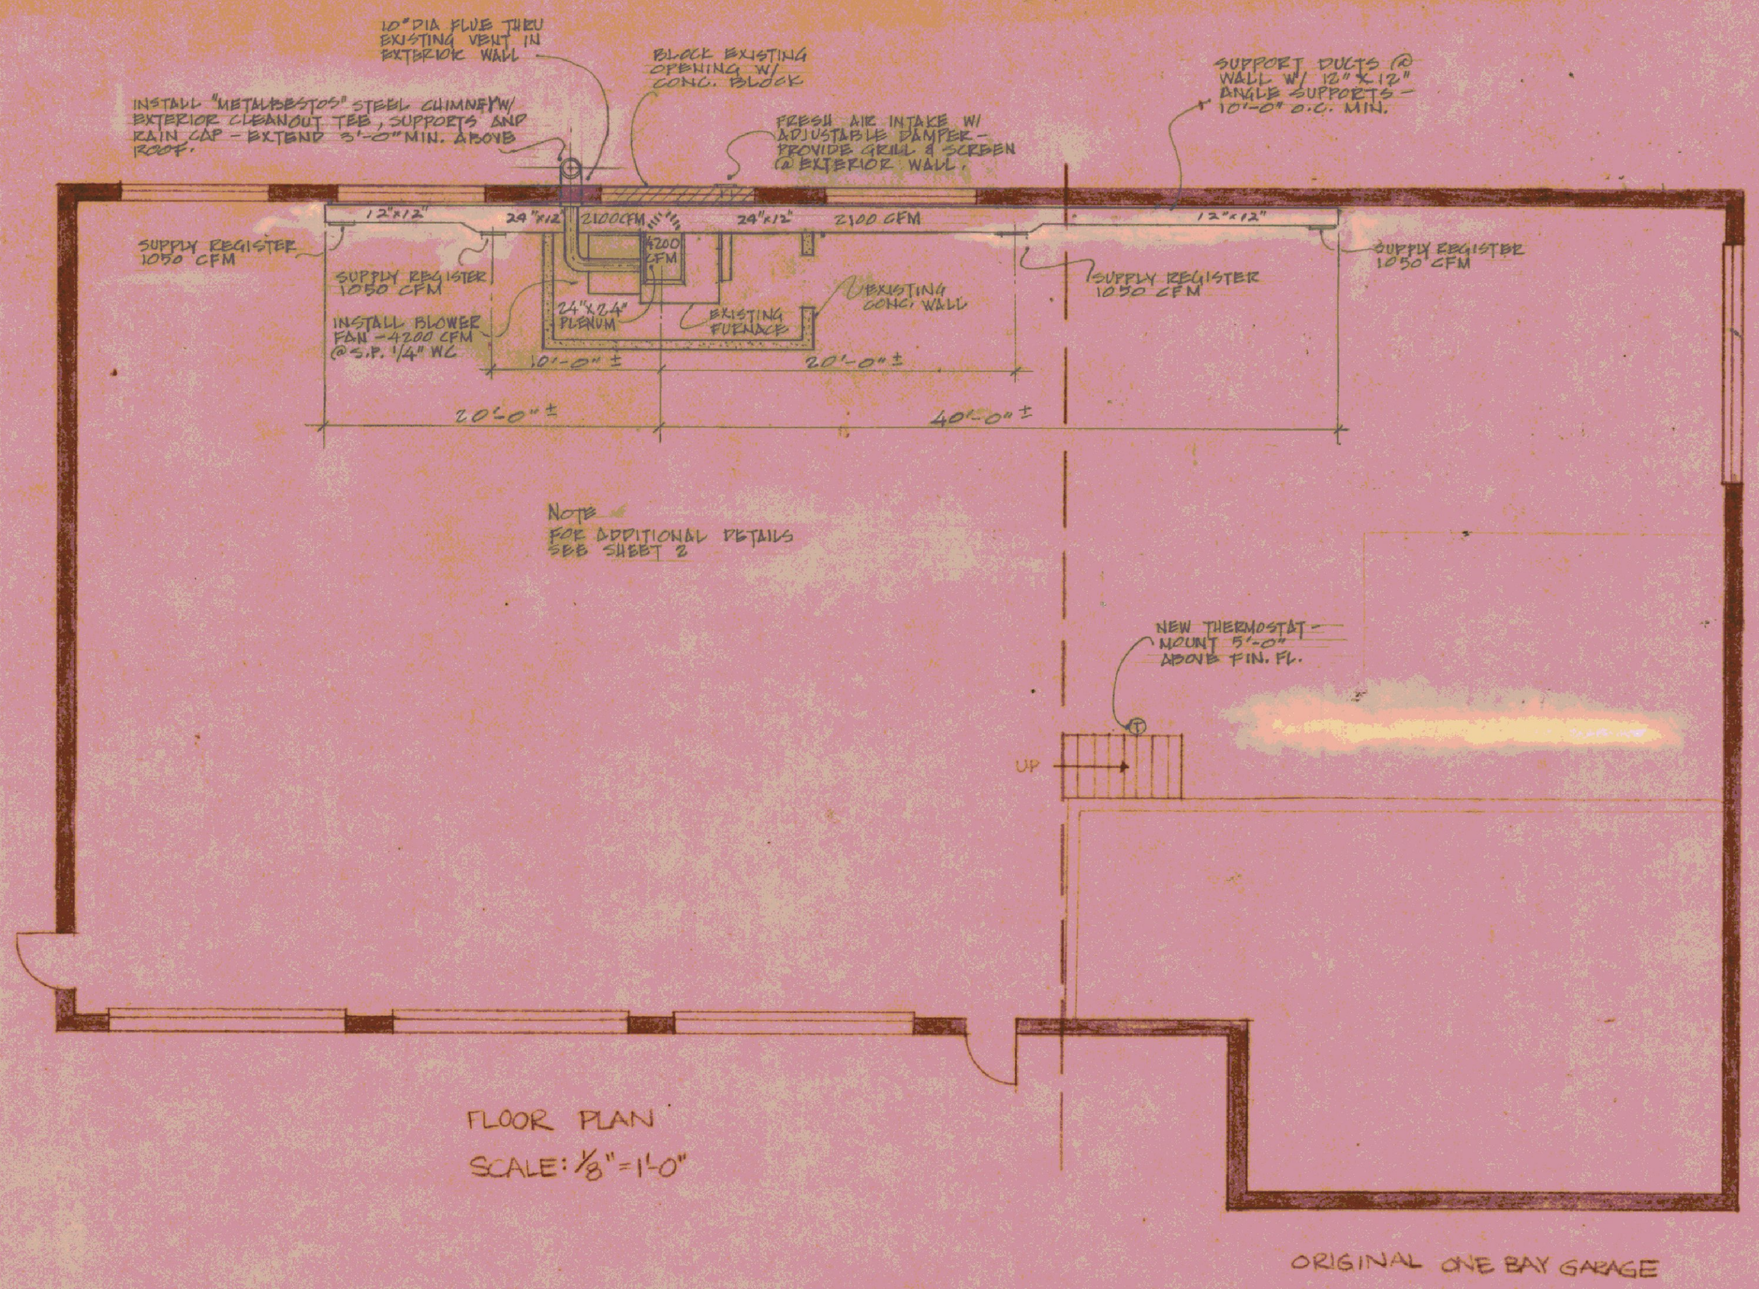

FLOOR PLAN
SCALE: 1/8" = 1'-0"

ORIGINAL ONE BAY GARAGE

STATE OF VERMONT
DIVISION OF STATE BUILDINGS
AGENCY OF ADMINISTRATION
MONTPELIER, VERMONT

WOODBURNING FURNACE INSTALLATION
@ AGENCY OF TRANSPORTATION GARAGE
BRADFORD, VT.

DATE:	SCALE:	REVISIONS:	DWG. NO.
7-29-80	AS NOTED	CHANGED DUCTS 10-15-80	
DRAWN BY: tkf/J. HUGHES	APPROVED BY: J.N. Macro		1 OF 3