


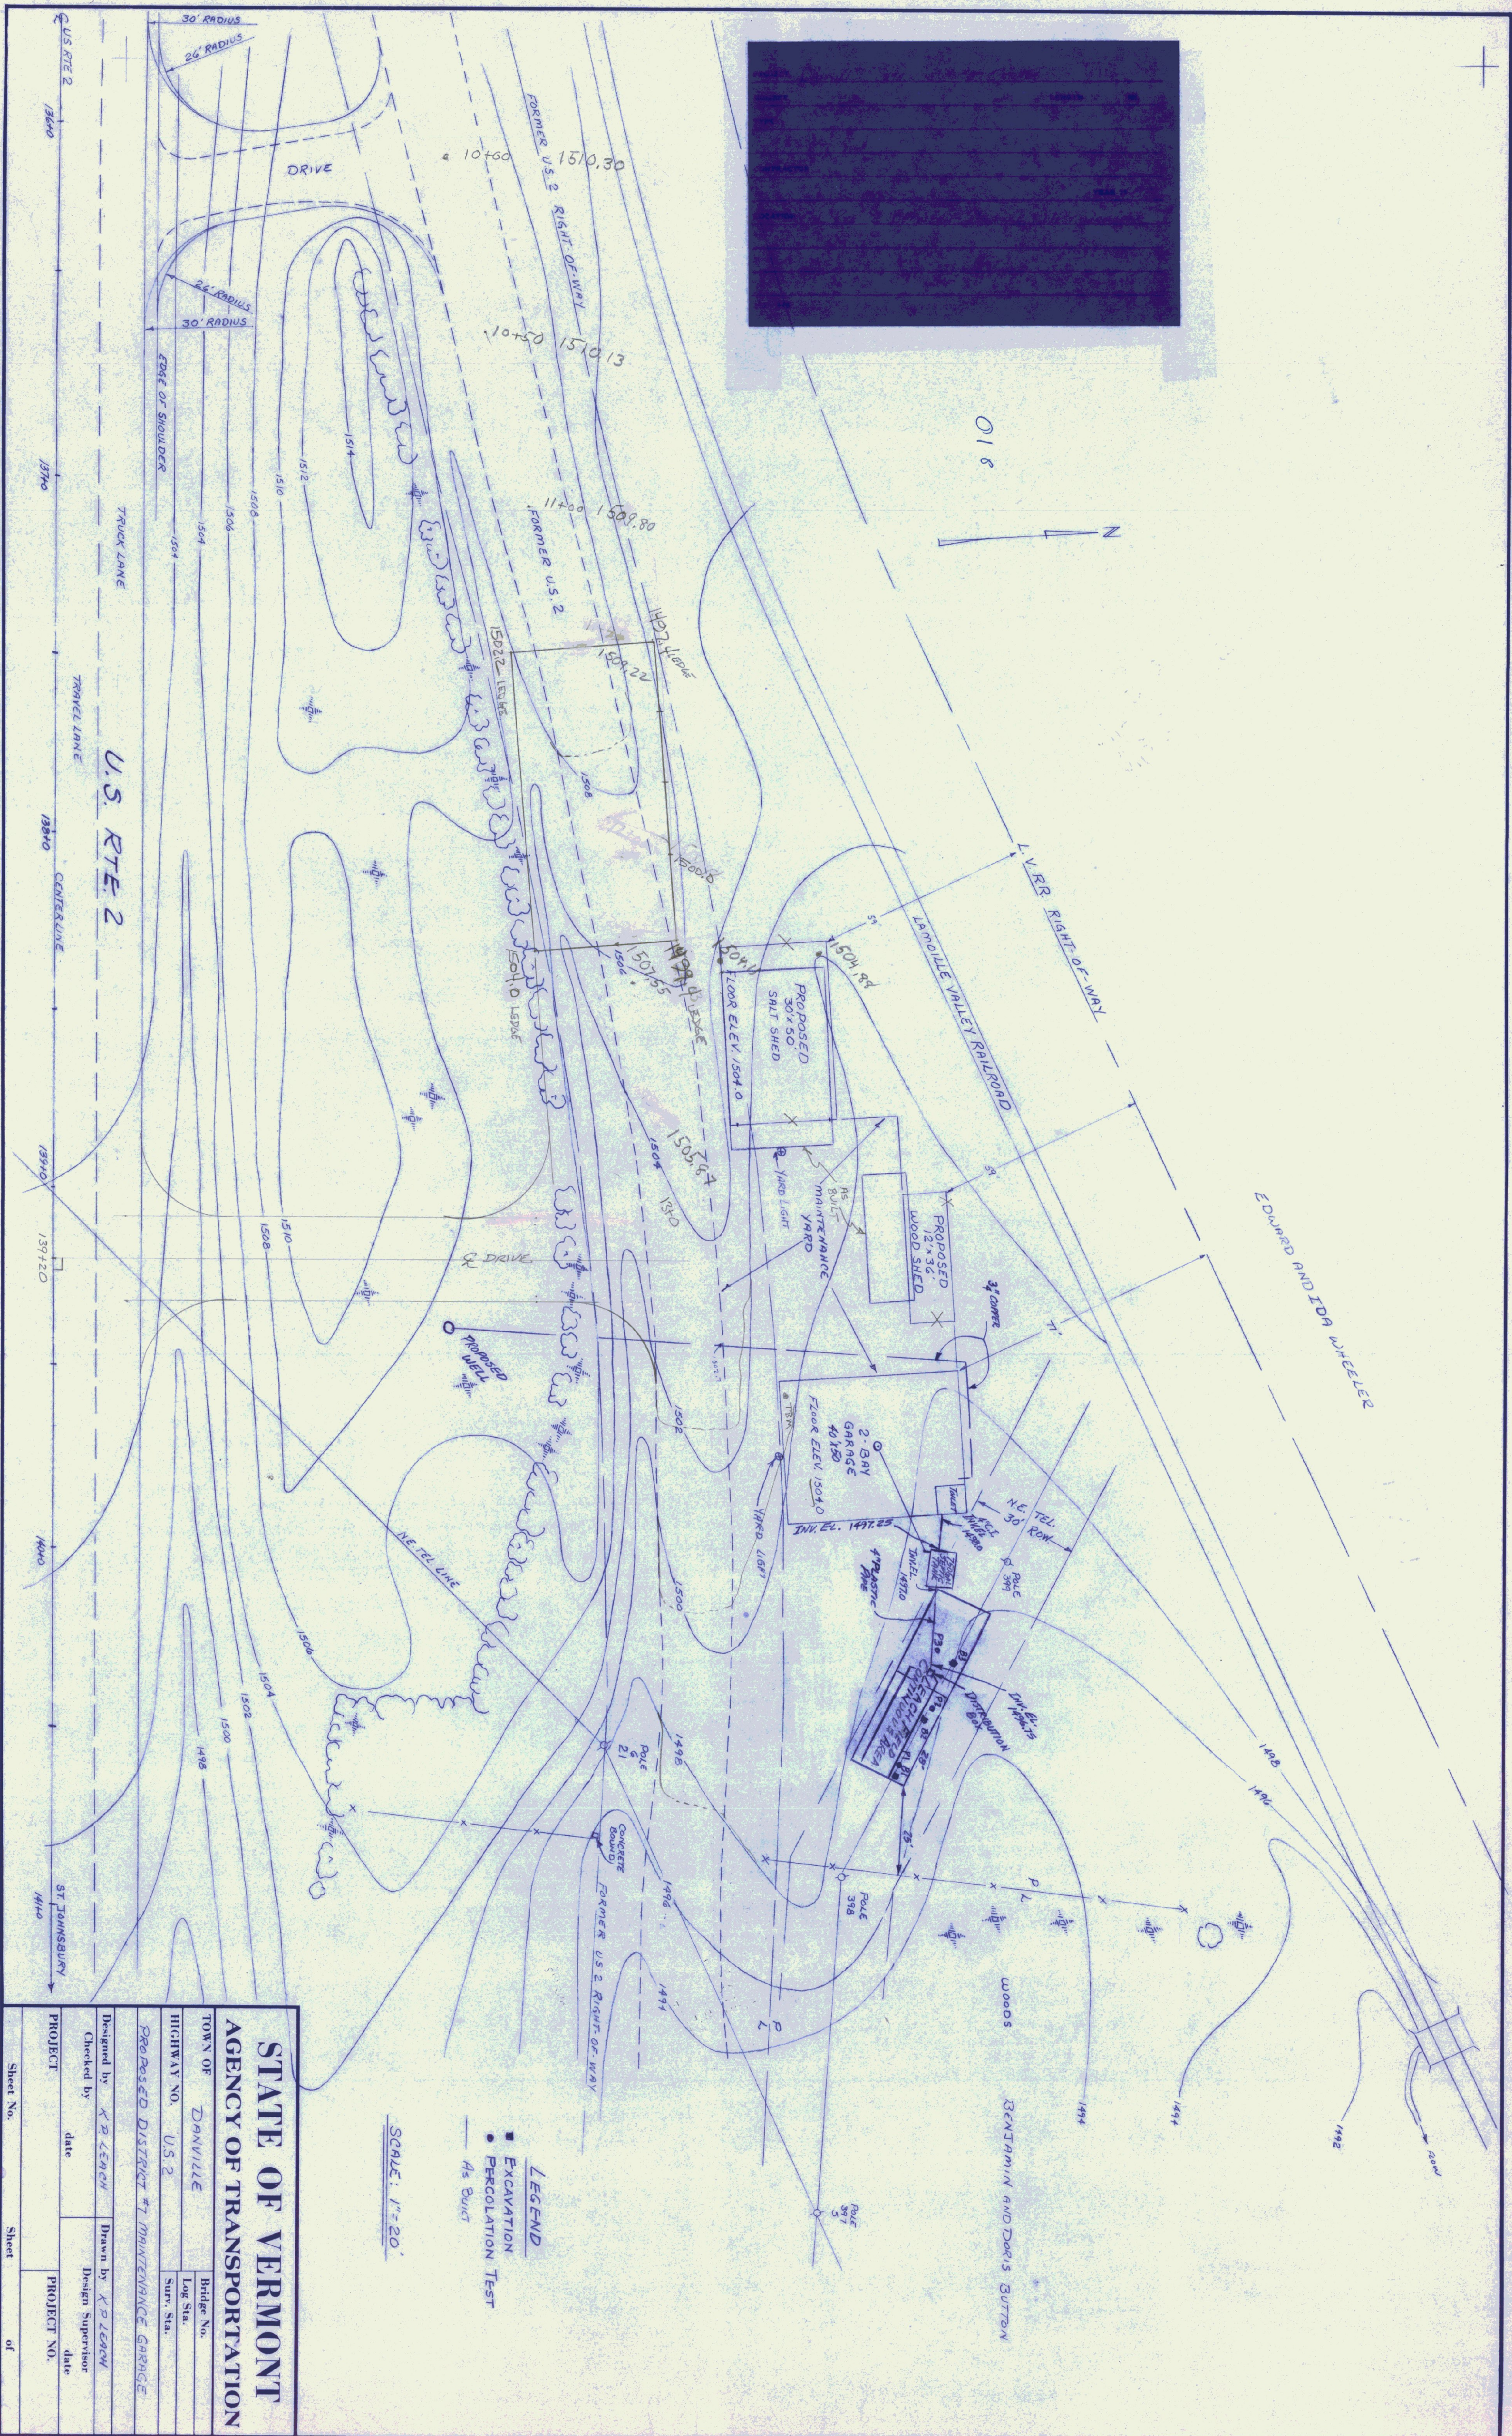

STATE OF VERMONT			
AGENCY OF TRANSPORTATION			
TOWN OF DANVILLE		Bridge No.	
HIGHWAY NO. U.S. 2		Long Sta.	
PROJECT PROPOSED DISTRICT #1 MAINTENANCE GARAGE		Surv. Sta.	
Designed by	K.B. LEACH	Drawn by	K.B. LEACH
Checked by	date	Design Supervisor	date
PROJECT		PROJECT NO.	
Sheet No.	Sheet of		