

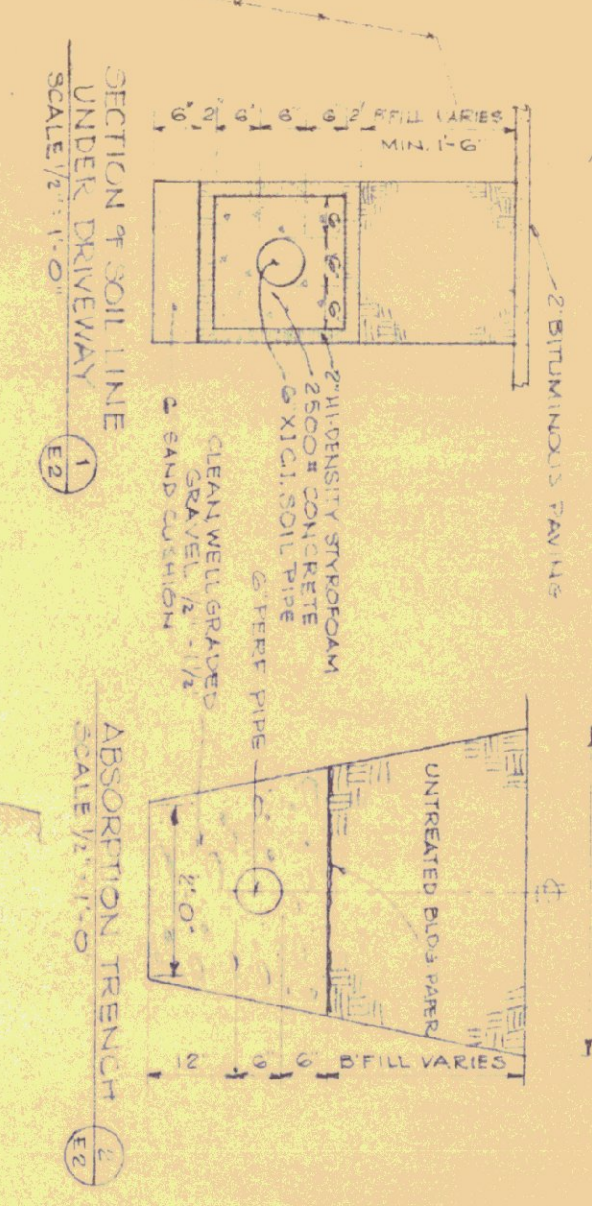
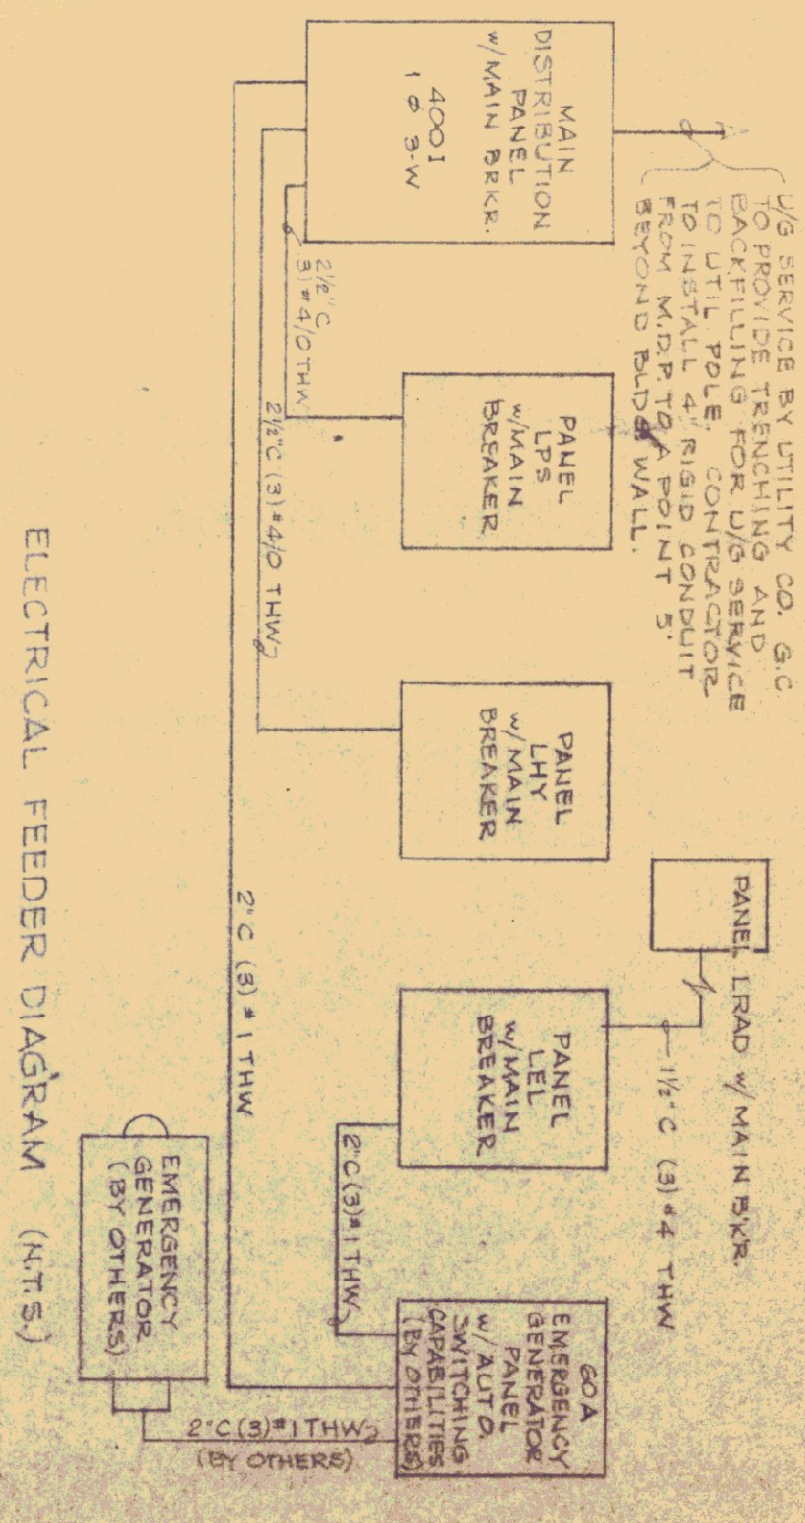
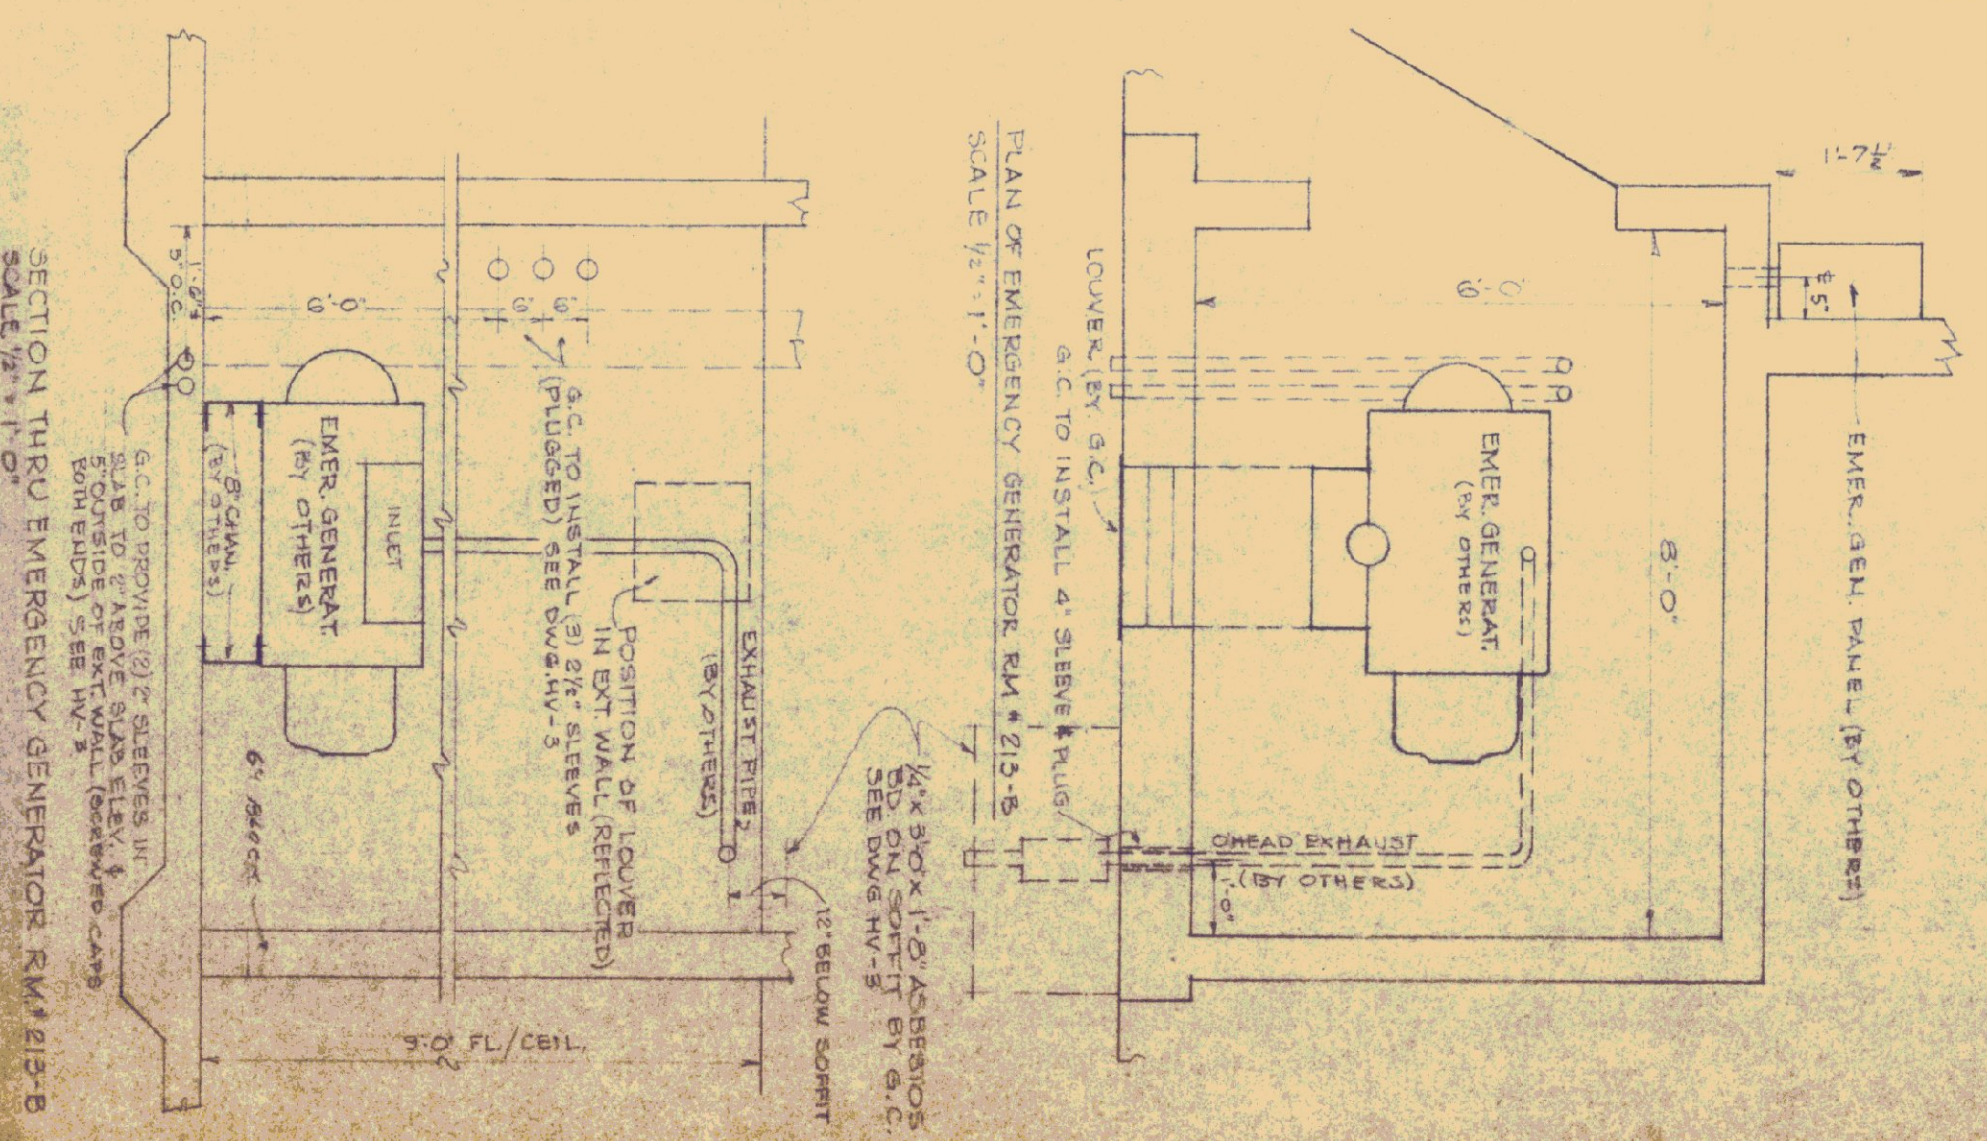


NOTE:  
GENERAL CONTRACTOR SHALL COORDINATE WITH OTHER CONTRACTORS IN THEIR WORK. SEE MAP LOCATION OF FIELD OR MAIN UNDERGROUND SERVICES. ETC.

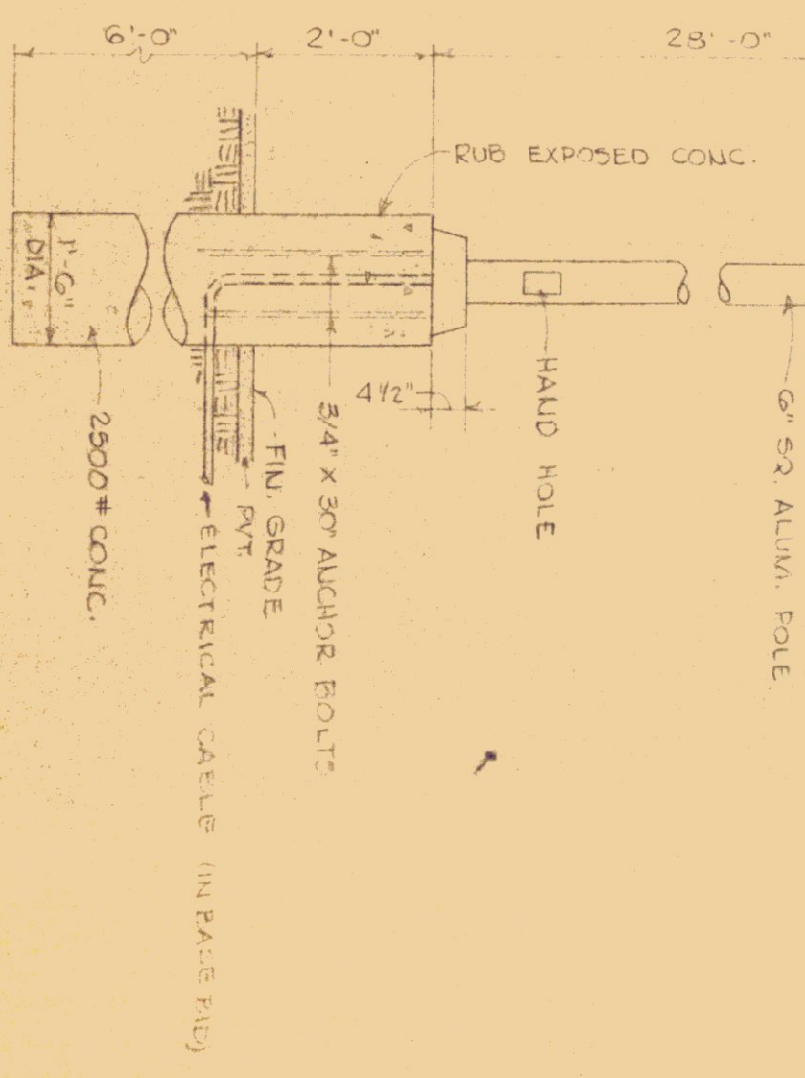

UTILITIES PLOT PLAN  
SCALE 1" = 20'

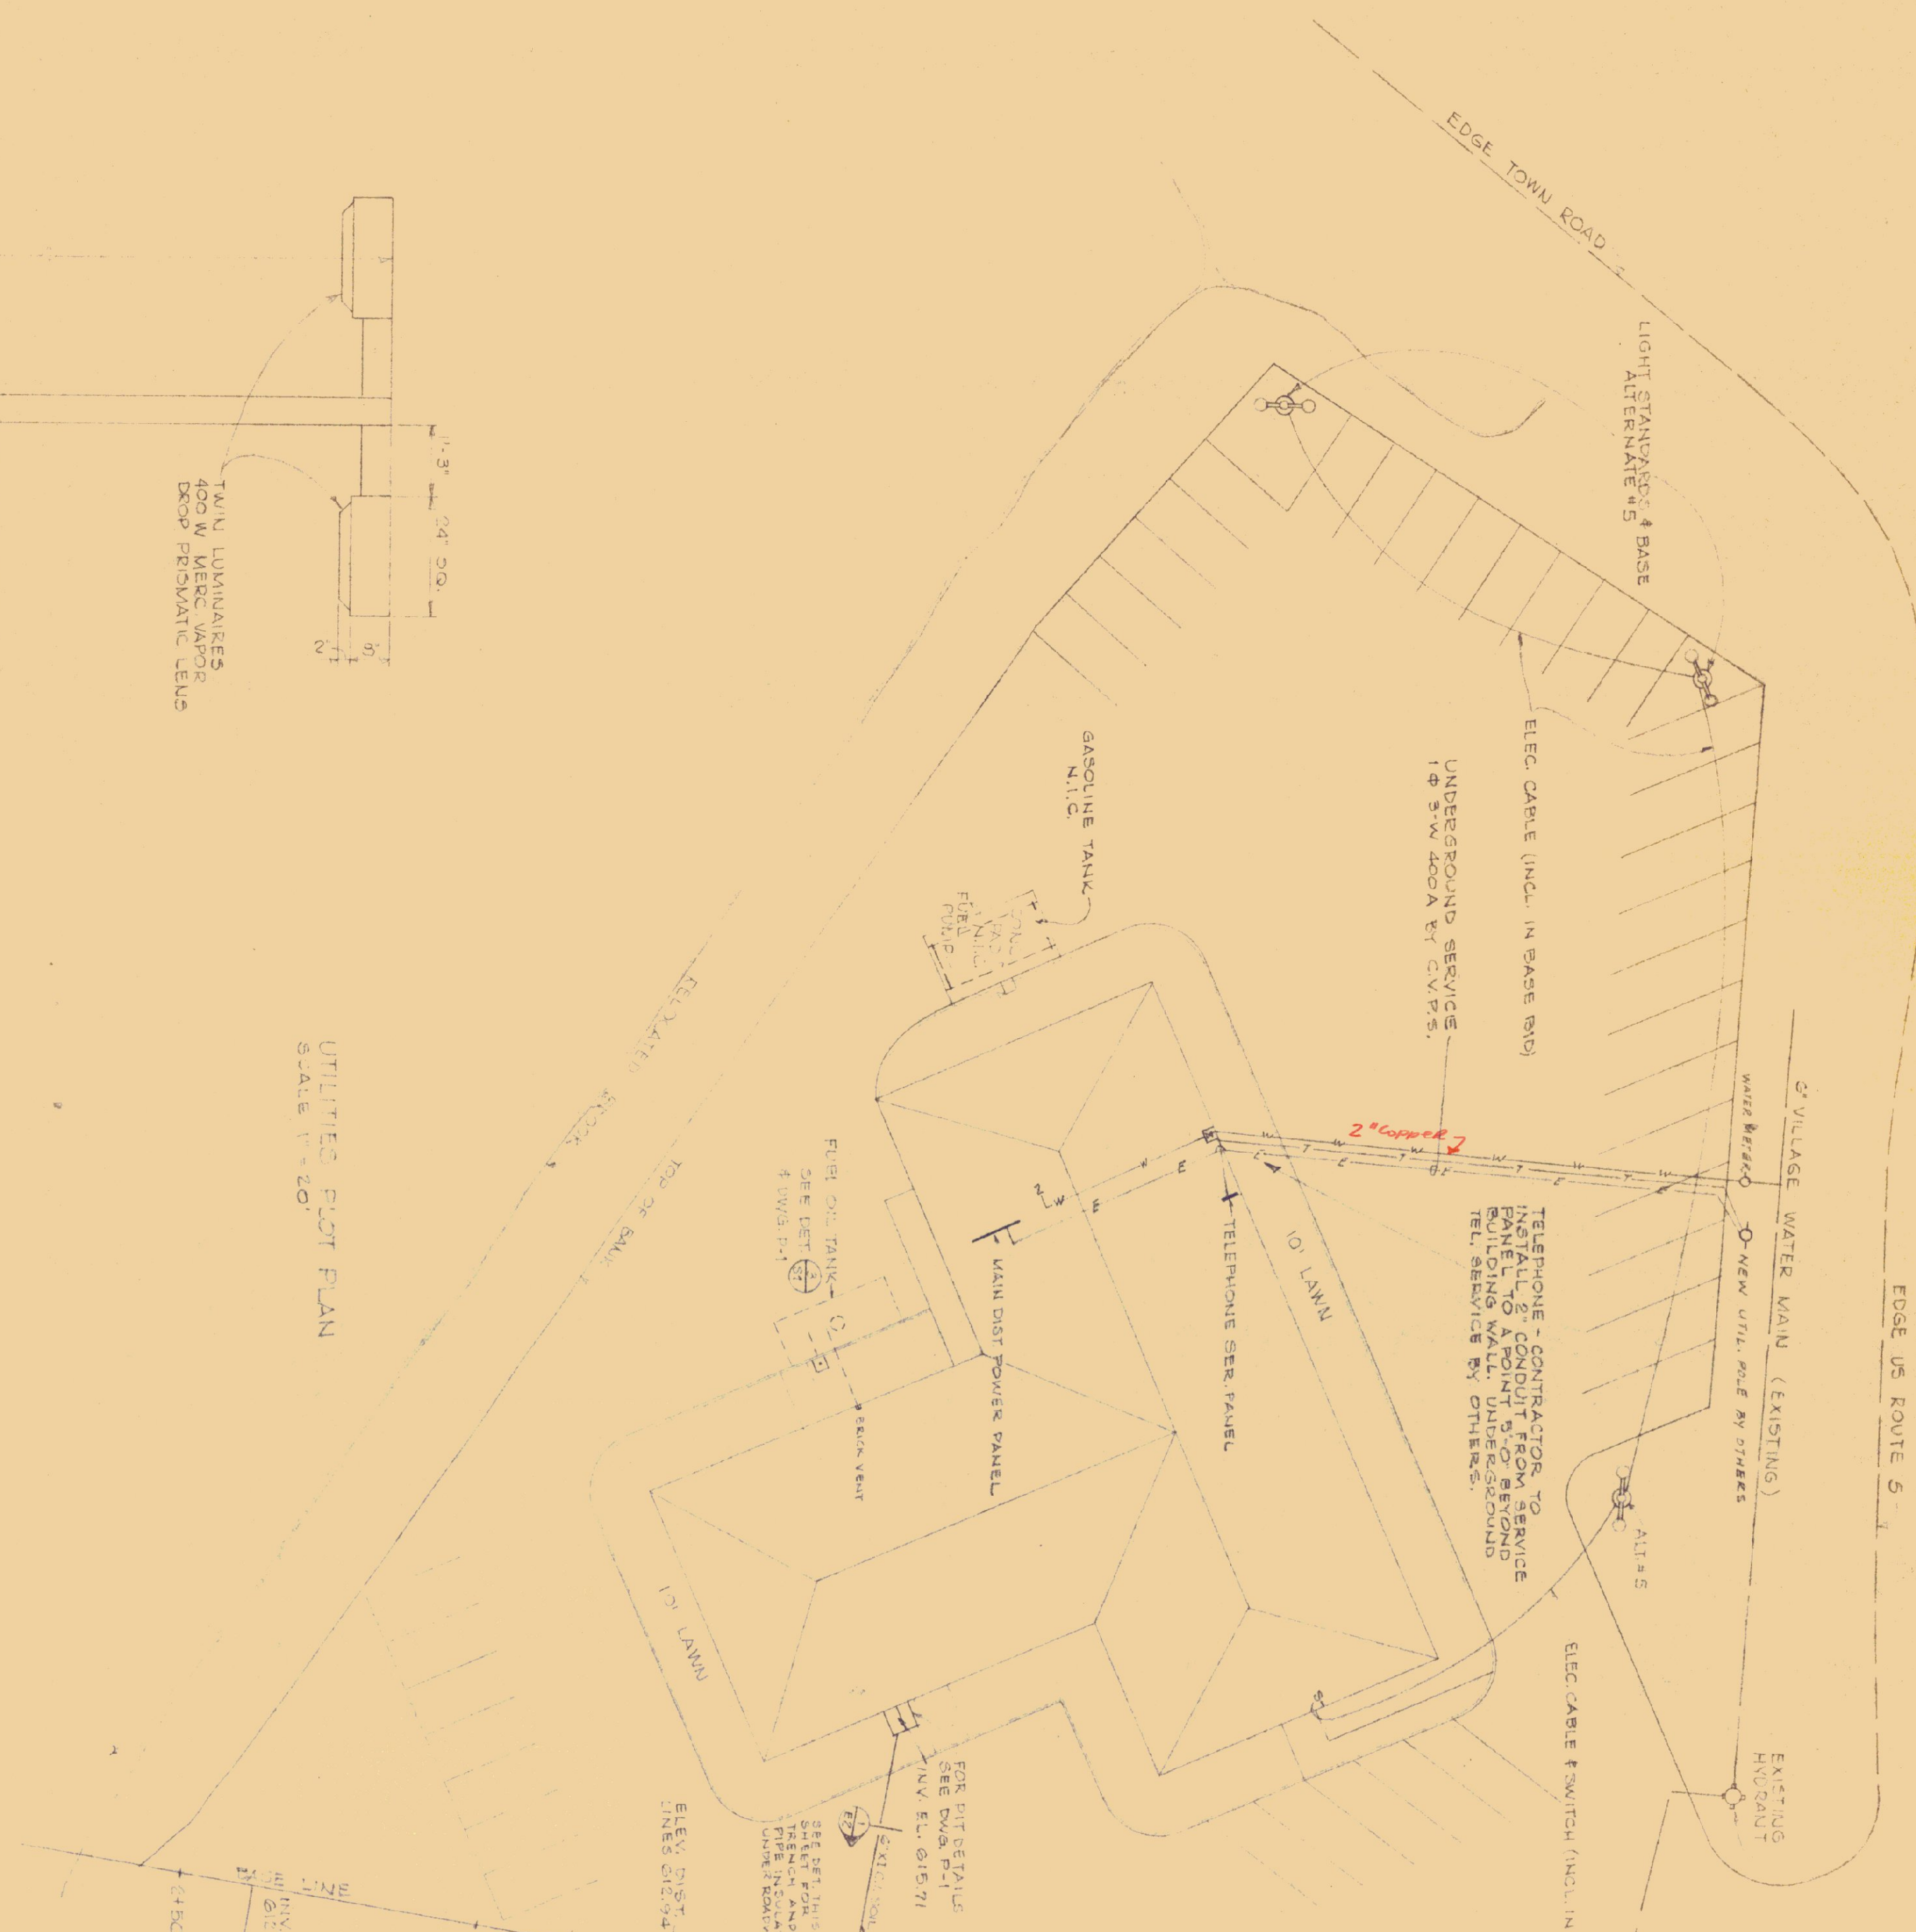

REVISIONS	
REV. NO.	DATE

STATE OF VERMONT	
STATE BUILDINGS DIVISION	
DEPARTMENT OF ADMINISTRATION	
MONTPELIER, VERMONT	
St. Johnsbury Office Bldg.	
Utilities Plot Plan and Details	
DATE: 6-16-72	DESIGNED BY: GNM
DRAWN BY: LJ	CHECKED BY: GNM
APPROVED BY:	DATE: 7/6/72
DWG. NO. E-2	
13 of 17	