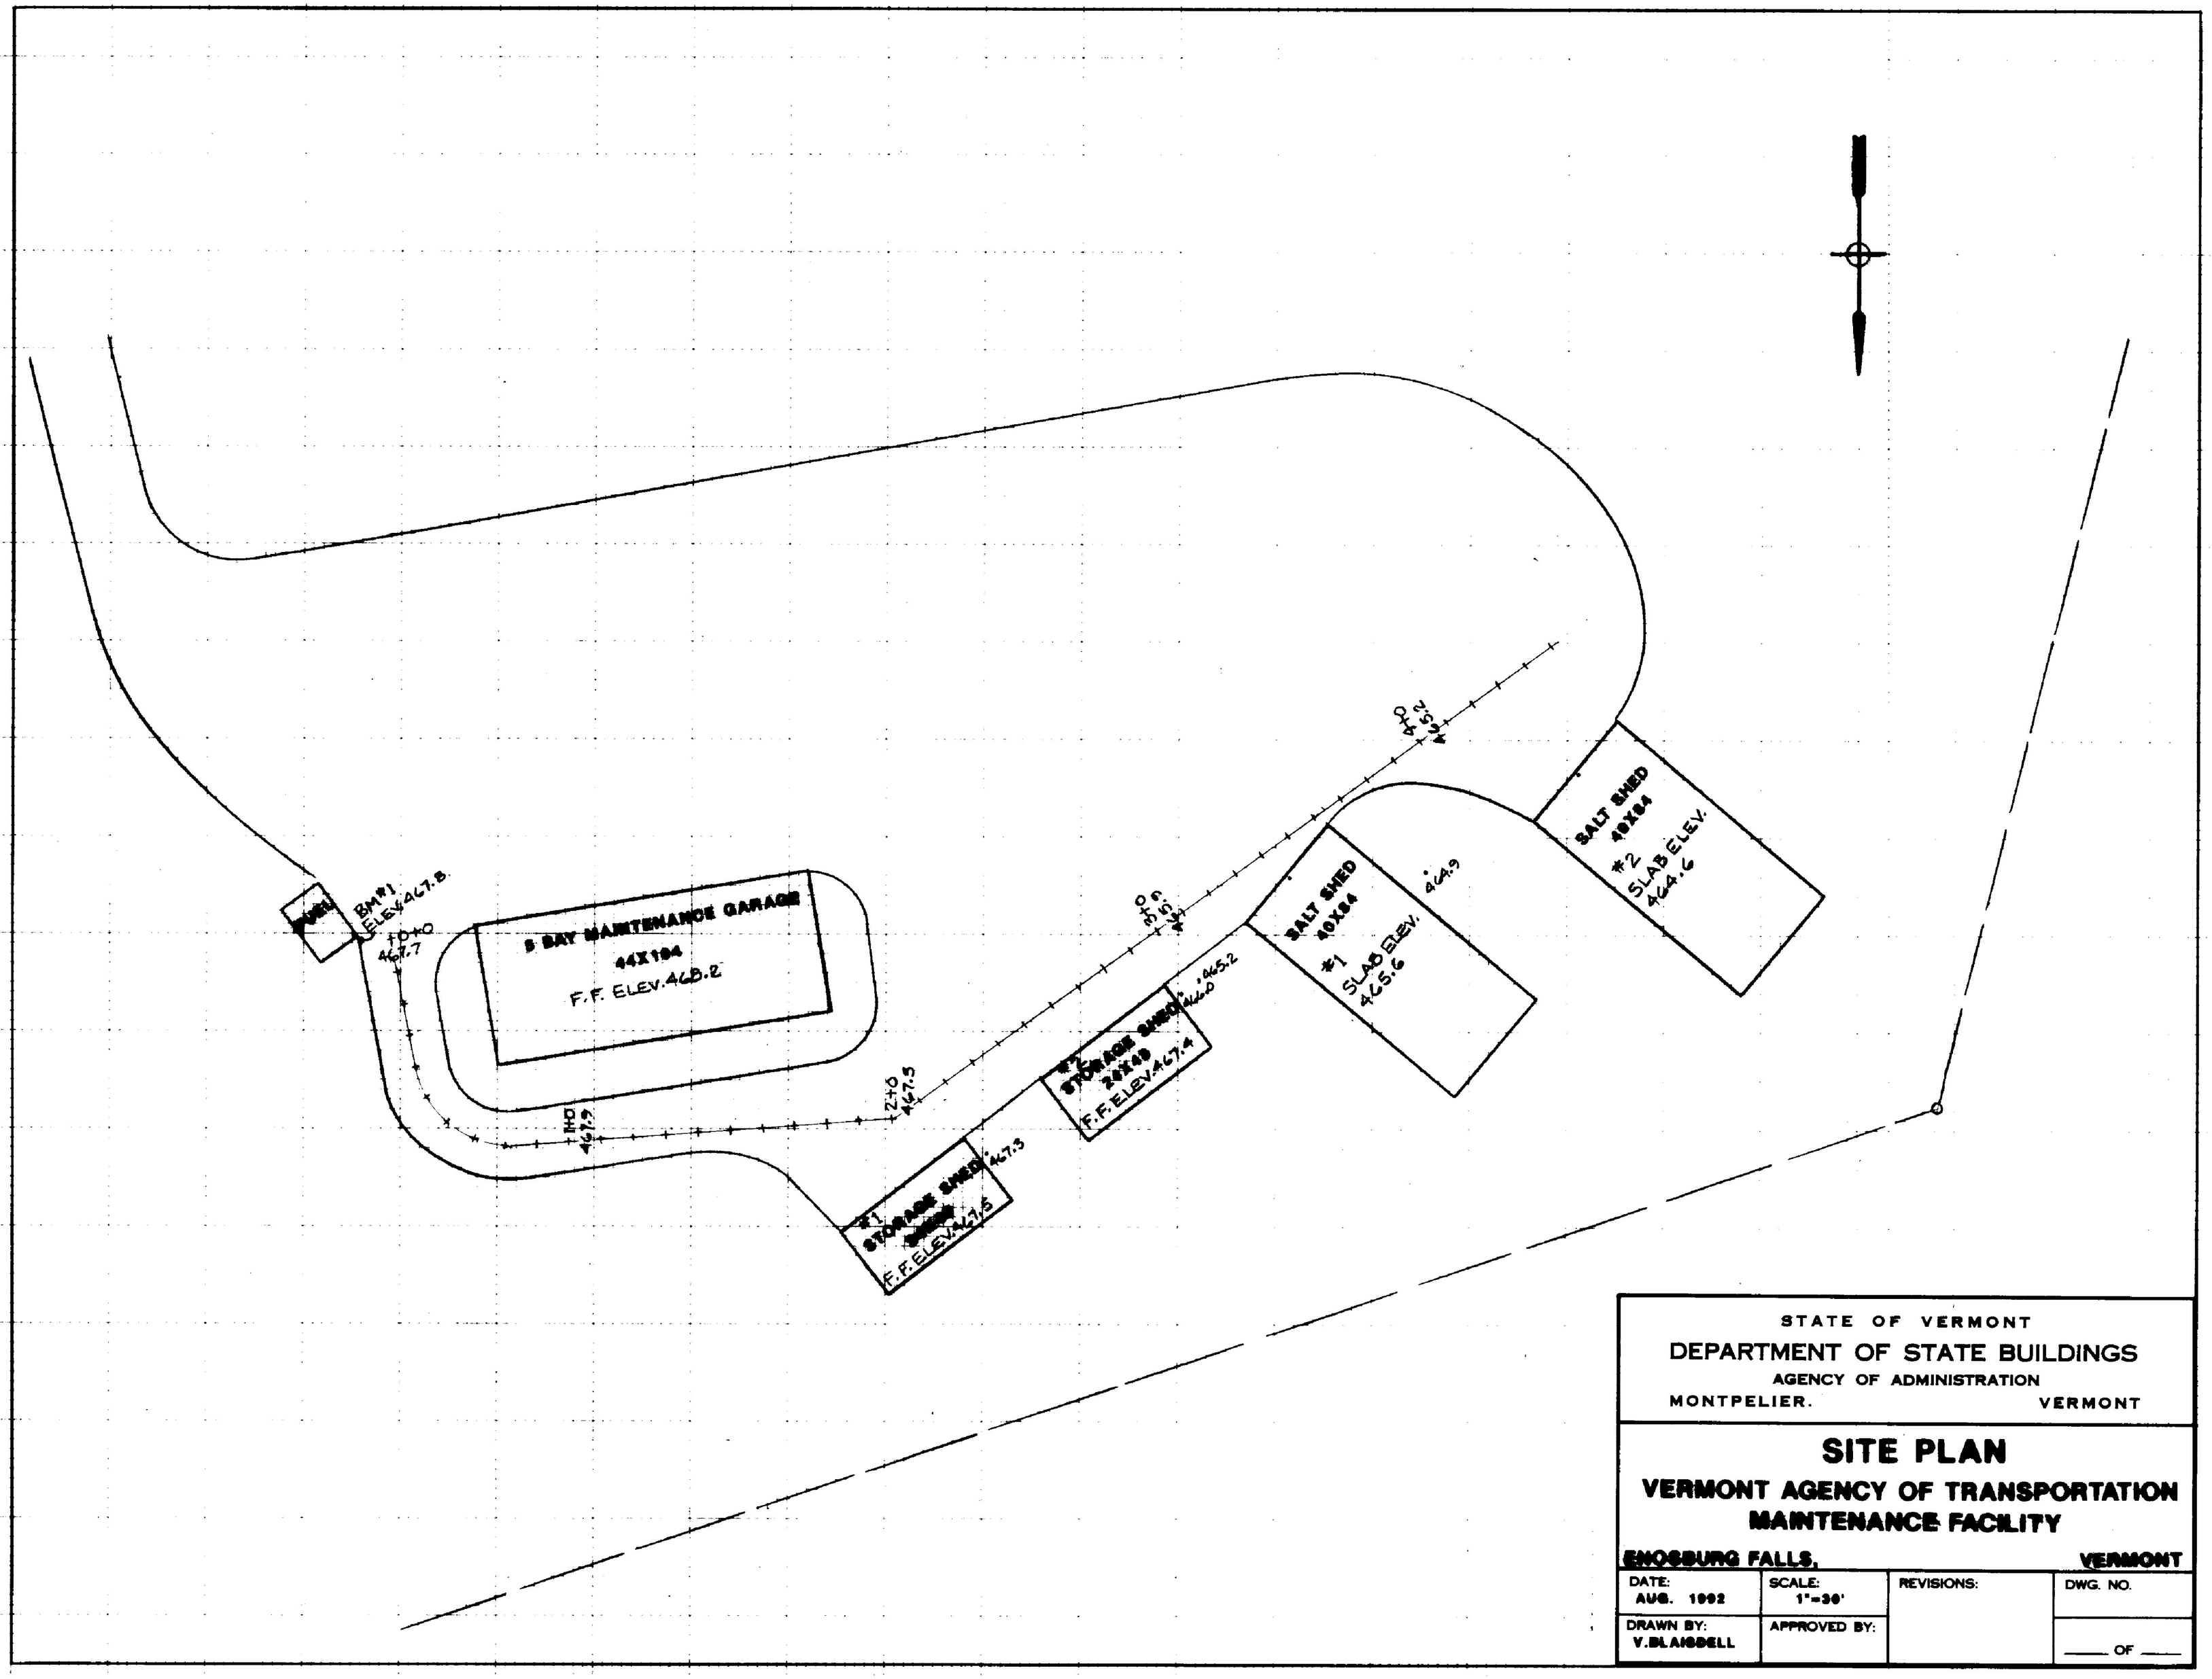

STATE OF VERMONT

DEPARTMENT OF STATE BUILDINGS

AGENCY OF ADMINISTRATION

MONTPELIER. VERMONT

SITE PLAN

VERMONT AGENCY OF TRANSPORTATION MAINTENANCE FACILITY

ENOSBURG FALLS, VERMONT

DATE: AUG. 1992	SCALE: 1"=30'	REVISIONS:	DWG. NO.
DRAWN BY: V.BLAISDELL	APPROVED BY:		____ OF ____