



SOUTH ELEVATION
SCALE: 1/4" = 1'-0"

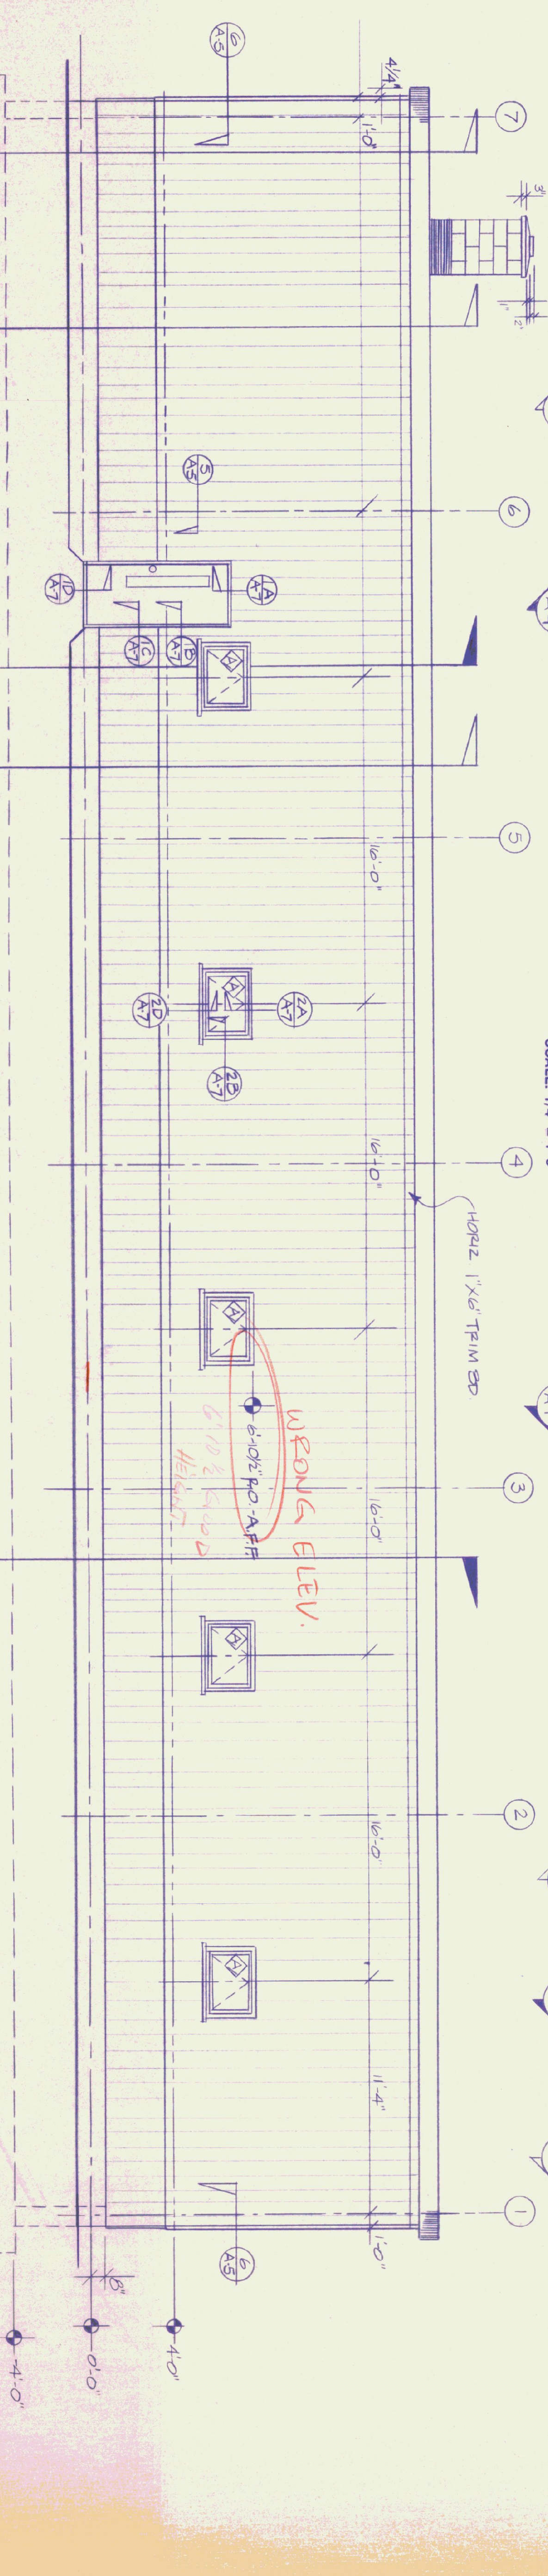

NORTH ELEVATION
SCALE: 1/4" = 1'-0"

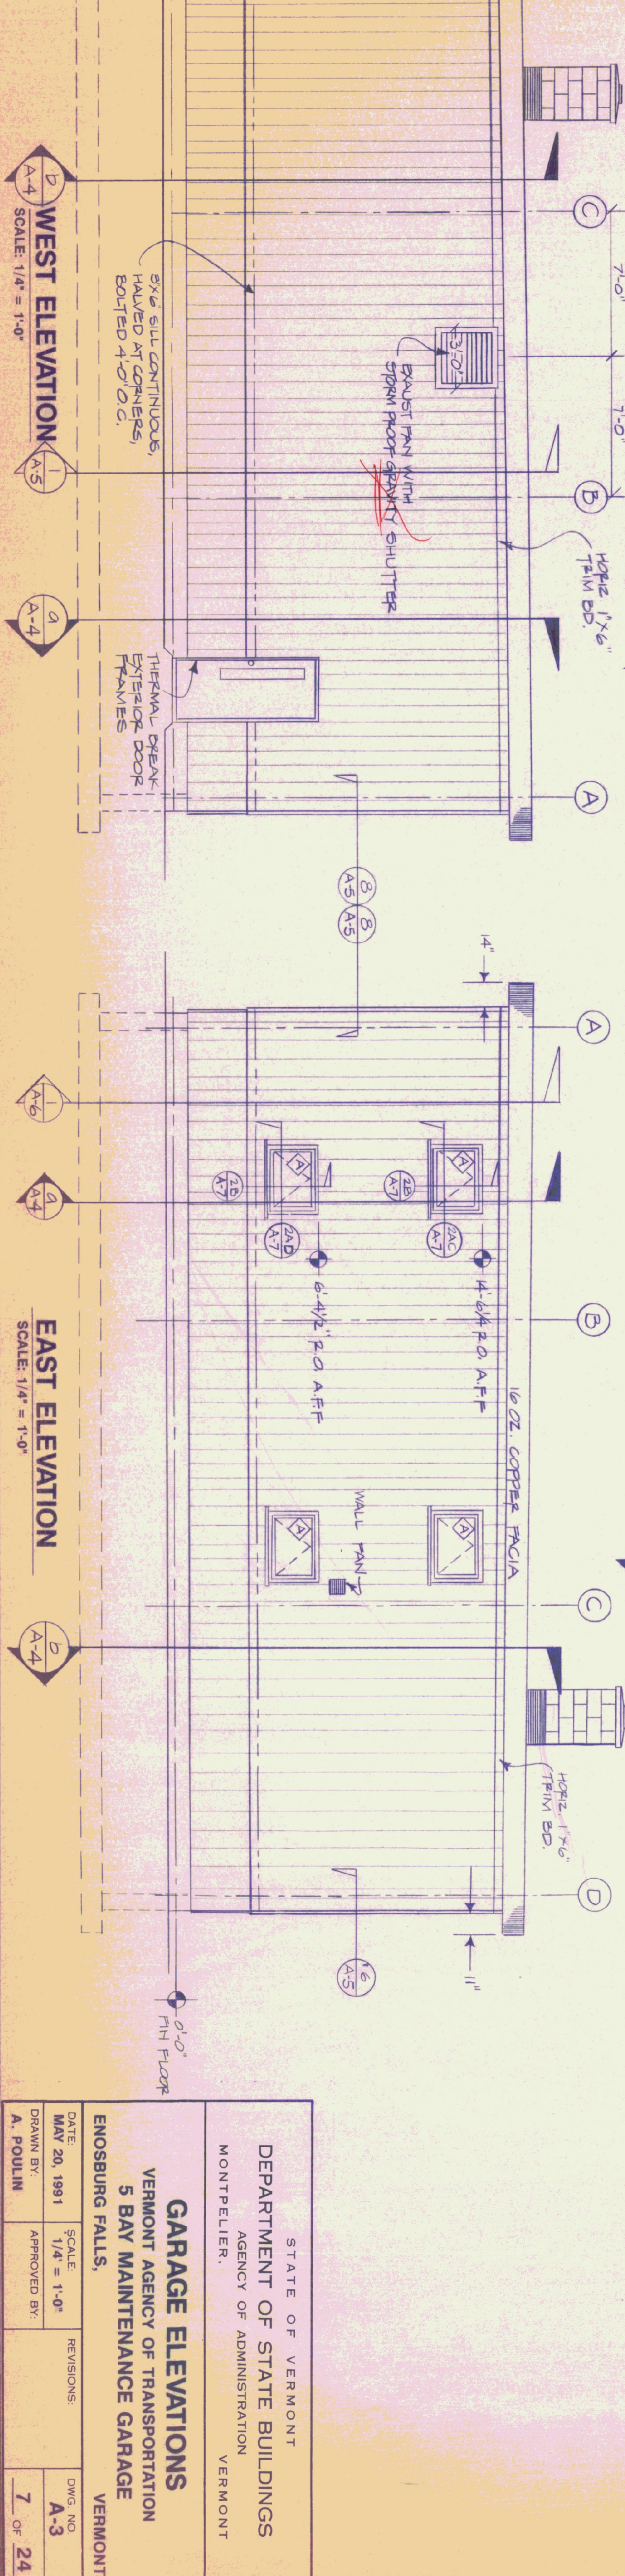

WEST ELEVATION
SCALE: 1/4" = 1'-0"

EAST ELEVATION
SCALE: 1/4" = 1'-0"

STATE OF VERMONT DEPARTMENT OF STATE BUILDINGS AGENCY OF ADMINISTRATION MONTPELIER, VERMONT			
GARAGE ELEVATIONS			
VERMONT AGENCY OF TRANSPORTATION 5 BAY MAINTENANCE GARAGE ENOSBURG FALLS, VERMONT			
DATE: MAY 20, 1991	SCALE: 1/4" = 1'-0"	REVISIONS:	DWG. NO. A-3
DRAWN BY: A. POULIN	APPROVED BY:		7 OF 24