



INTERIOR ELEVATION/SECTION (LOOKING TOWARD "A" LINE)  
SCALE: 1/4" = 1'-0"

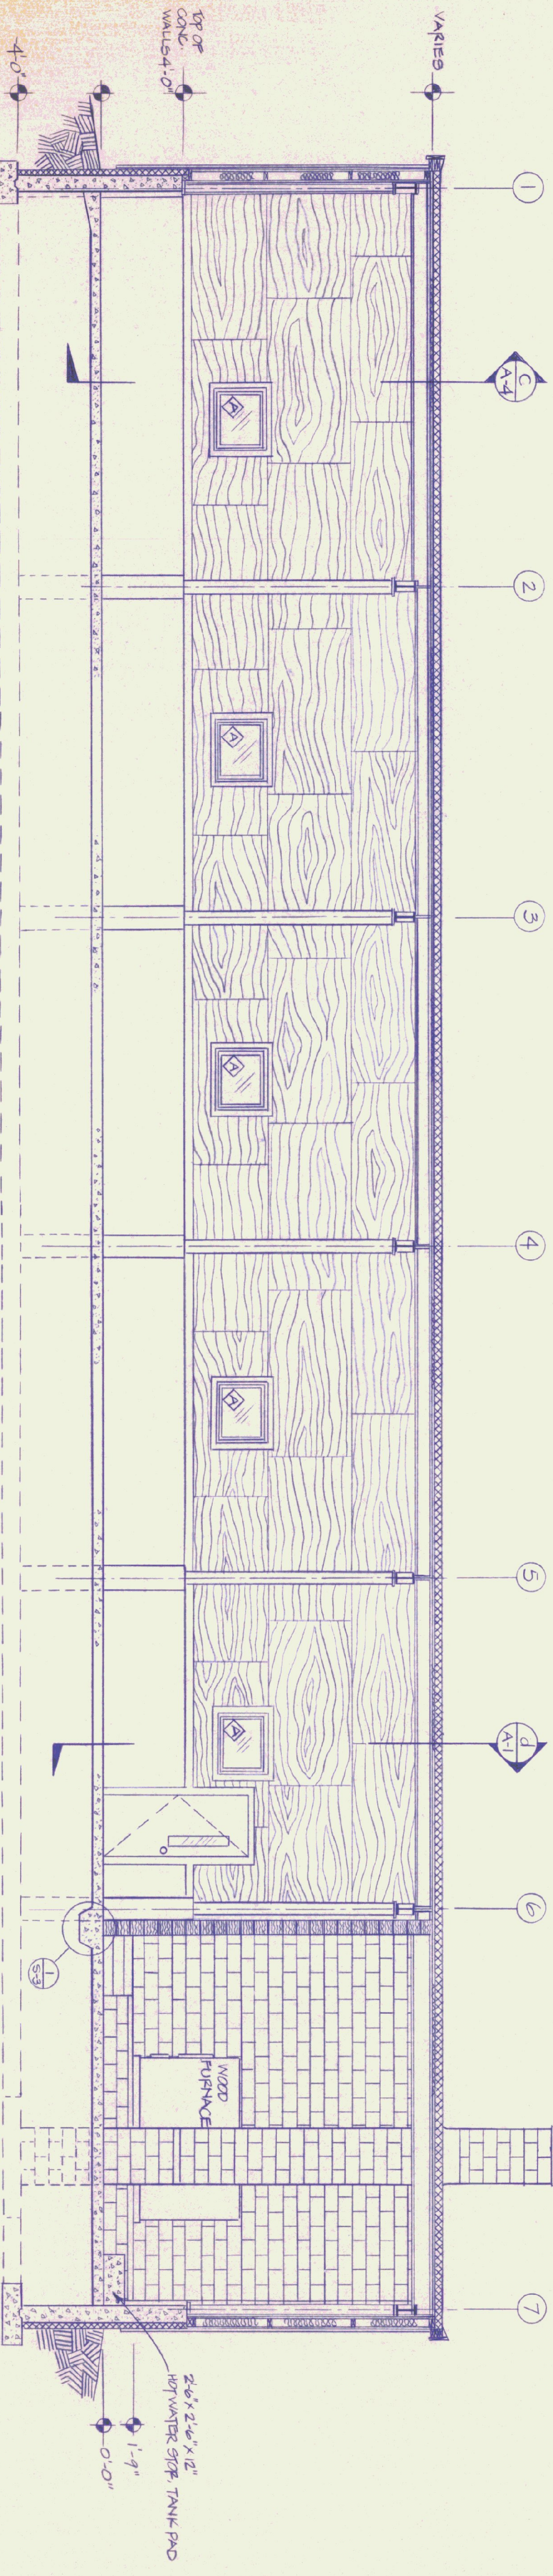

INTERIOR ELEVATION/SECTION (LOOKING TOWARD "D" LINE)  
SCALE: 1/4" = 1'-0"

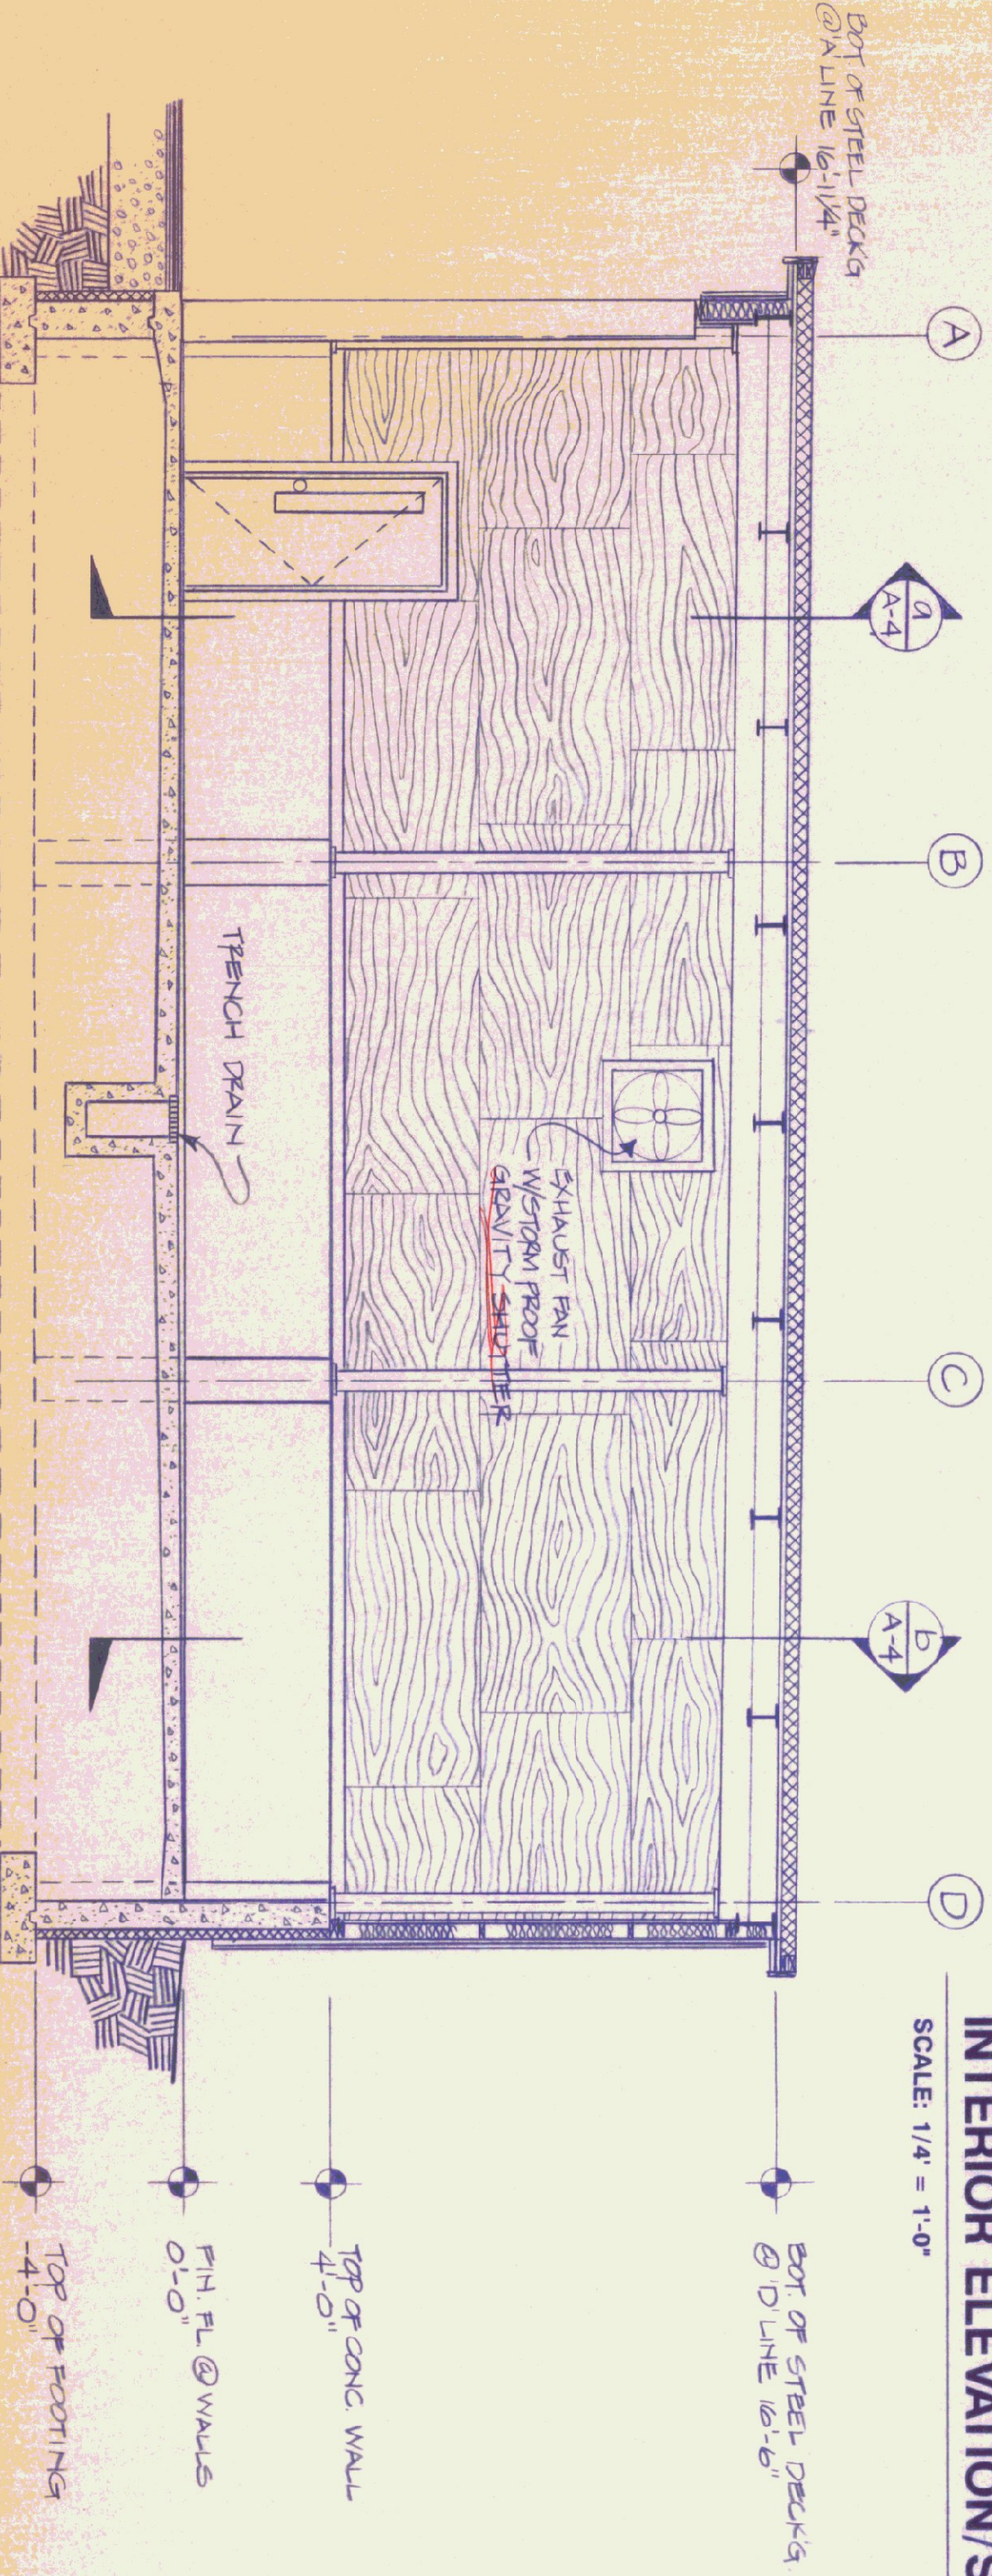

INTERIOR ELEVATION/SECTION (LOOKING TOWARD # 1 COL. LINE)  
SCALE: 1/4" = 1'-0"

STATE OF VERMONT DEPARTMENT OF STATE BUILDINGS AGENCY OF ADMINISTRATION MONTPELIER, VERMONT		STATE OF VERMONT DEPARTMENT OF TRANSPORTATION VERMONT AGENCY OF TRANSPORTATION 5 BAY MAINTENANCE GARAGE ENOSBURG FALLS, VERMONT	
DATE MAY 20, 1991	SCALE 1/4" = 1'-0"	REVISIONS:	DWG. NO. A-4
DRAWN BY: A. POULIN	APPROVED BY:		8 OF 24