



SHED PLAN
SCALE 1/8" = 1'-0"


VOID THIS PAGE

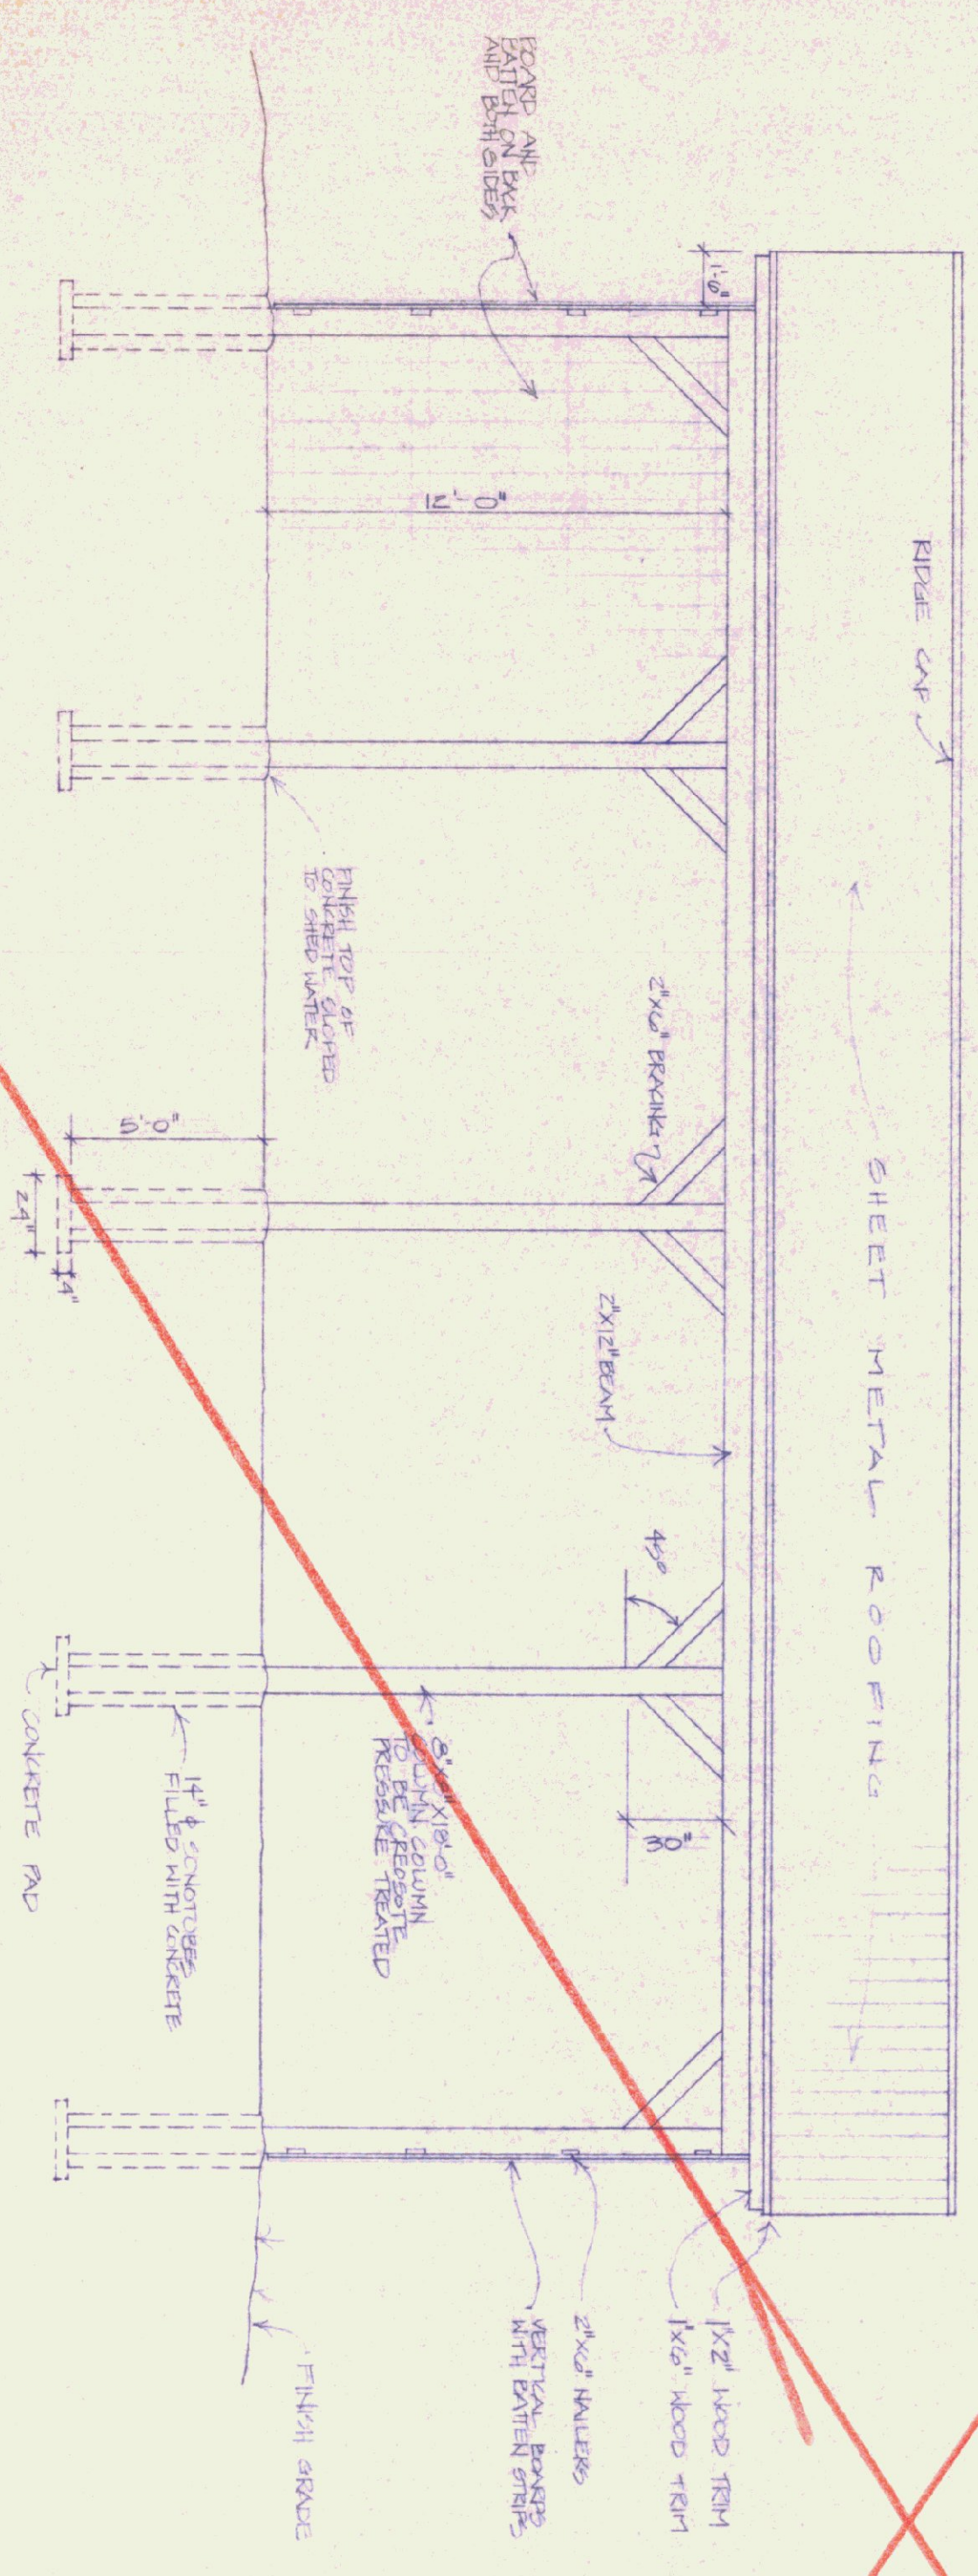

SHED ELEVATION
SCALE 1/8" = 1'-0"

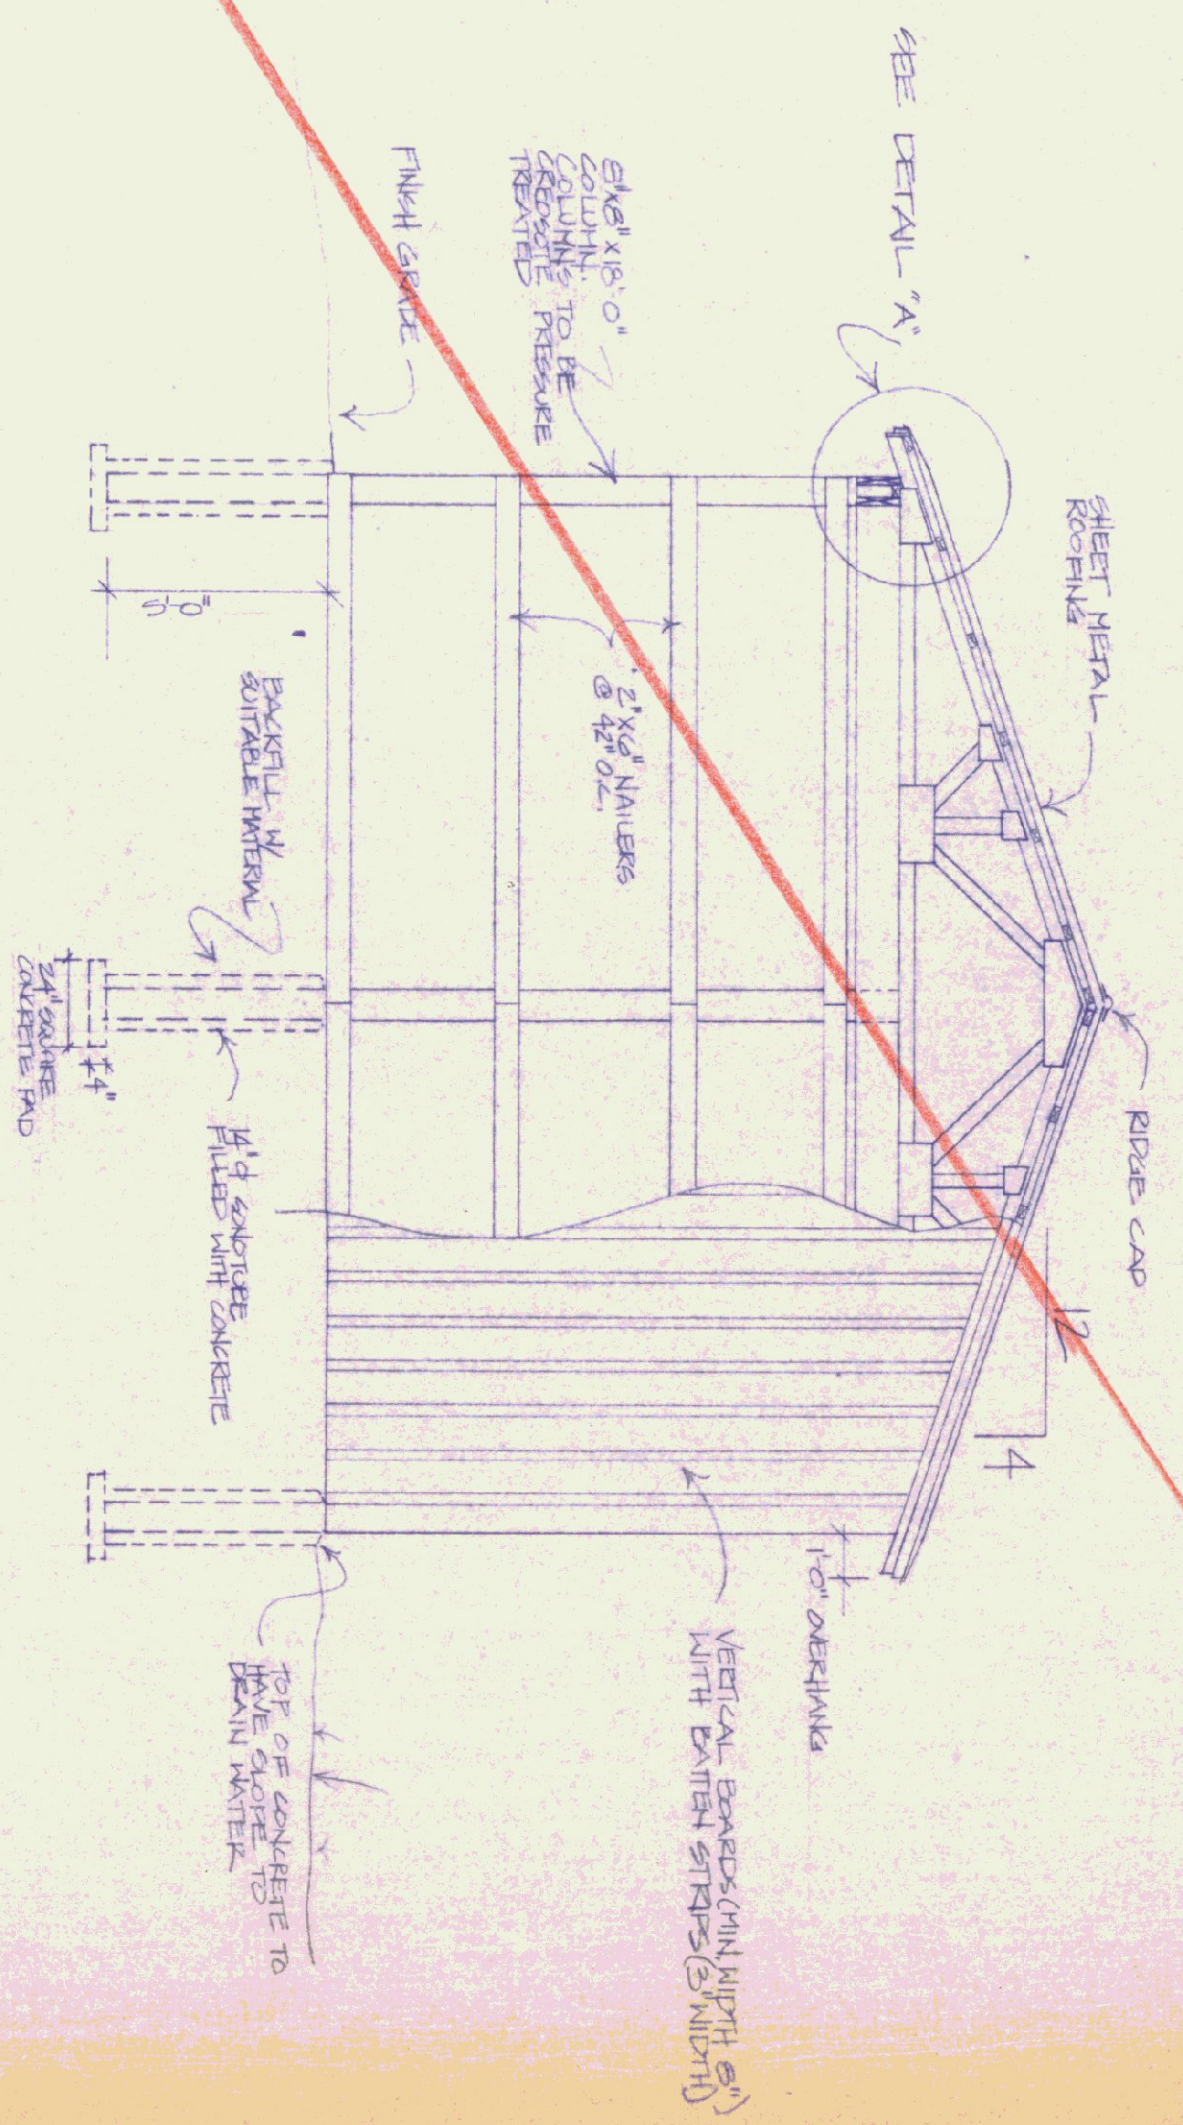

END ELEVATION
SCALE 1/8" = 1'-0"

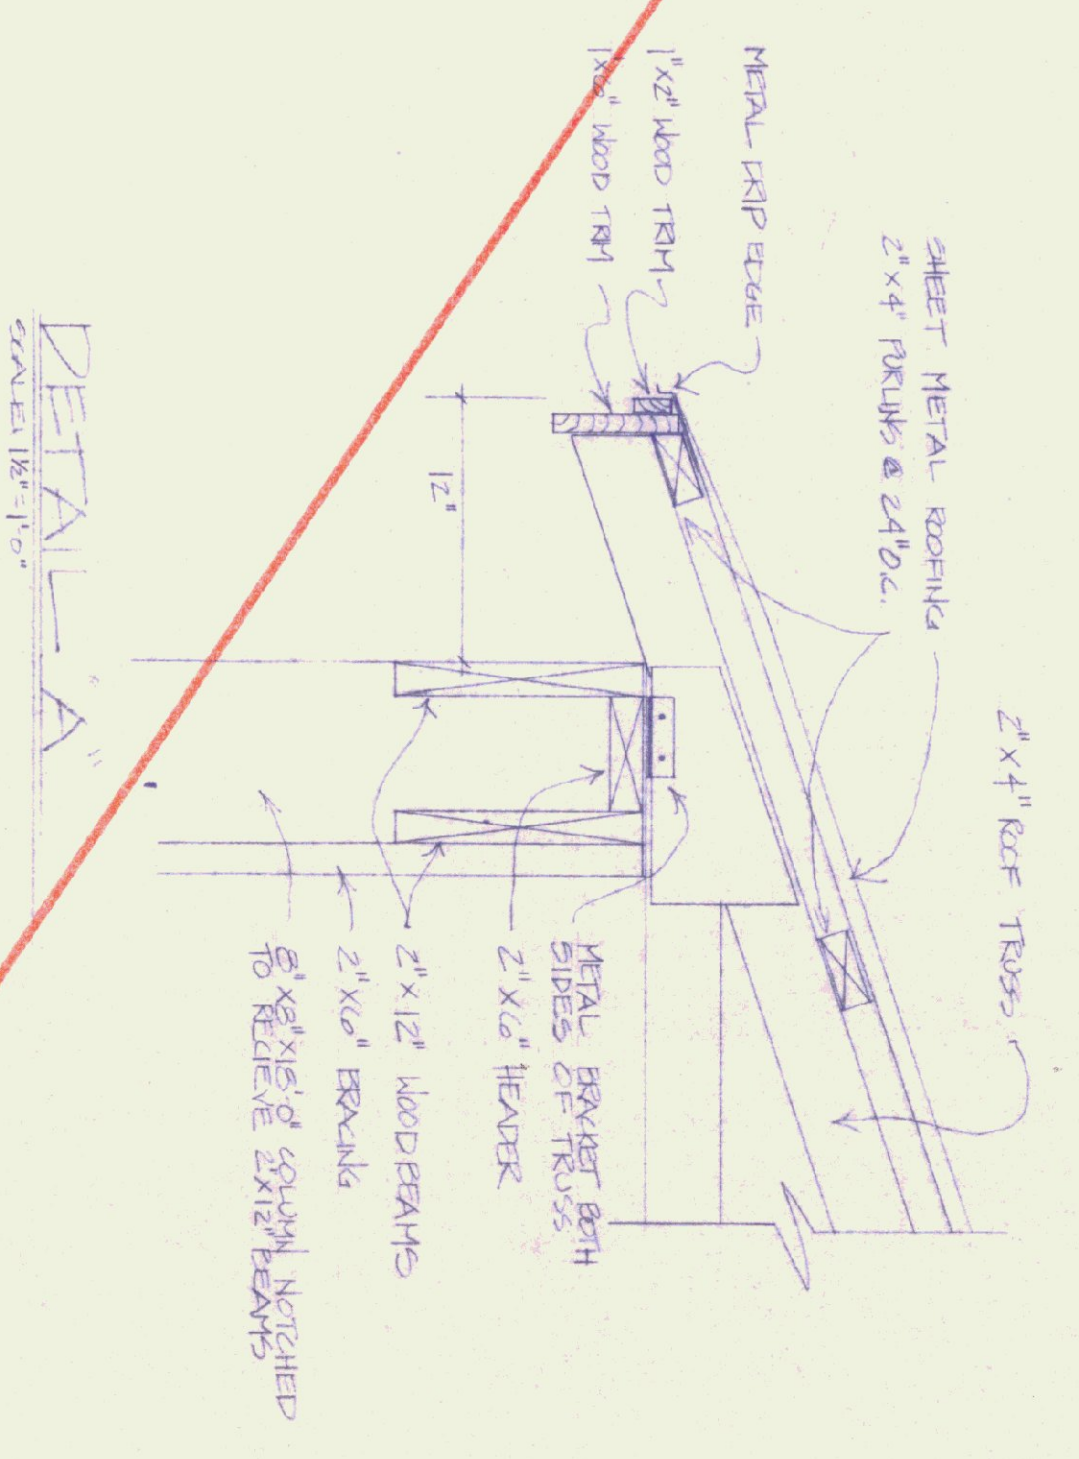

DETAIL 'A'

TYPICAL OF TWO

STATE OF VERMONT DEPARTMENT OF STATE BUILDINGS AGENCY OF ADMINISTRATION MONTPELIER, VERMONT		STATE OF VERMONT DEPARTMENT OF STATE BUILDINGS AGENCY OF ADMINISTRATION MONTPELIER, VERMONT	
STORAGE SHED VERMONT AGENCY OF TRANSPORTATION 5 BAY MAINTENANCE GARAGE ENOSBURG FALLS, VERMONT		STORAGE SHED VERMONT AGENCY OF TRANSPORTATION 5 BAY MAINTENANCE GARAGE ENOSBURG FALLS, VERMONT	
DATE: MAY 20, 1991	SCALE: AS NOTED	REVISIONS:	DWG. NO. A-8
DRAWN BY: K. HENDERSON	APPROVED BY: E. PRATT		12 OF 24