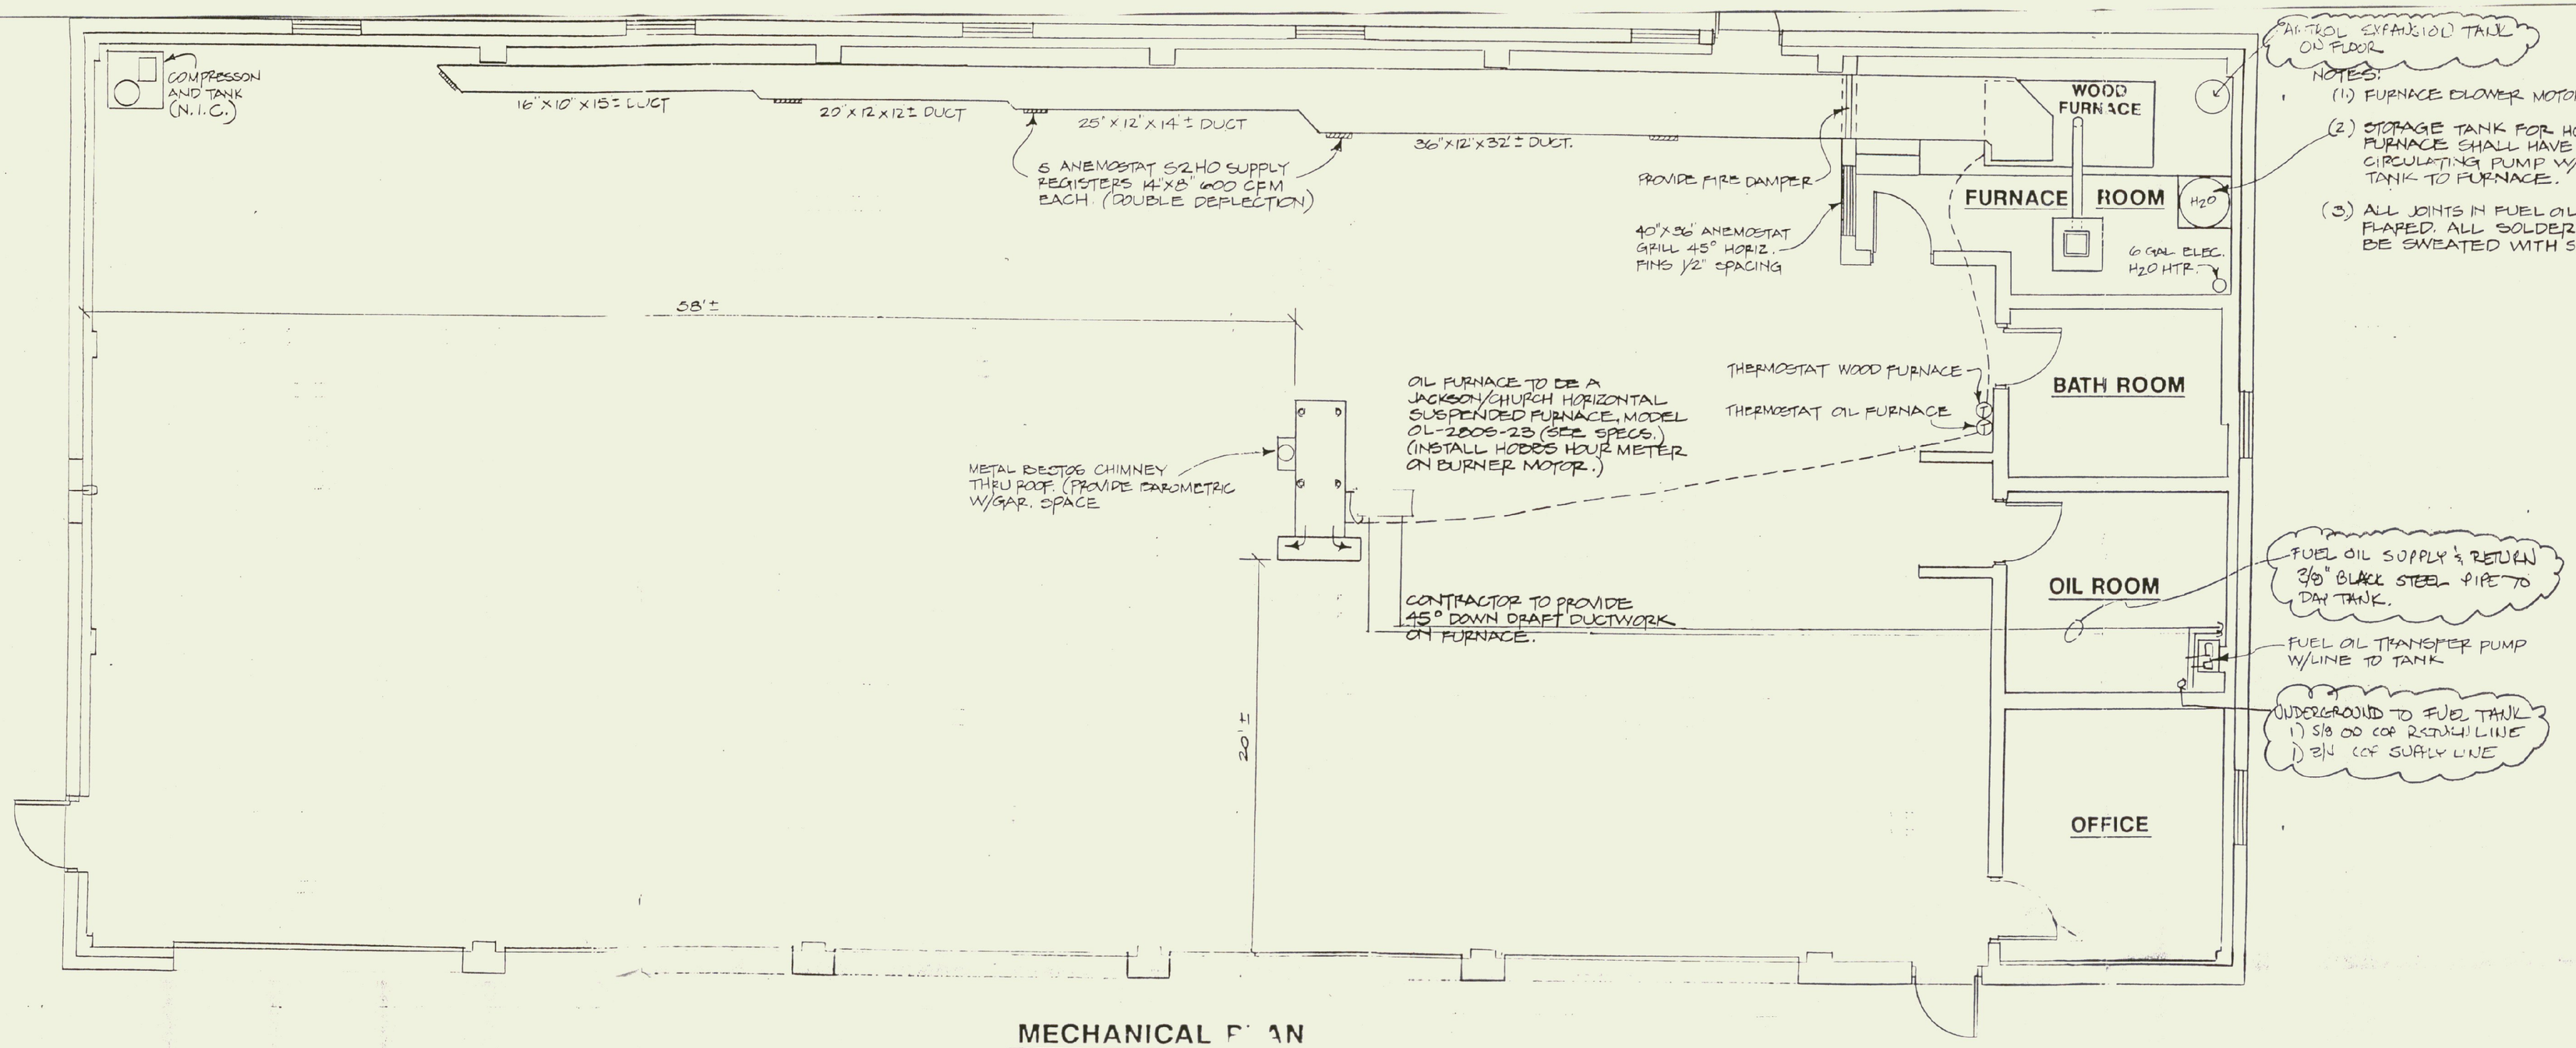

MECHANICAL PLAN

SCALE: 1/4" = 1'-0"

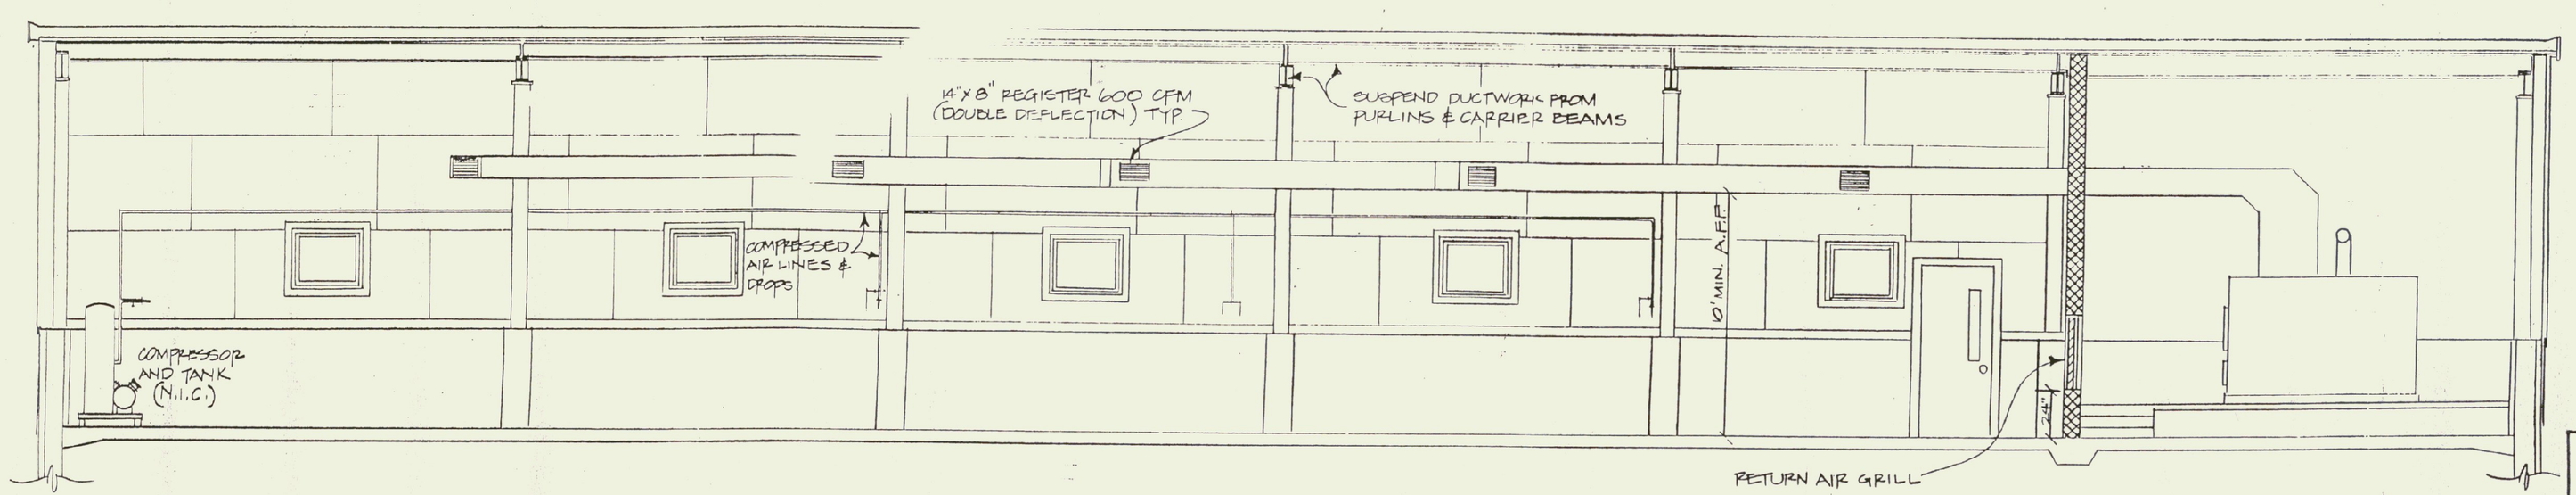

FURNACE & DUCTWORK ELEVATION

SCALE: 1/4" = 1'-0"

AS BUILT

STATE OF VERMONT
DEPARTMENT OF STATE BUILDINGS
AGENCY OF ADMINISTRATION
MONTPELIER. VERMONT

HEATING PLAN

VERMONT AGENCY OF TRANSPORTATION
5 BAY MAINTENANCE GARAGE
ENOSBURG FALLS, VERMONT

DATE: MAY 20, 1991	SCALE: 1/4' = 1'-0"	REVISIONS:	DWG. NO. H-1
DRAWN BY: A. POULIN	APPROVED BY:		21 OF 24