



PROPOSED ADDITION

EXISTING FACILITIES

PLAN
SCALE 1/8" = 1'-0"

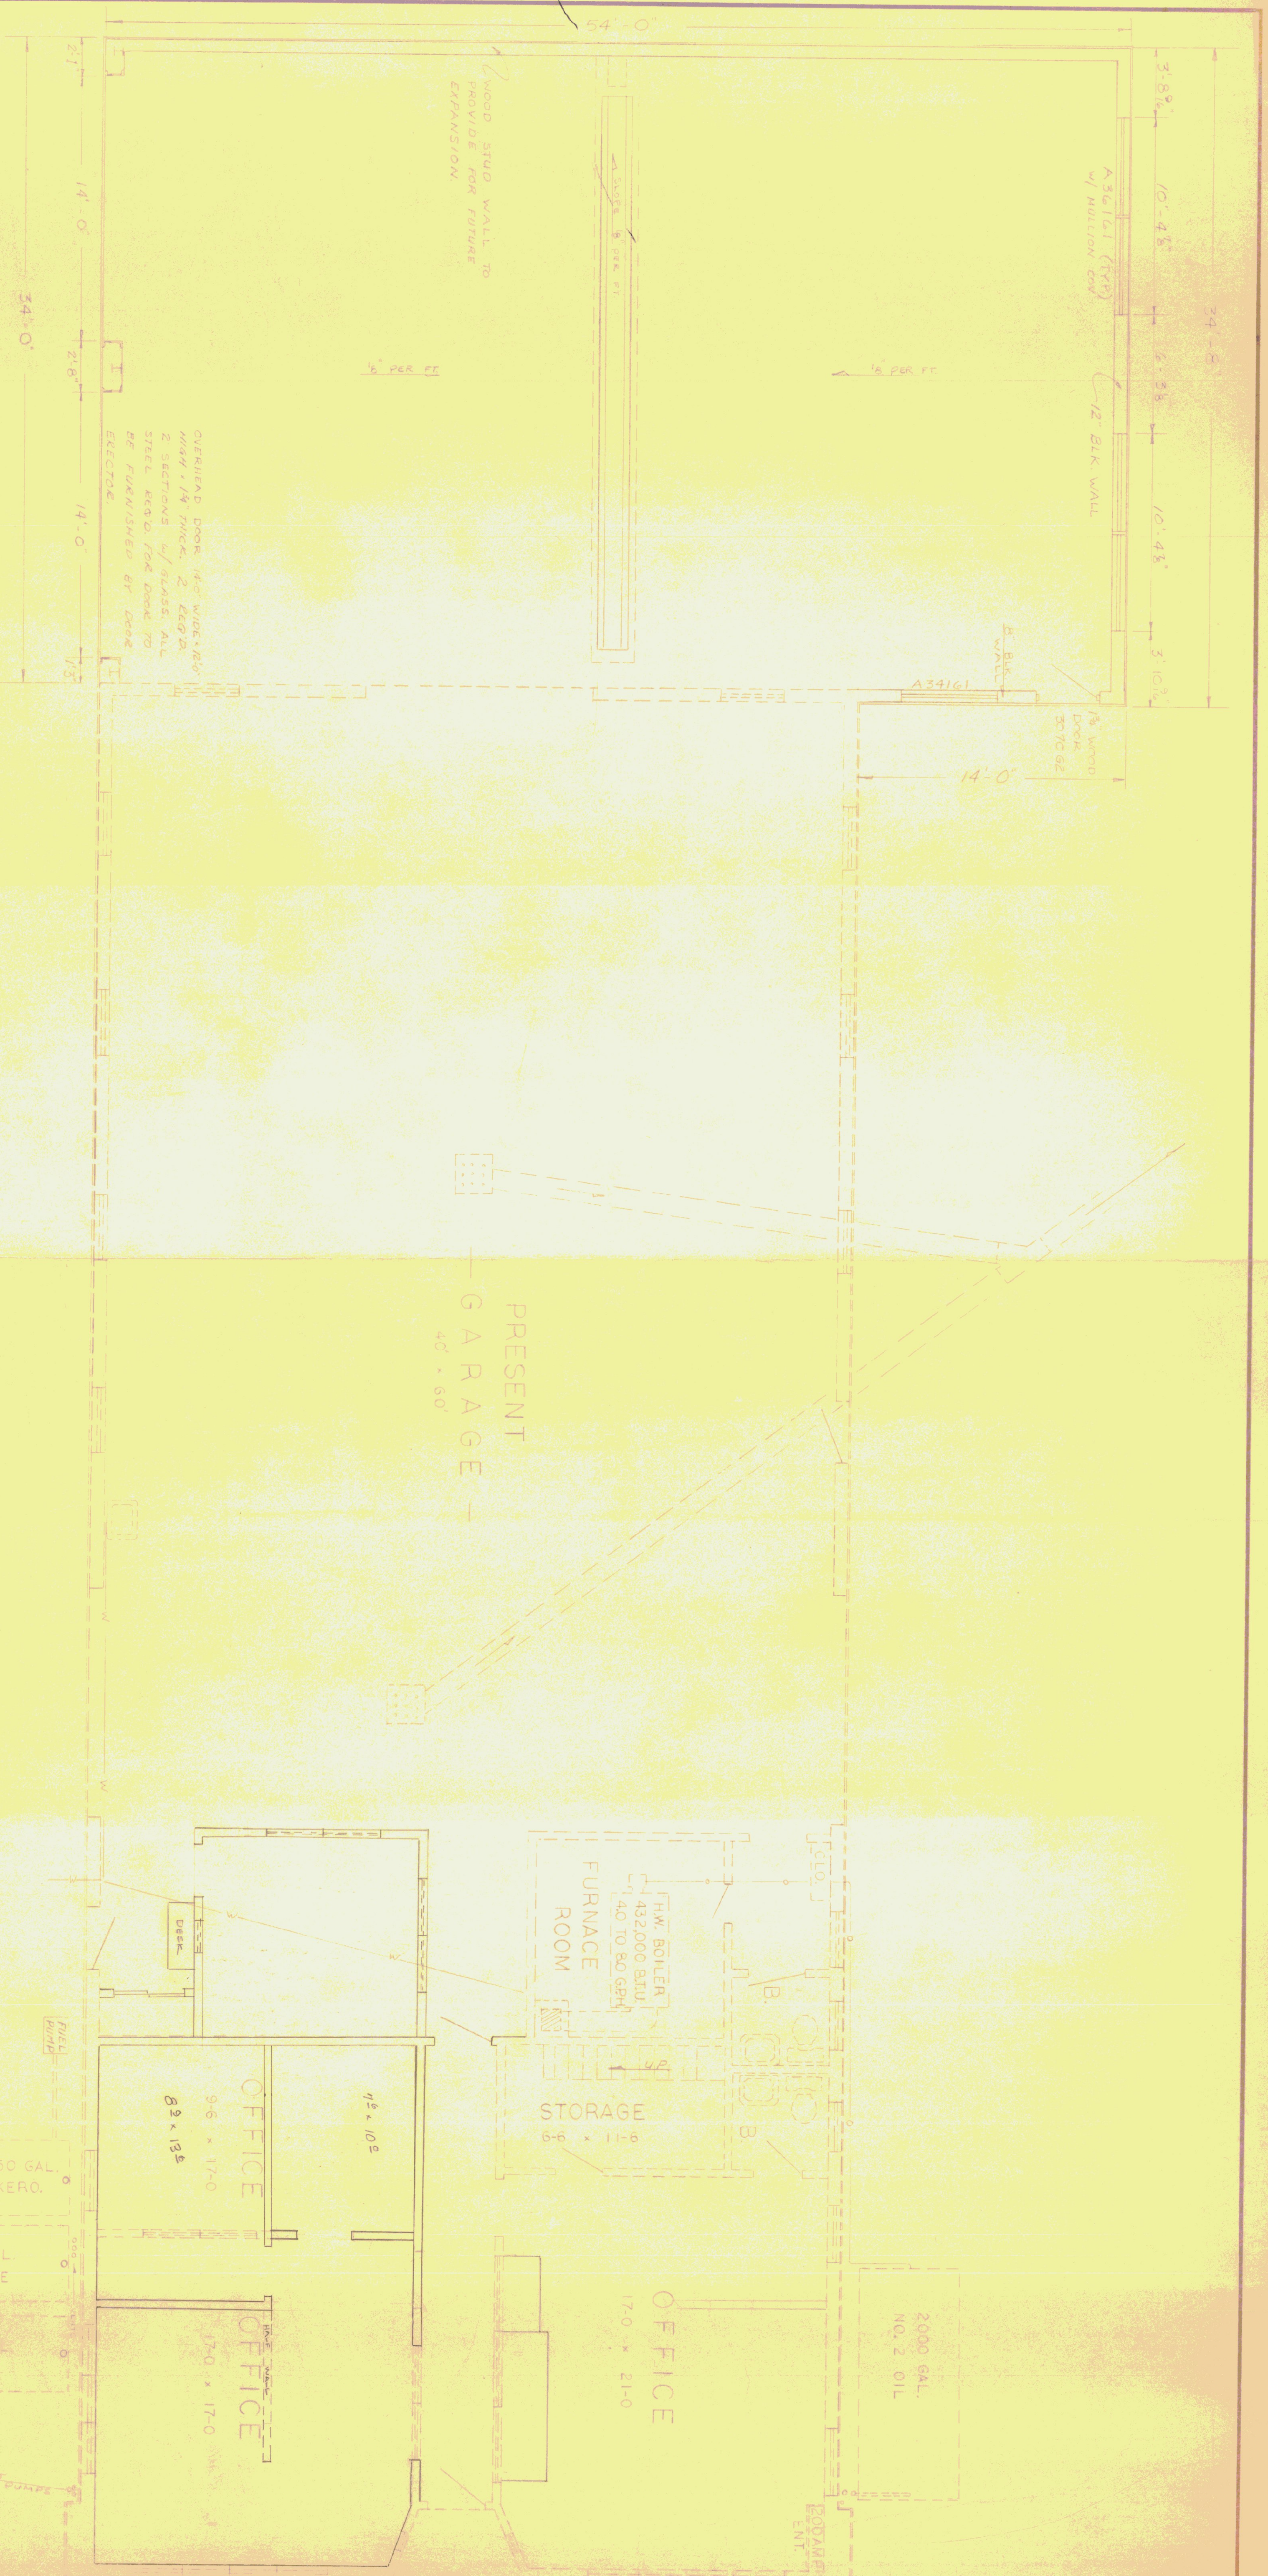

PRESENT GARAGE
40' x 60'

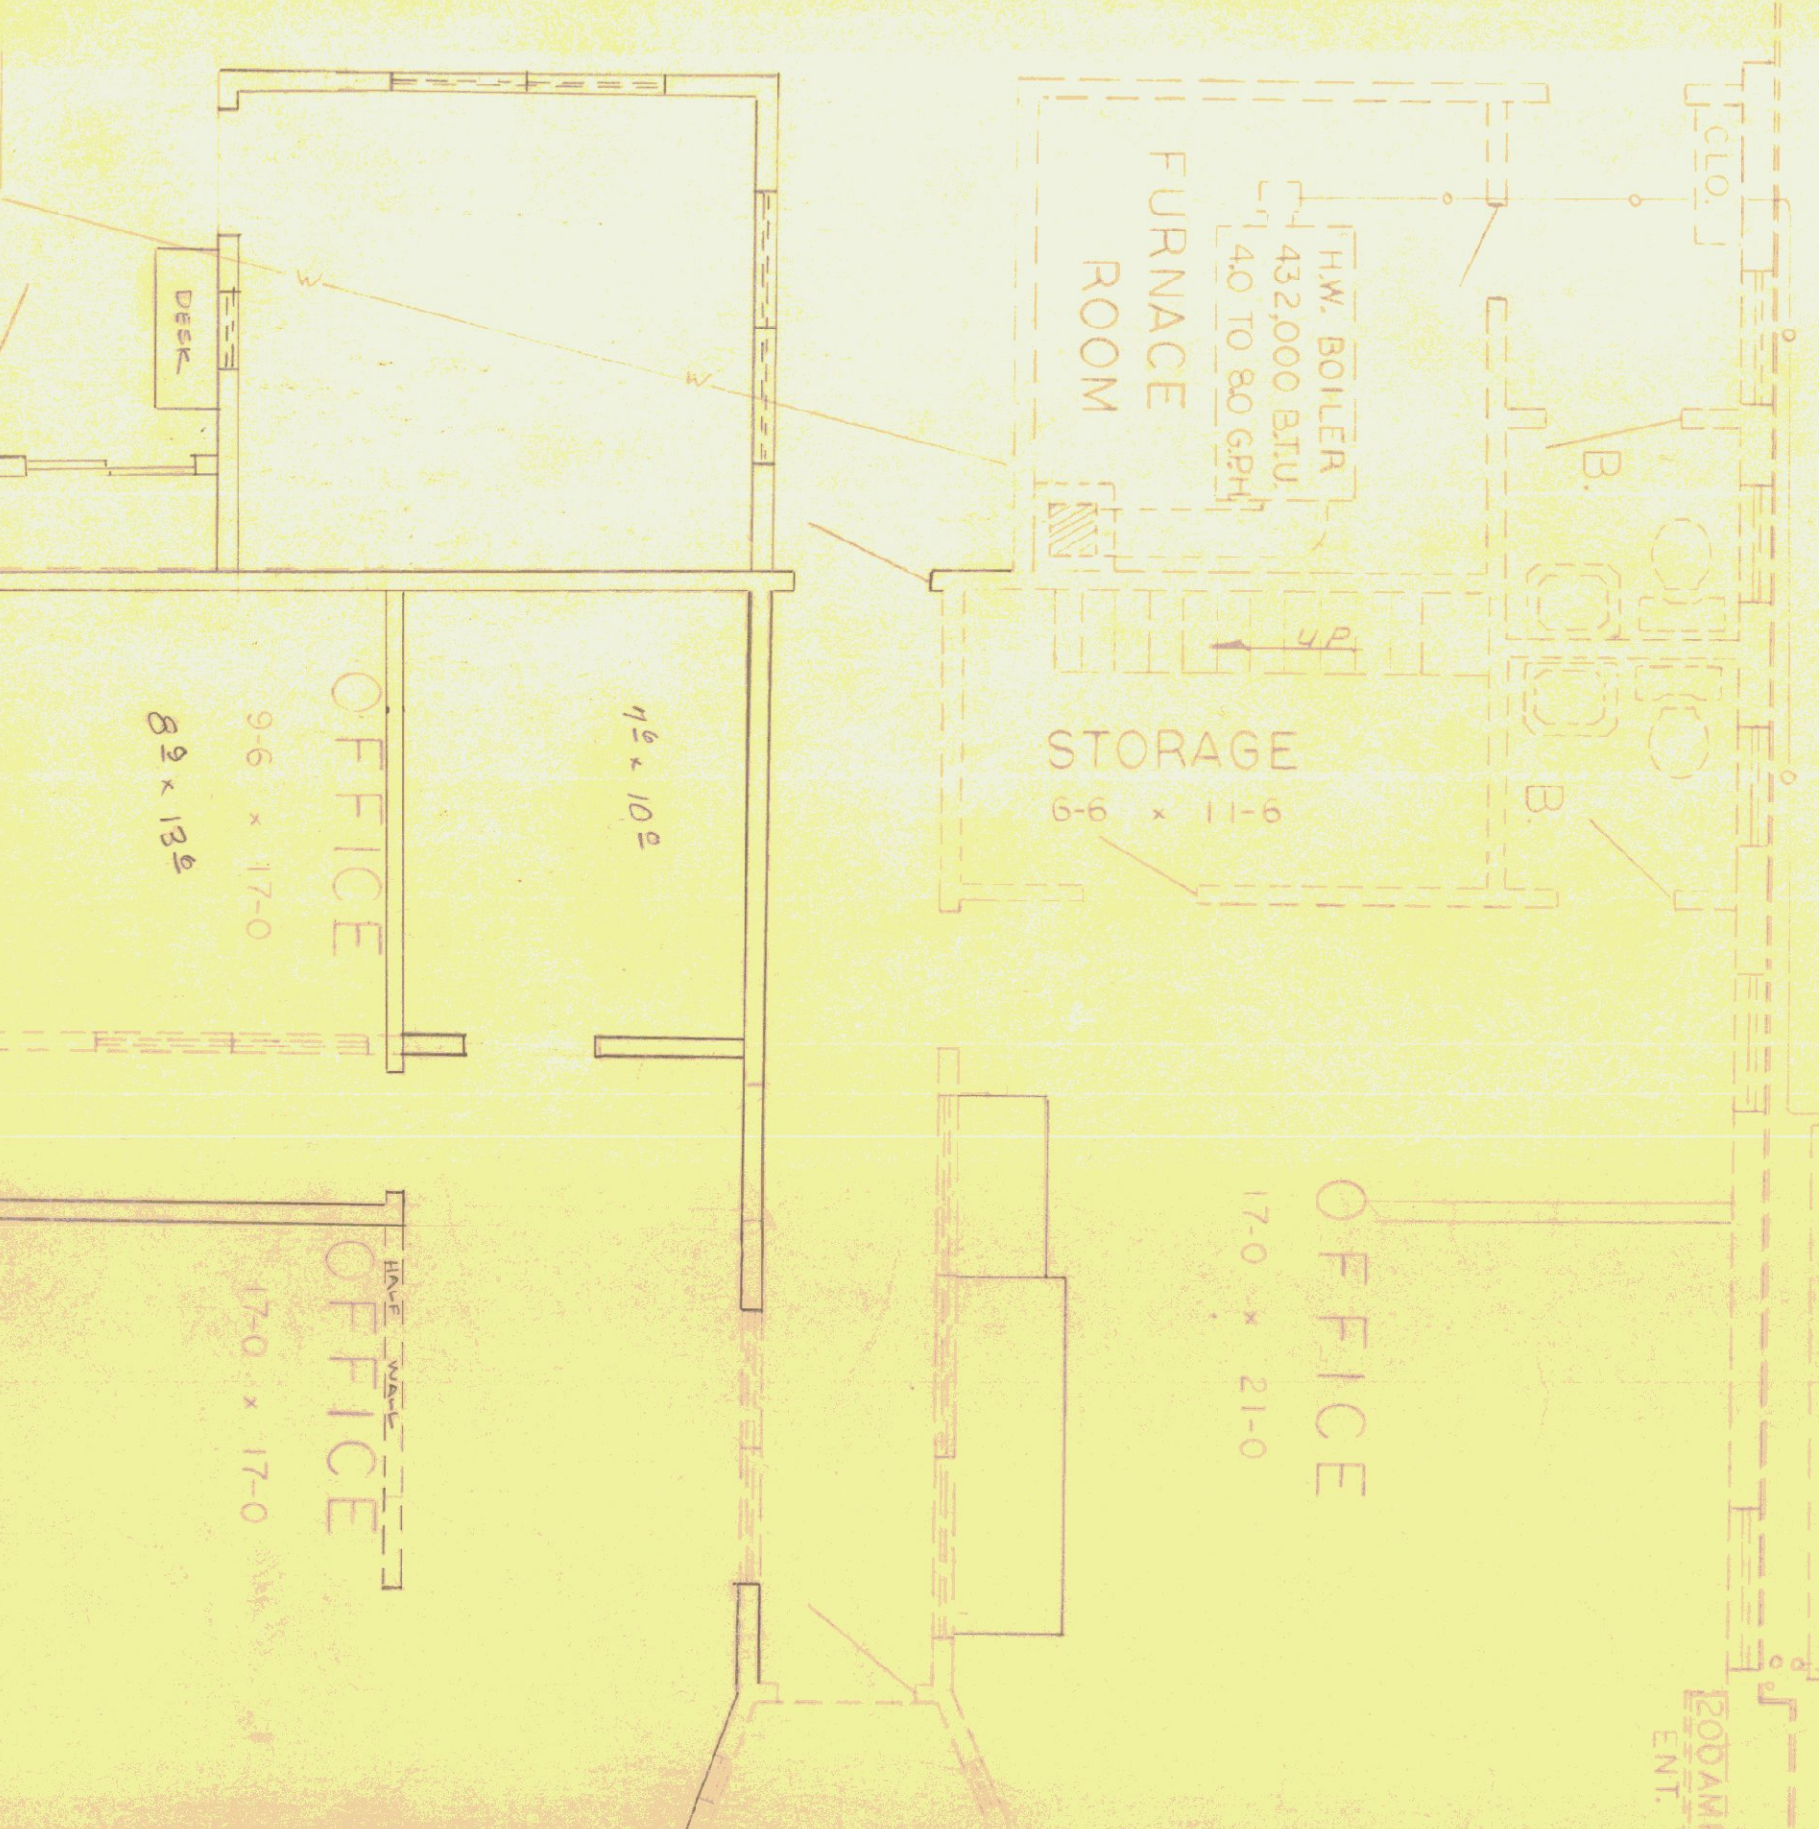

STATE OF VERMONT
DEPT. OF HIGHWAYS
DISTRICT # 9
PROPOSED GARAGE ADDITION
E.P. BOUND, DIST. ENGR.
174 SASSSETT AVE.