
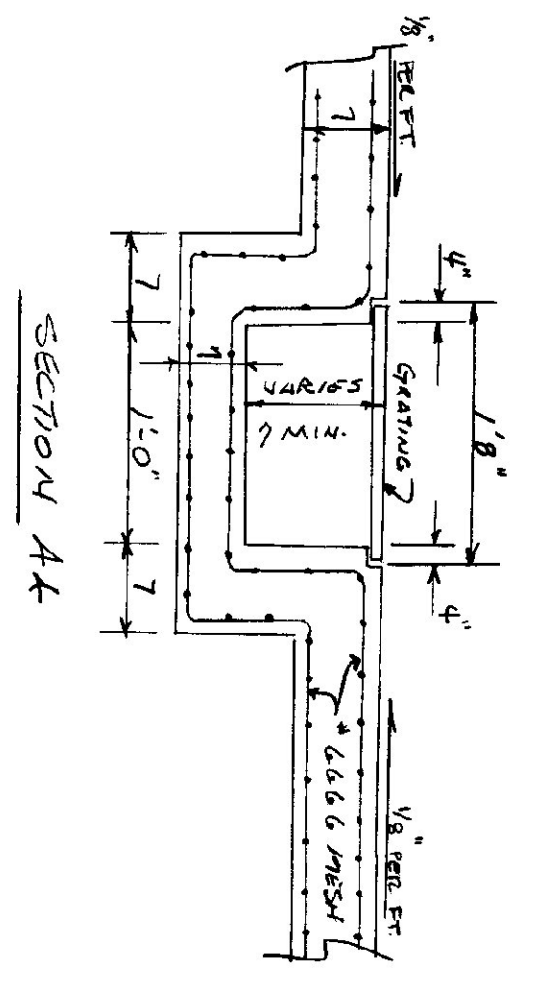


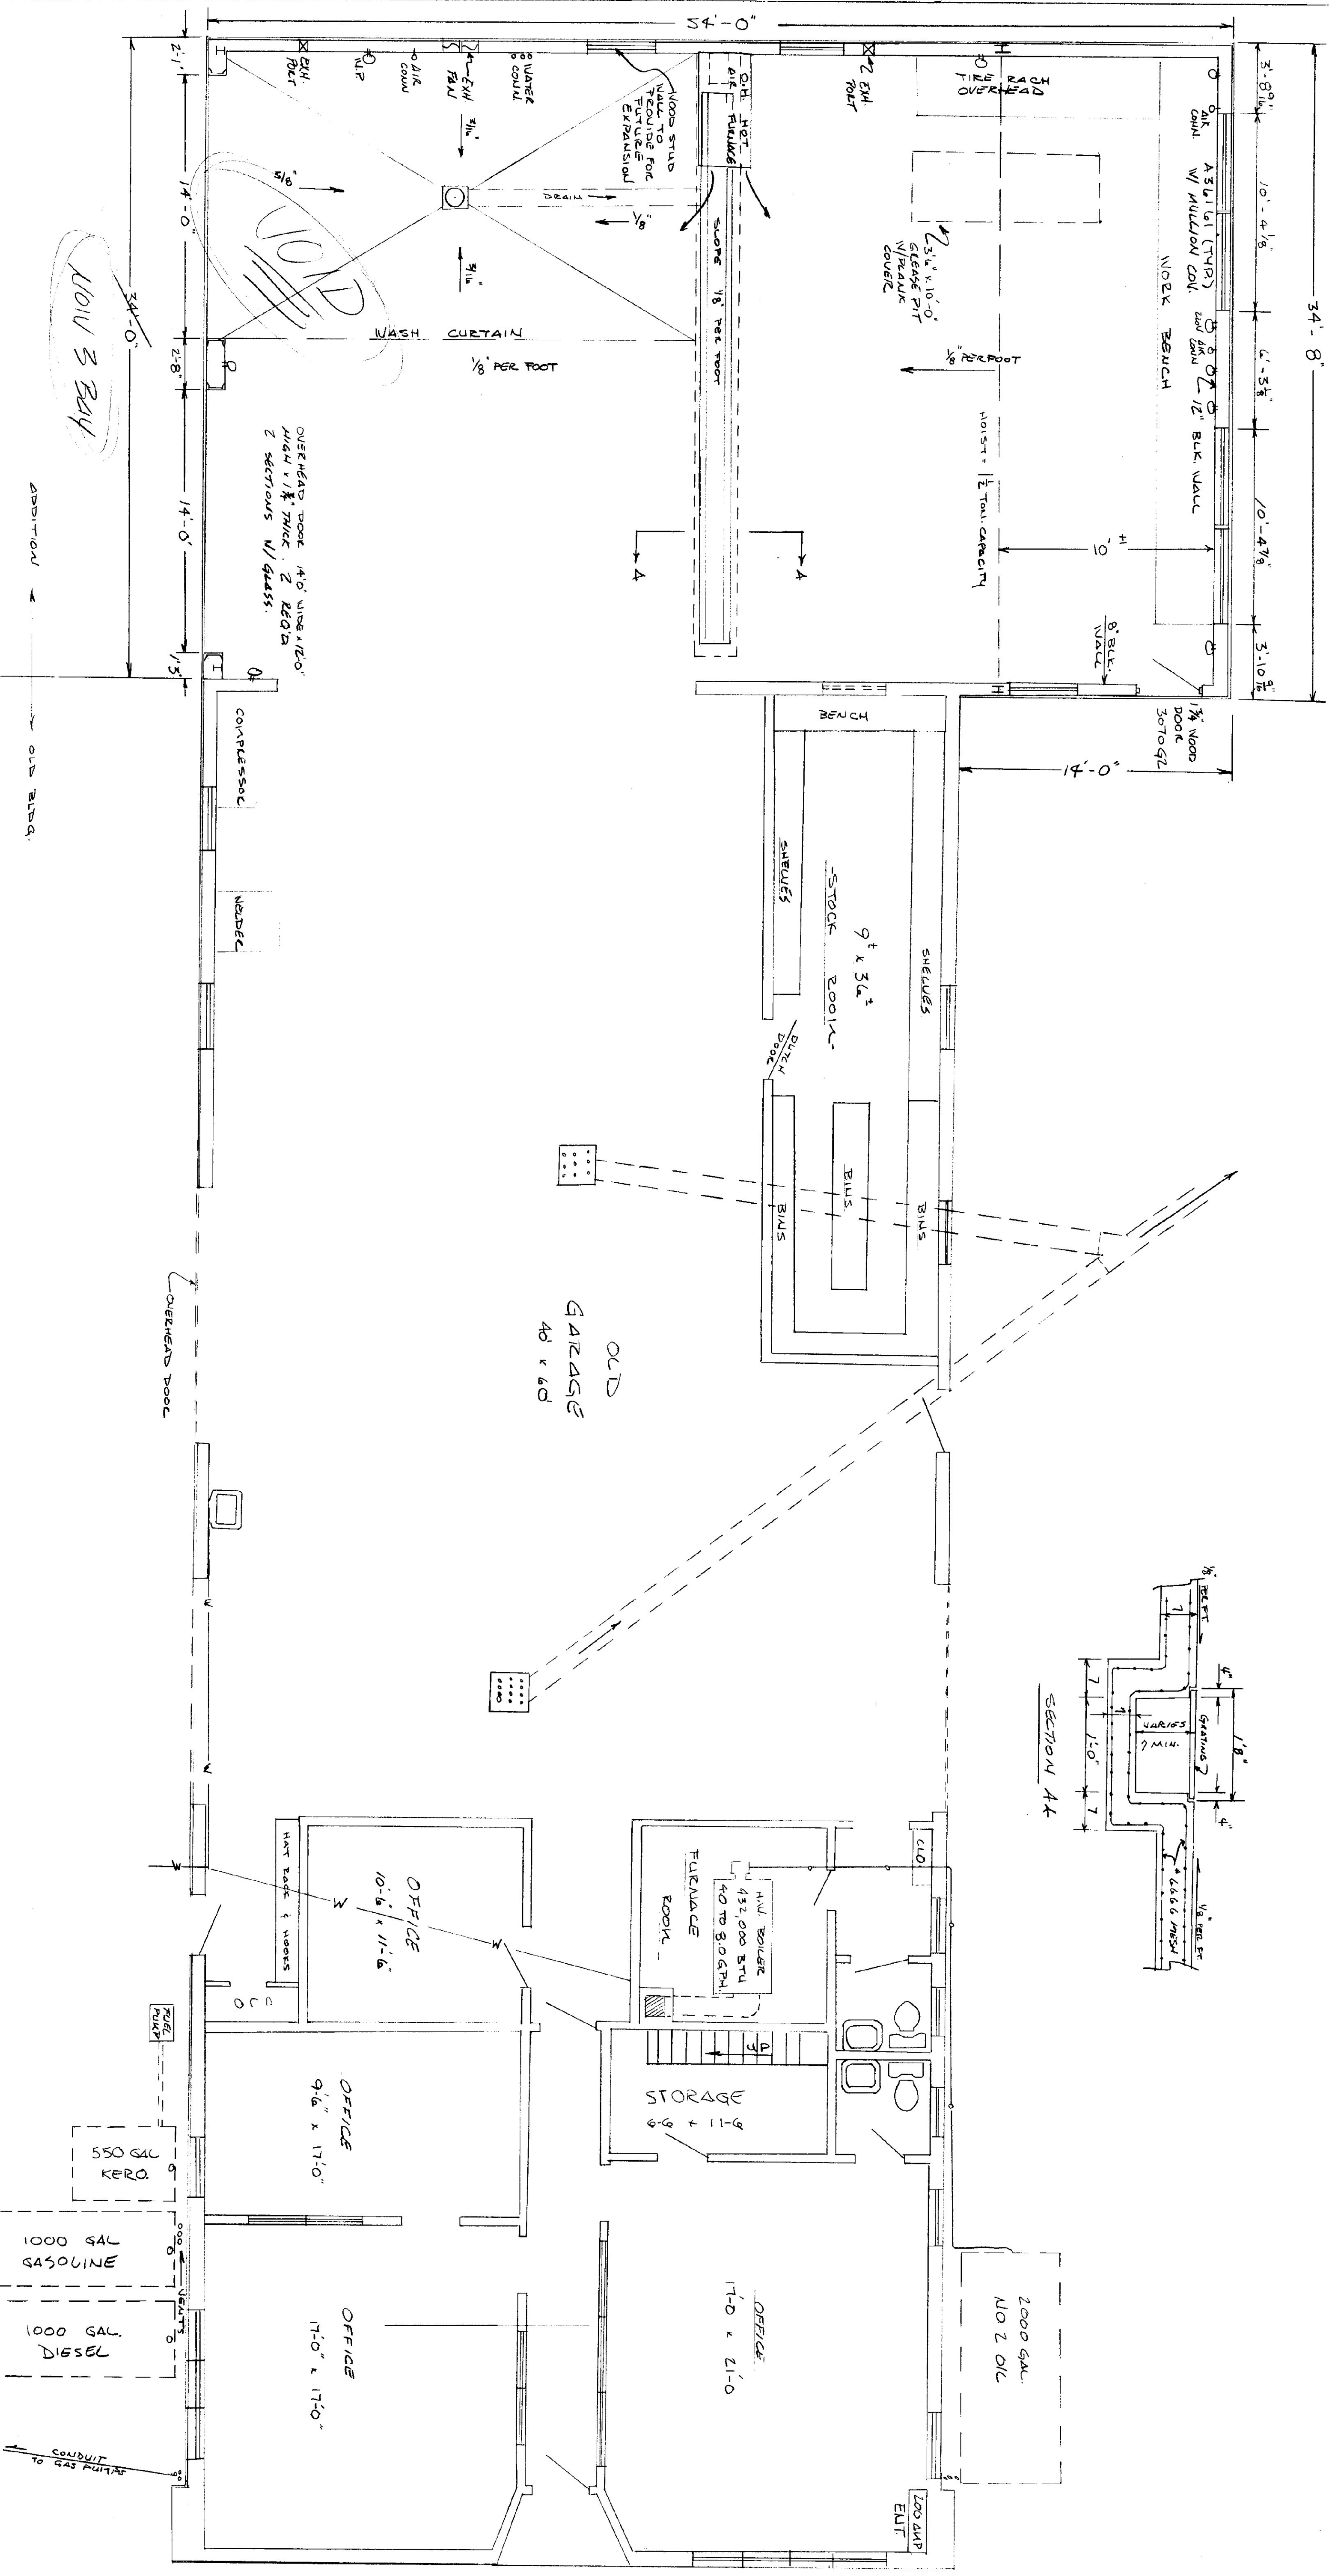

P L A N
SCALE 1/4" = 1'-0"

STATE OF VERMONT
DIVISION OF STATE BUILDINGS
AGENCY OF ADMINISTRATION
MONTPELIER, VERMONT

DEPT. OF HIGHWAYS
DISTRICT # 9
GARAGE ADDITION

DATE	SCALE	REVISIONS	DWG. NO.
APR. 1964	AS NOTED		1
DESIGNED BY	APPROVED BY		
DRAWN BY	CHECKED BY		