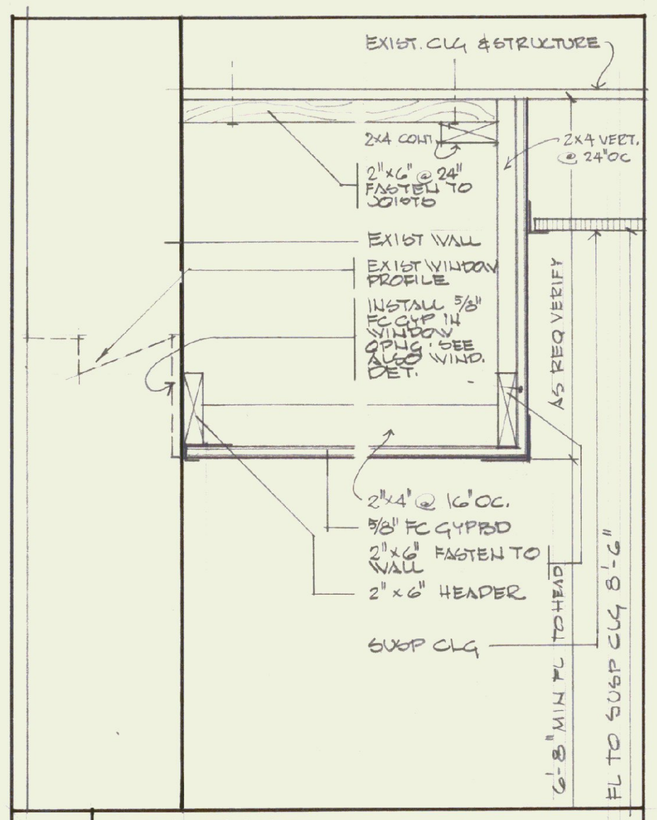

1 SOFFIT DET - UNDER STAIR
SCALE 1½" = 1'-0"

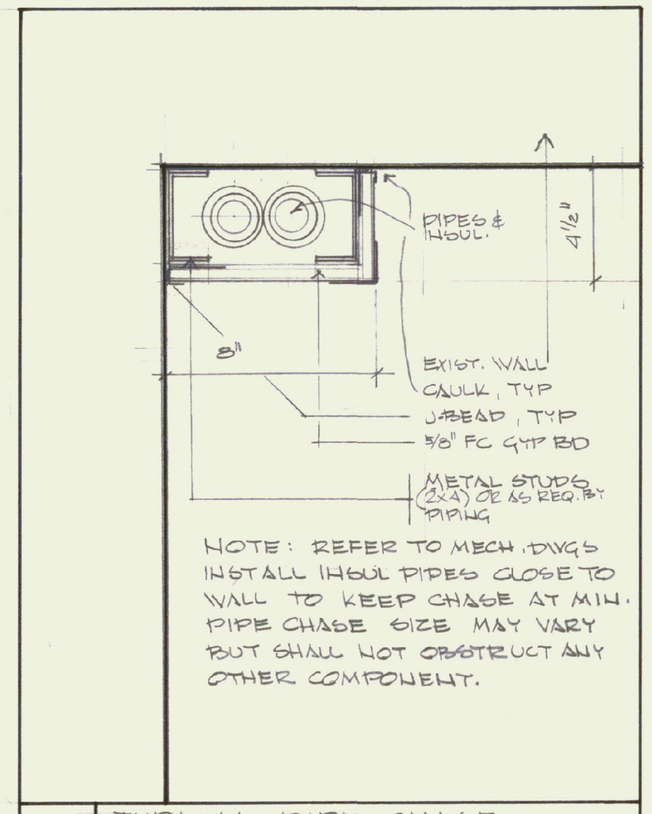

2 TYPICAL PIPE CHASE
SCALE 3" = 1'-0"

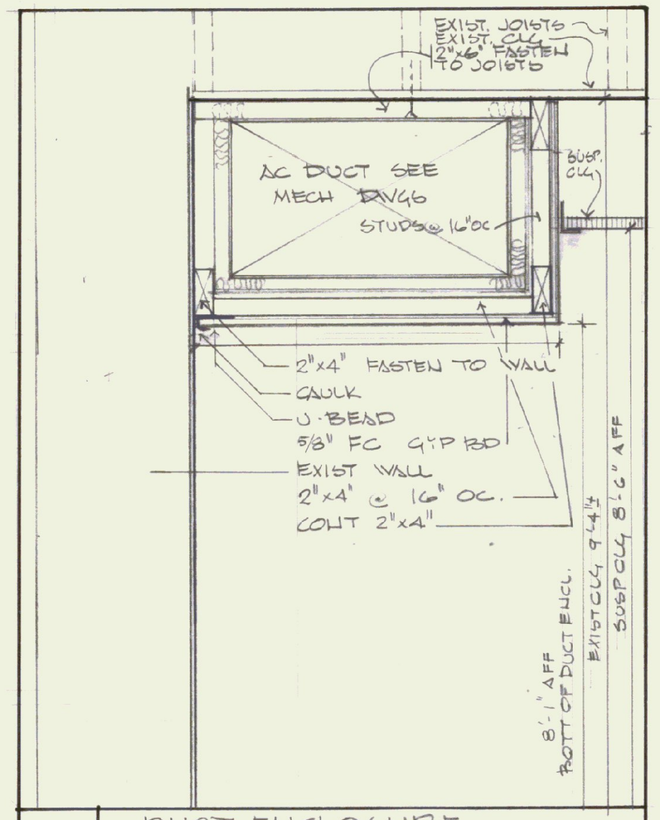

3 DUCT ENCLOSURE
SCALE 1½" = 1'-0"

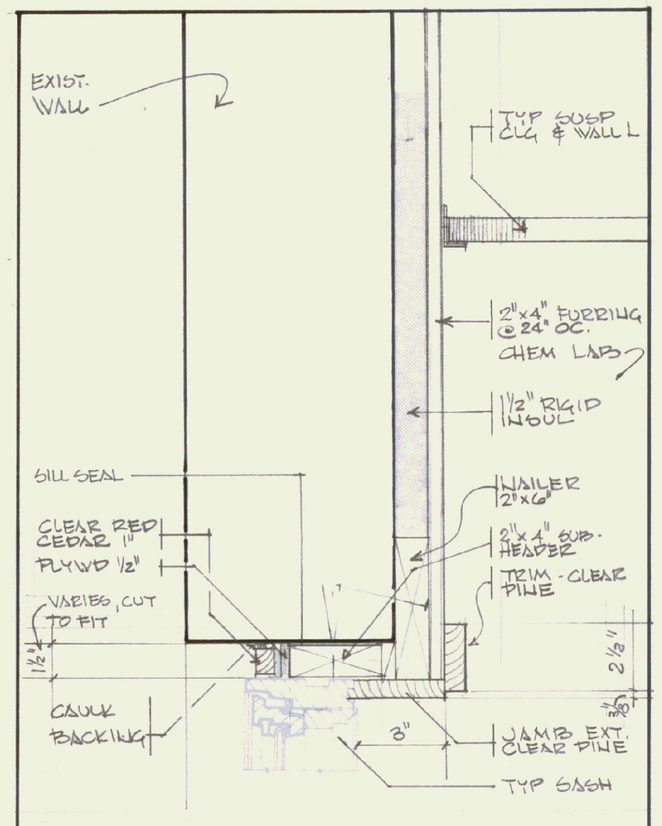

WINDOW - HEAD DET.

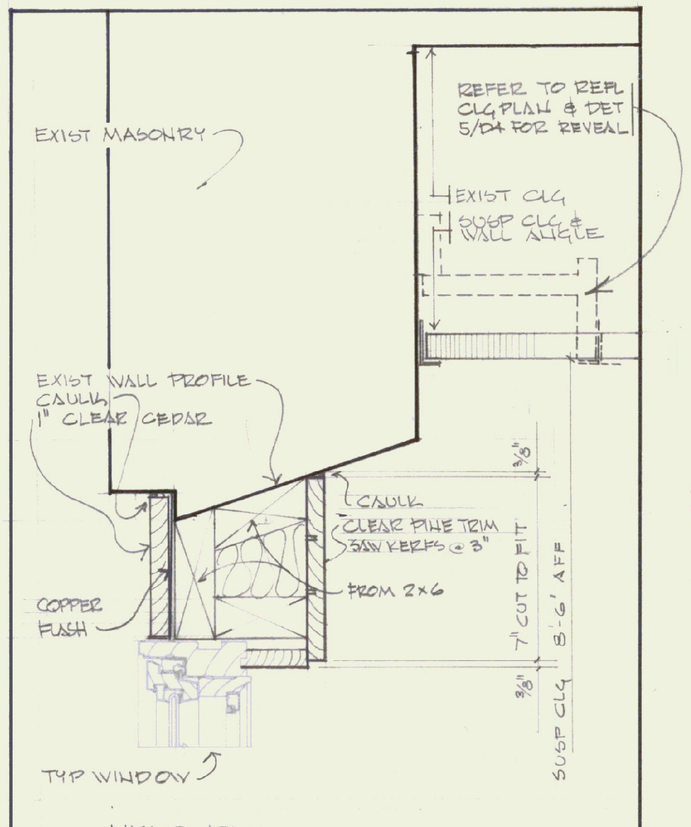

HEAD DET.

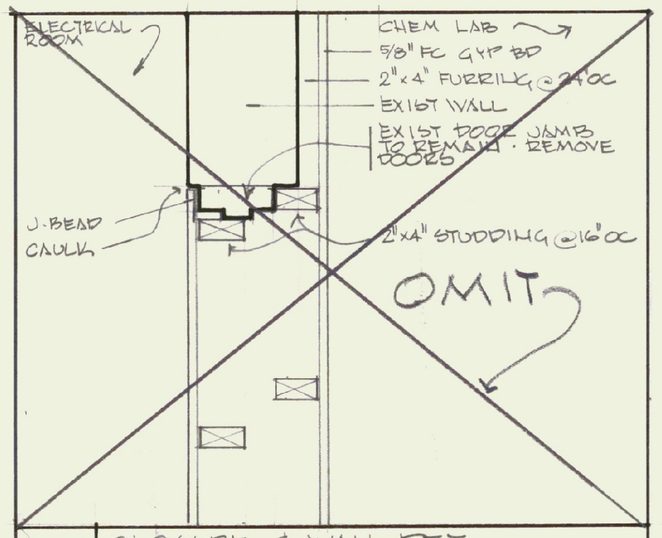

4 CLOSURE & WALL DET.
1½" = 1'-0"
OMIT

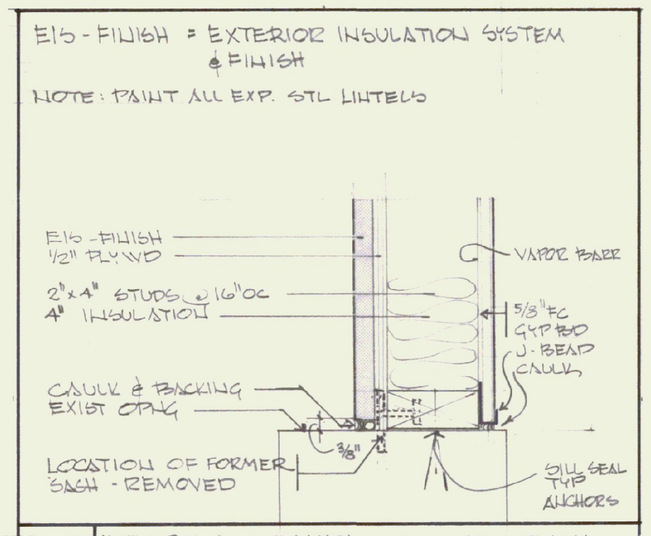

5 WINDOW CLOSURE, JAMB, HEAD SIM.
SCALE 3" = 1'-0"

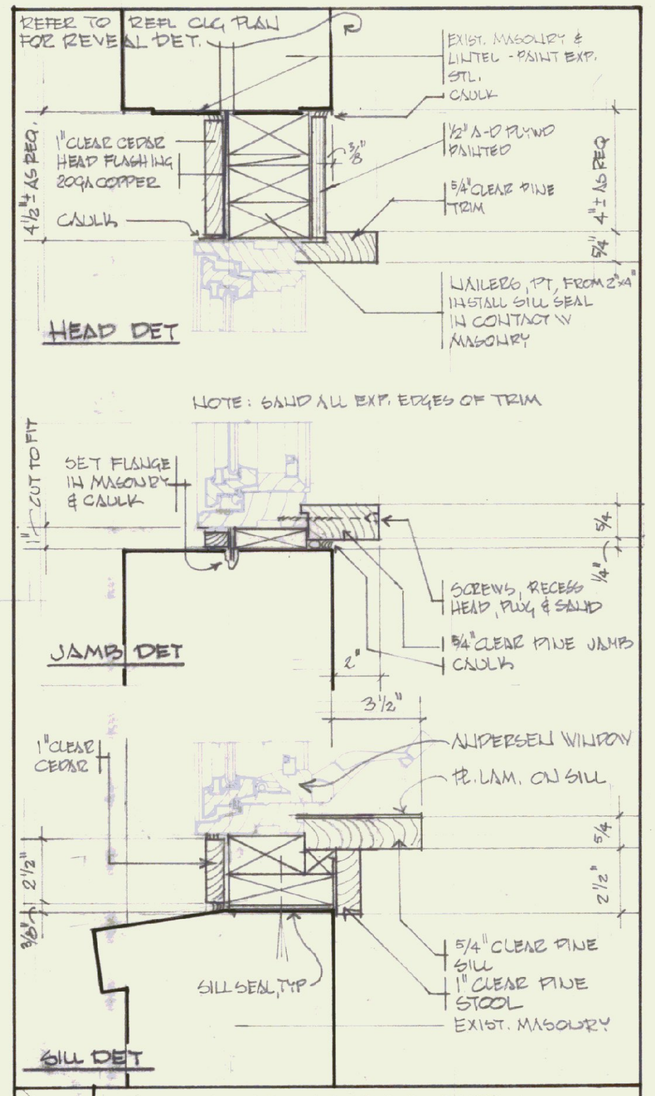

8 WINDOW REPLACEMENT TYPE B
3" = 1'-0"

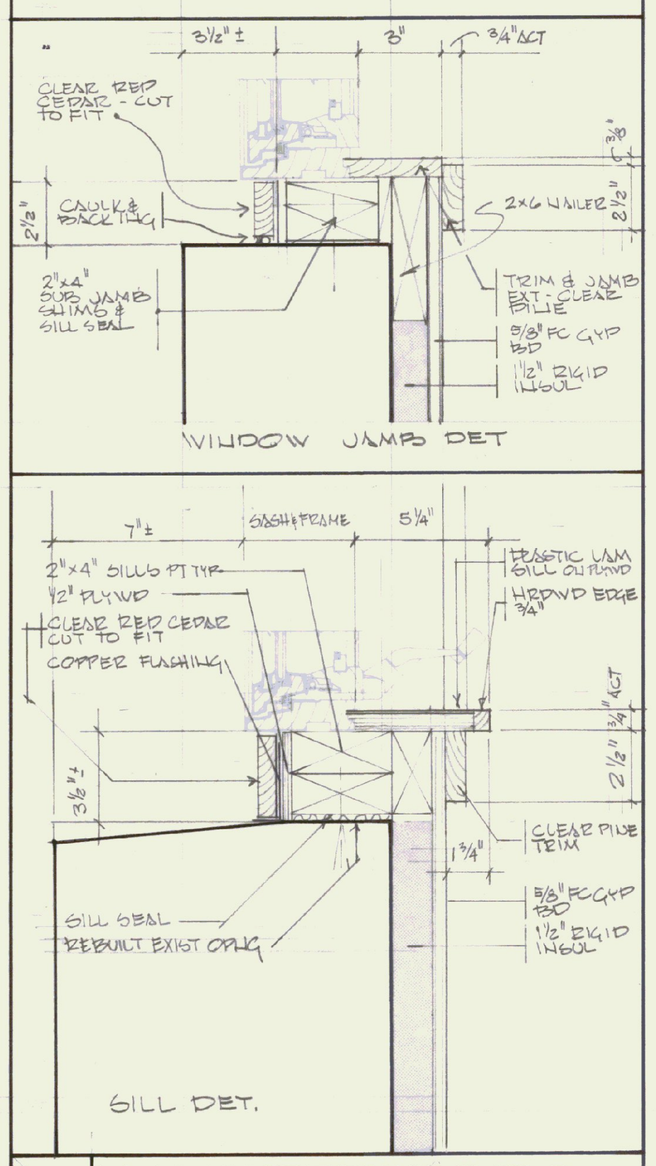

9 WINDOW REPLACEMT TYPE C
3" = 1'-0"

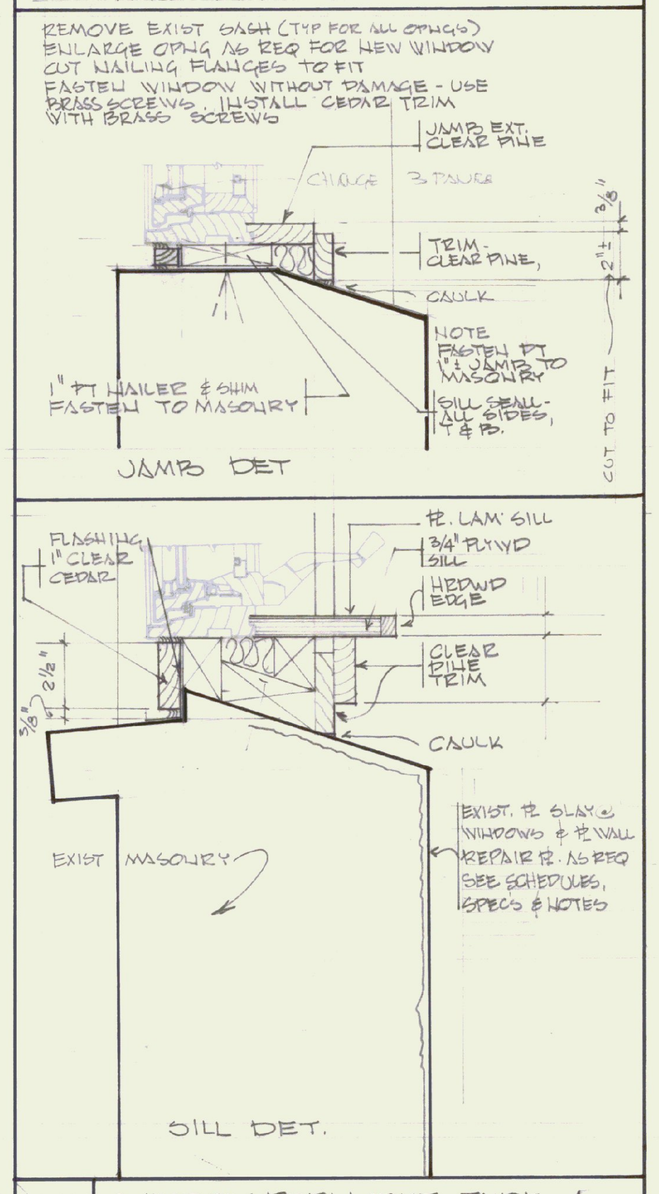

10 WINDOW REPLACEMT TYPE A
SCALE 3" = 1'-0"

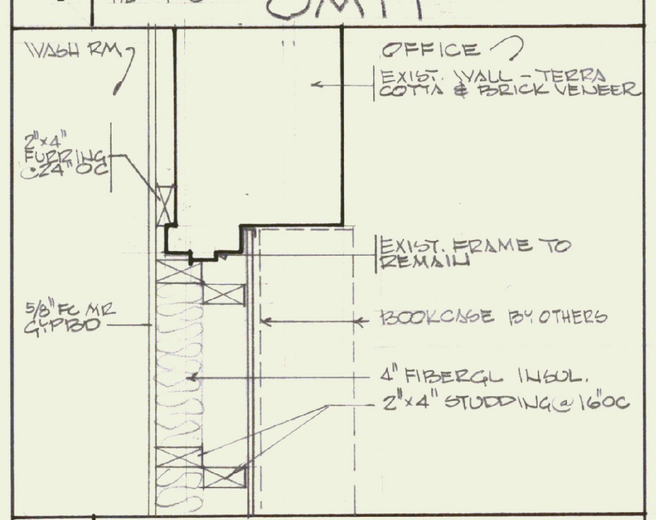

6 CLOSURE & WALL DET
1½" = 1'-0"

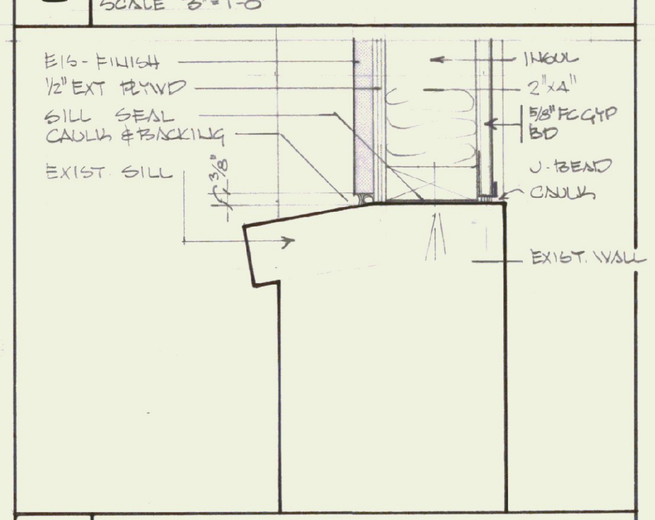

7 WINDOW CLOSURE
SCALE 3" = 1'-0"

6.14.90
OMIT DET #4

State of Vermont
Department of State Buildings

John Zampieri, Commissioner

Materials & Research Laboratory
Berlin, Vt.

PHASE II

REGISTERED ARCHITECT FRED KEIL NO. 515 STATE OF VERMONT

Janson Design, Inc.
FRED KEIL, ARCHITECT
P.O. BOX 55 – BOLTON ROAD, WATERBURY, VT 05676
(802) 244-5800

DETAILS

DATE: APRIL 20 1990

DWG. NO. D 2