




1 TYP RATED DOOR B-LABEL/90 MIN  
SCALE: 1/2" = 1'-0"

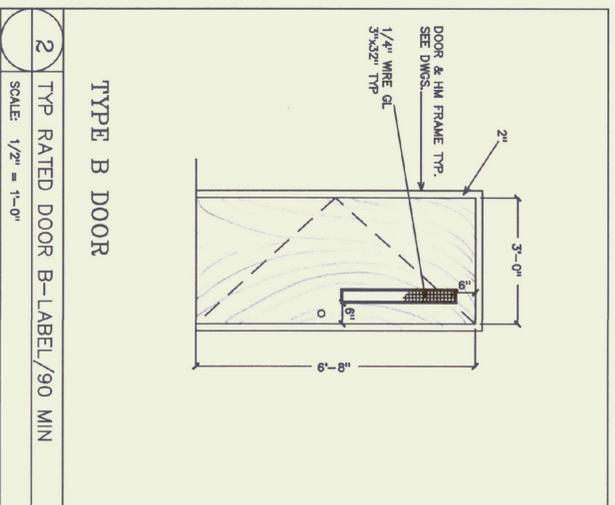


2 TYP RATED DOOR B-LABEL/90 MIN  
SCALE: 1/2" = 1'-0"

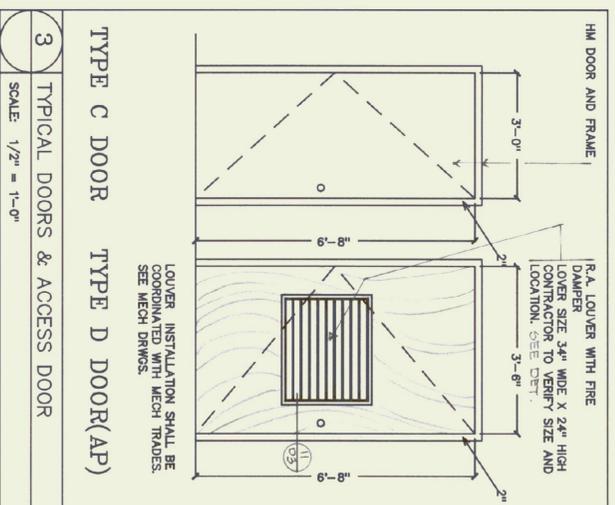


3 TYPICAL DOORS & ACCESS DOOR  
SCALE: 1/2" = 1'-0"

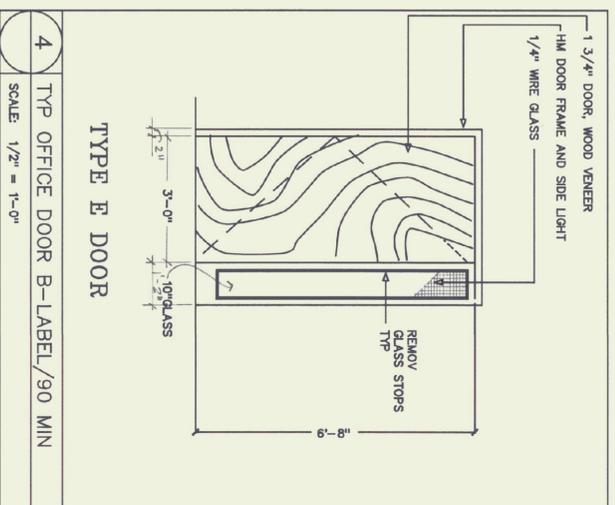


4 TYP OFFICE DOOR B-LABEL/90 MIN  
SCALE: 1/2" = 1'-0"

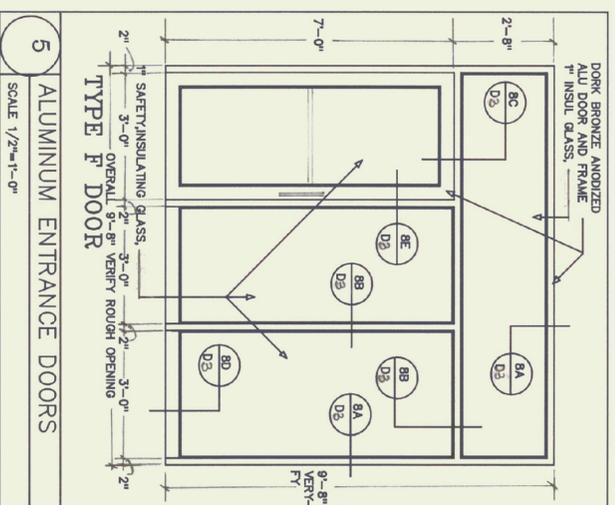


5 ALUMINUM ENTRANCE DOORS  
SCALE: 1/2" = 1'-0"

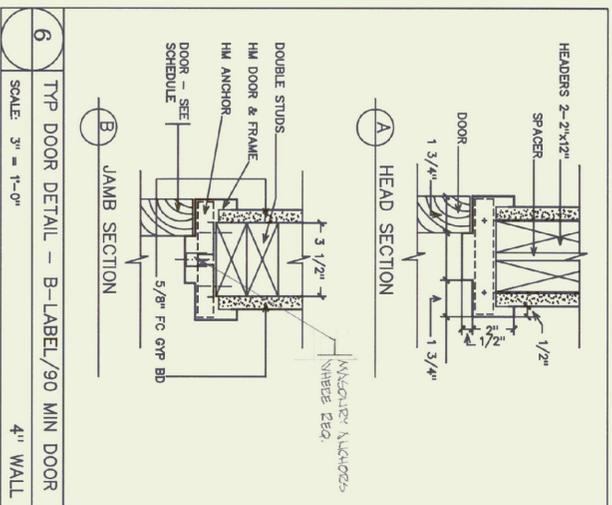


6 TYP DOOR DETAIL - B-LABEL/90 MIN DOOR  
SCALE: 3" = 1'-0" 4" WALL

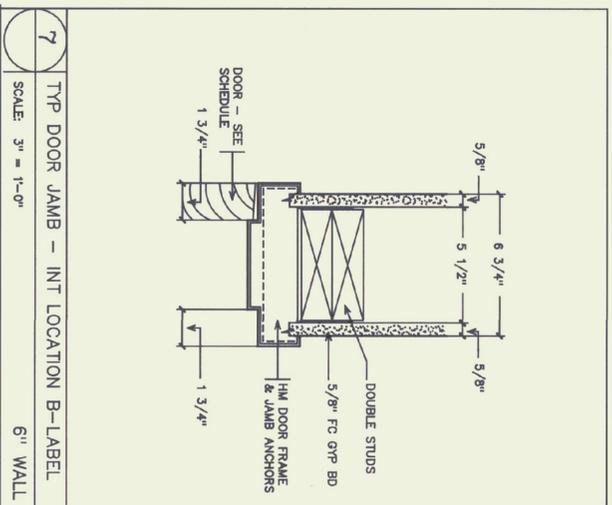


7 TYP DOOR JAMB - INT LOCATION B-LABEL  
SCALE: 3" = 1'-0" 6" WALL

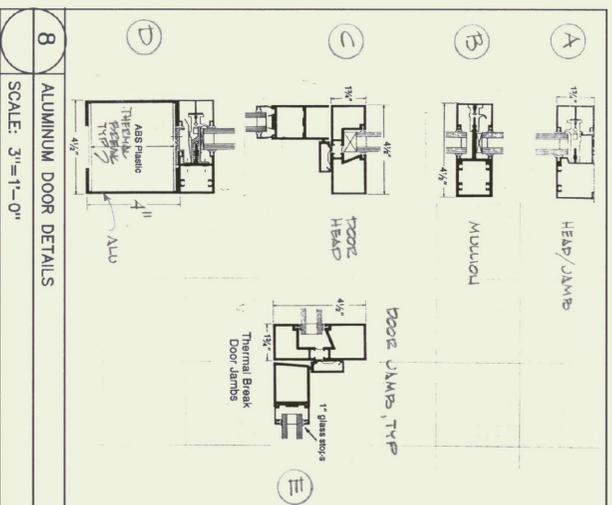


8 ALUMINUM DOOR DETAILS  
SCALE: 3" = 1'-0"

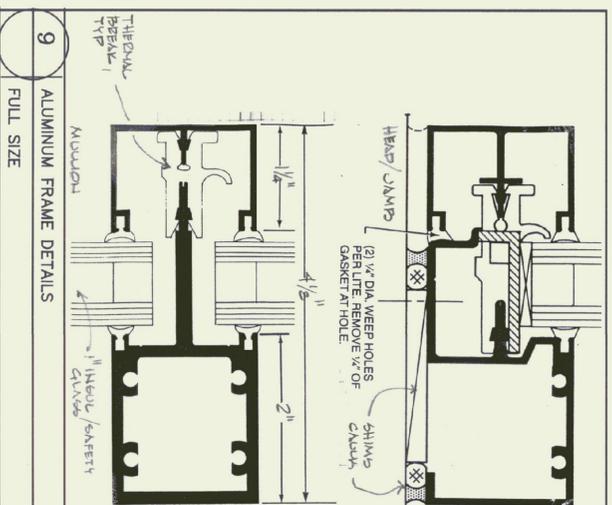


9 ALUMINUM FRAME DETAILS  
FULL SIZE

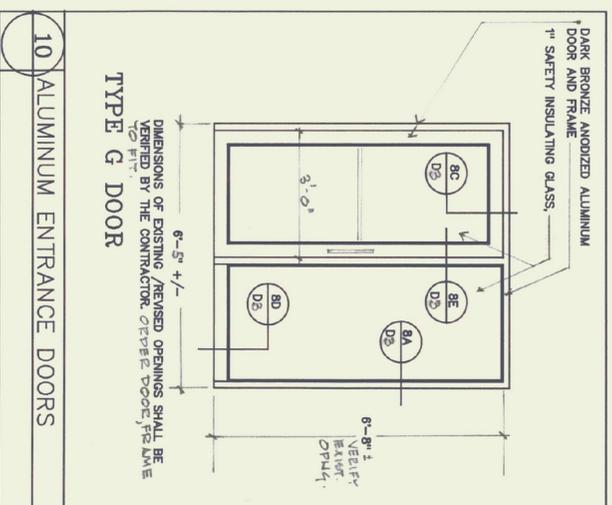

10 ALUMINUM ENTRANCE DOORS  
DIMENSIONS OF EXISTING /REVISED OPENINGS SHALL BE VERIFIED BY THE CONTRACTOR. OTHER DOOR FRAME FIT.

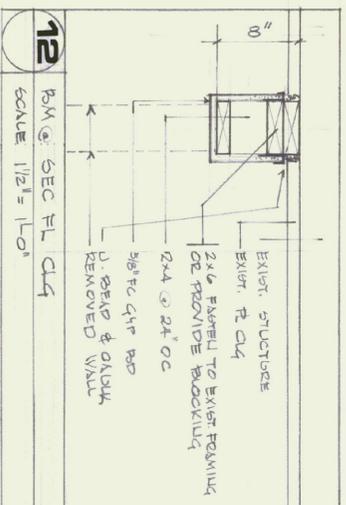


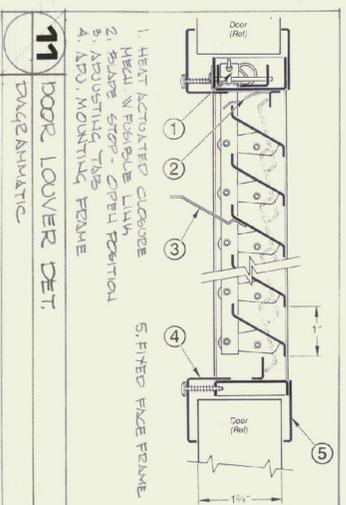


State of Vermont  
Department of State Buildings  
John Zampieri, Commissioner

Materials & Research  
Laboratory  
Berlin, Vt.

PHASE II



Jonson Design, Inc.  
FRED KELL, ARCHITECT  
P.O. BOX 55 - BOLTON ROAD, WATERBURY, VT 05676  
(802) 244-0800

DATE: APRIL 20 1978

DWG. NO.

D3