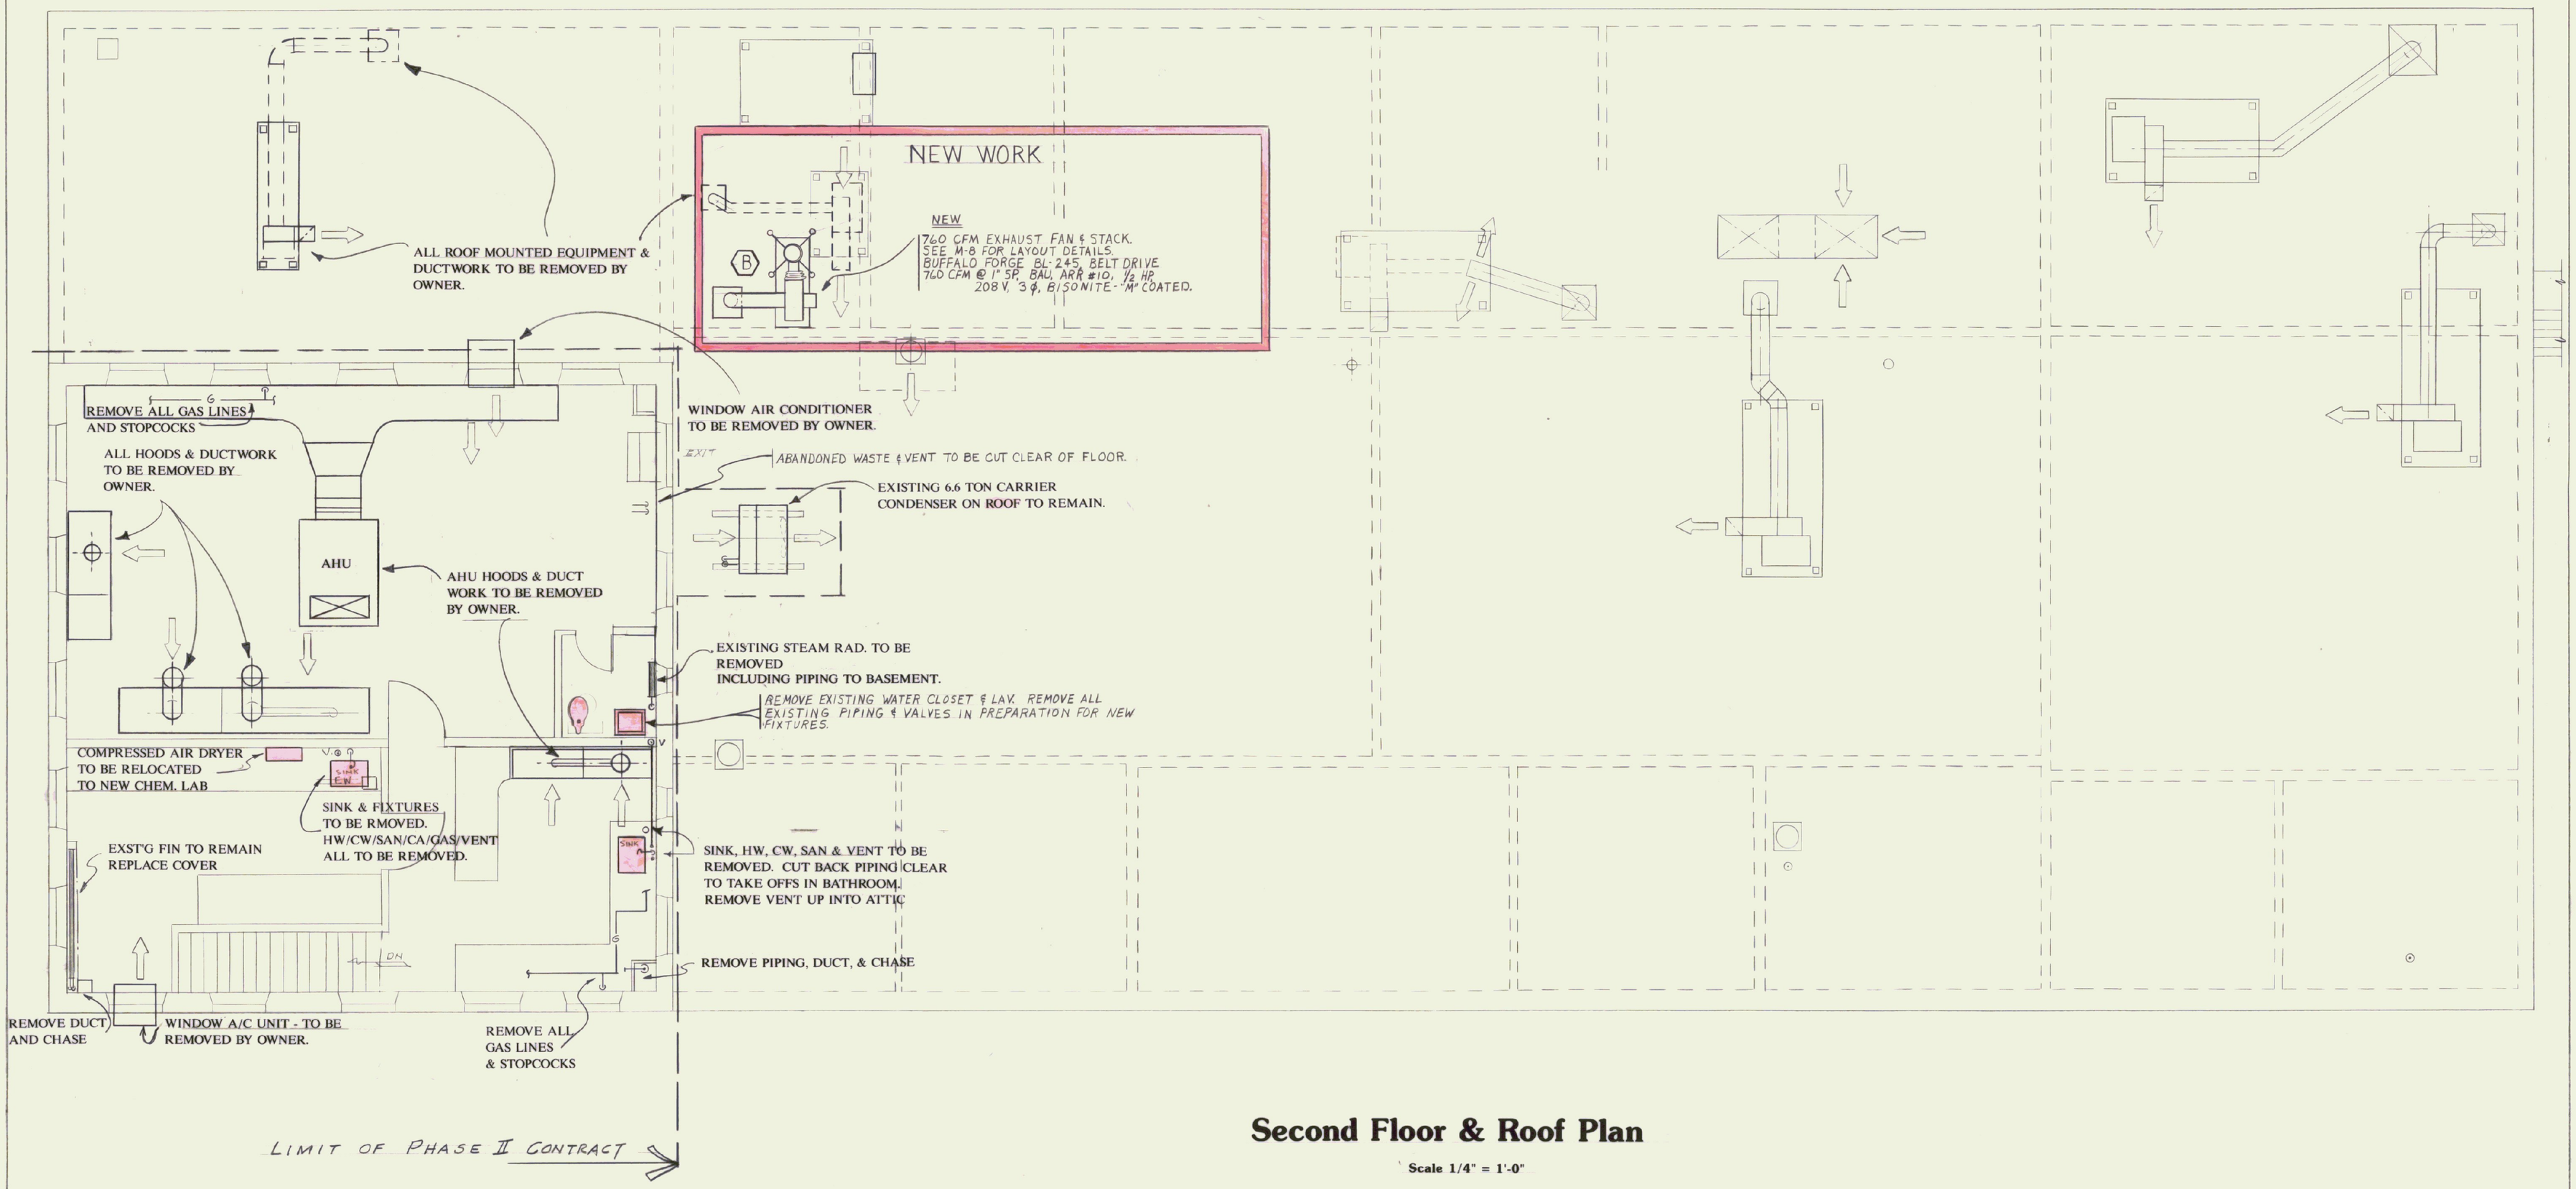

Second Floor & Roof Plan

Scale 1/4" = 1'-0"

STATE OF VERMONT — GORDON W. ROLLER, JR. — NO. 5704 — REGISTERED PROFESSIONAL ENGINEER

MECHANICAL CONSULTANT:

GWR Engineering, P.C.
PO Box 157 - The Creamery Building
Shelburne, VT 05482
Tel (802) 985-8061 FAX (802) 985-8499

ARCHITECT:

Janson Design, Inc.
FRED KEIL, ARCHITECT
P.O. BOX 53 – BOLTON ROAD, WATERBURY, VT 05676
(802) 244-5800

State of Vermont
Department of State Buildings
John Zampieri, Commissioner

MATERIALS & RESEARCH LABORATORY
Berlin, VT
Phase 2

MECHANICAL DEMOLITION WORK

Second Floor Plan - Existing

DATE: 4-20-90

DWG. NO. **M-4**

PHASE II DWGS CONTINUED