




**1** TYP 1-HR RATED DOOR ELEV  
SCALE: 1/2" = 1'-0"

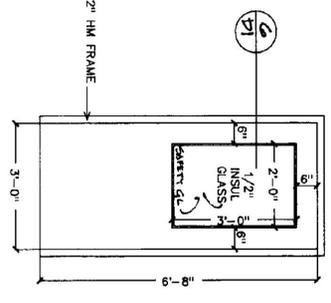


**2** TYP DOOR  
SCALE: 1/2" = 1'-0"

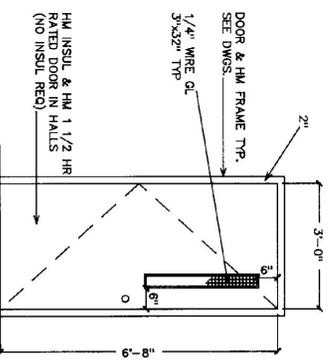


**3** TYPICAL DOORS, 1-HR RATING  
SCALE: 1/2" = 1'-0"

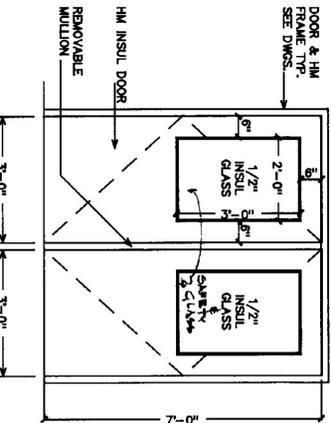


**4** TYPICAL FIRE RATED DOORS  
SCALE: 1/2" = 1'-0"

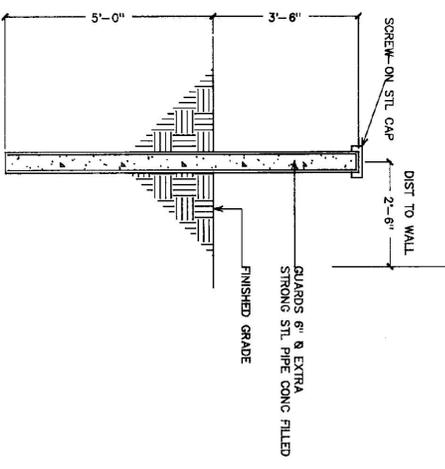


**5** GUARD POST DETAIL  
SCALE: 1/2" = 1'-0"

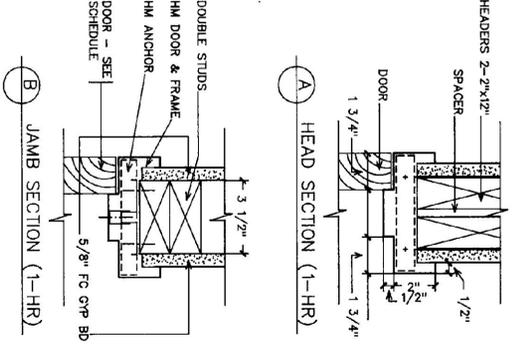


**6** TYP DOOR DETAIL - 1-HR  
SCALE: 3" = 1'-0"  
4" WALL

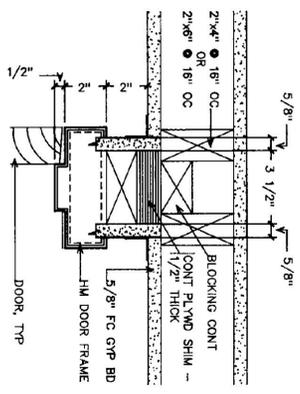


**7** TYP DOOR JAMB - 1-HR  
SCALE: 3" = 1'-0"

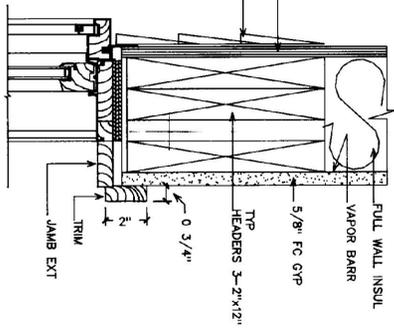


**8** TYP WINDOW HEAD DETAIL  
SCALE: 3" = 1'-0"

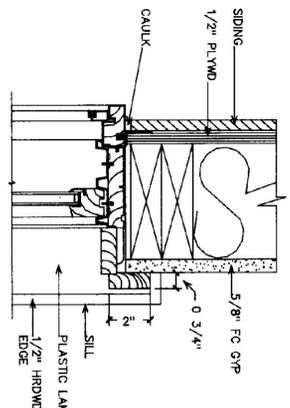


**9** TYP WINDOW JAMB DETAIL  
SCALE: 3" = 1'-0"

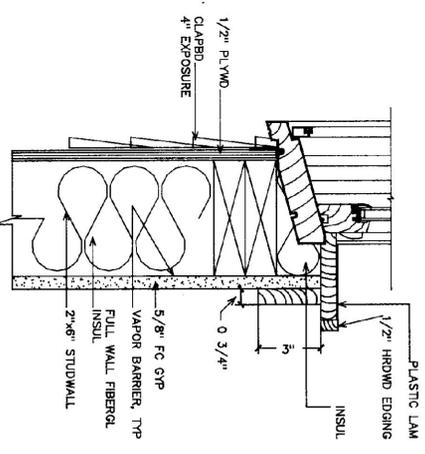


**10** TYP WINDOW SILL DETAIL  
SCALE: 3" = 1'-0"

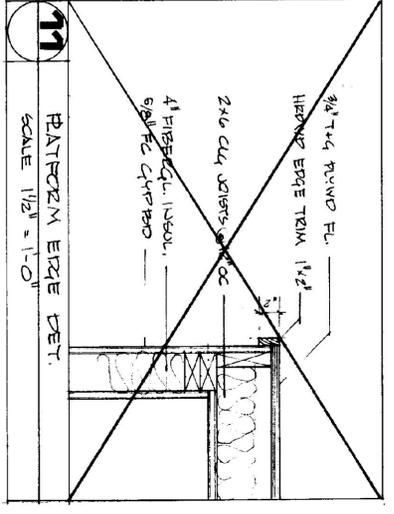


**11** PLATFORM EDGE DET.  
SCALE: 1/2" = 1'-0"

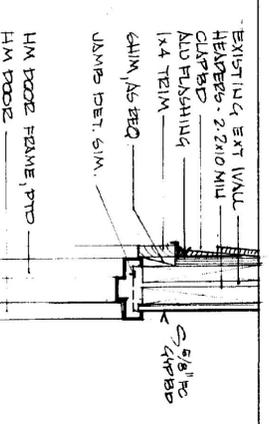


**12** HEAD DET. FOR DOOR #1  
SCALE: 1/2" = 1'-0"

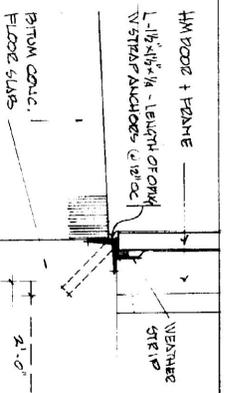

**13** SILL DET. & EXT DOOR DETAIL  
SCALE: 1/2" = 1'-0"

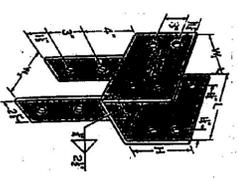


**14** GALV. STL COL. BASE, TYP  
NTS

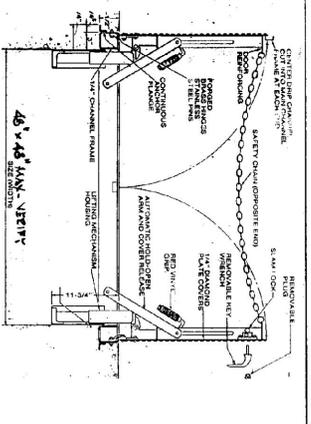

**15** FT COVER, TYP. 100PSF MIN LL.  
NTS

State of Vermont  
Department of State Buildings  
John Zampieri, Commissioner

Materials & Research  
Laboratory  
Berlin, VT

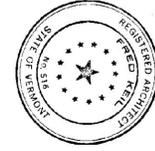

Janson Design, Inc.  
FRED NEIL, ARCHITECT  
P.O. BOX 55 - BURLINGTON, VT 05407  
(802) 244-3800

Architect's Project No. 247

DATE:  
OCT. 10,  
1989  
DWG. NO.  
**01**