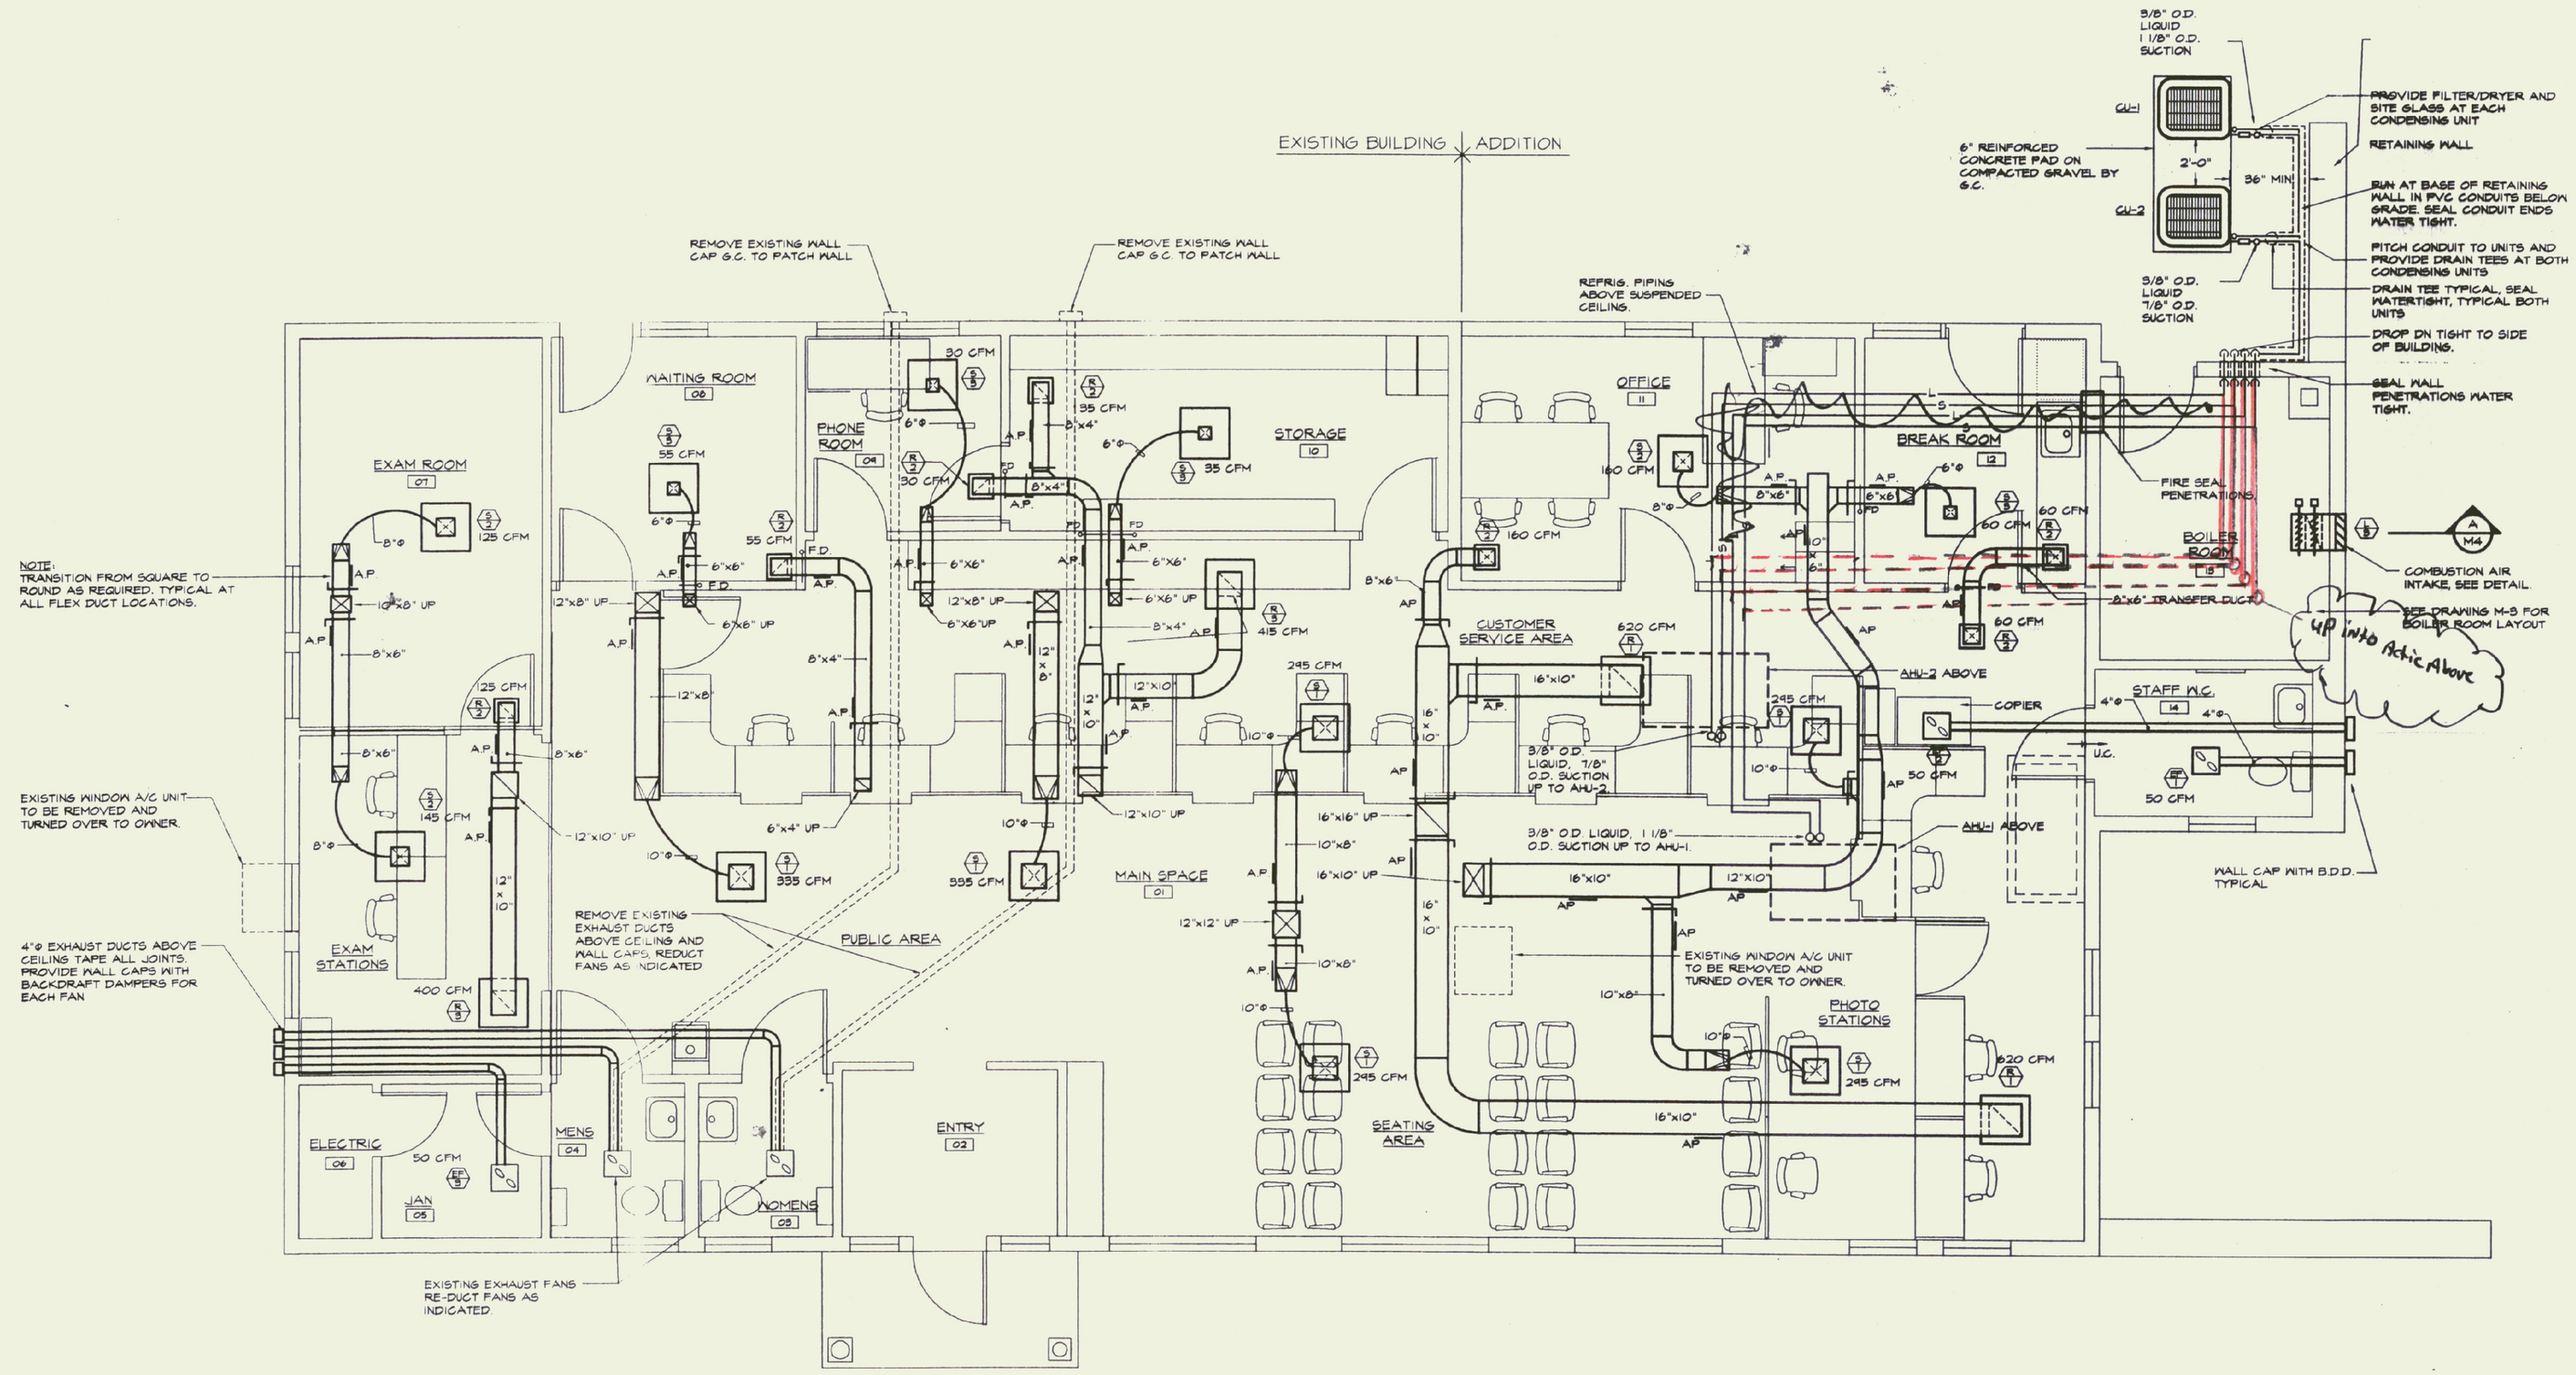

MAIN FLOOR PLAN - MECHANICAL LOWER LEVEL DUCTWORK

SCALE: 1/4"=1'-0"

GENERAL DEMOLITION NOTES:

1) REMOVE ALL ELECTRIC RADIATION AND CONTROLS.

2) REMOVE ALL WINDOW A/C UNITS AND TURN OVER TO OWNER.

AS-BUILT

/ /

THE STATE OF VERMONT DANIEL W. DUPRAS NO. 7758 PROFESSIONAL ENGINEER

ERTEL ASSOCIATES ARCHITECTS 15 CENTRAL STREET WOODSTOCK, VERMONT 05091 LANE ASSOCIATES CONSULTING ENGINEERS 51 KILLINGTON AVENUE RUTLAND, VERMONT 05701	DEPARTMENT OF MOTOR VEHICLES RUTLAND – RENOVATION & ADDITION MAIN FLOOR PLAN – MECHANICAL DUCTWORK	N ACT. N NOM	JOB #: CADD #: BY: TDL	SCALE: AS NOTED DATE: MAY 2000 REVISIONS:		M2