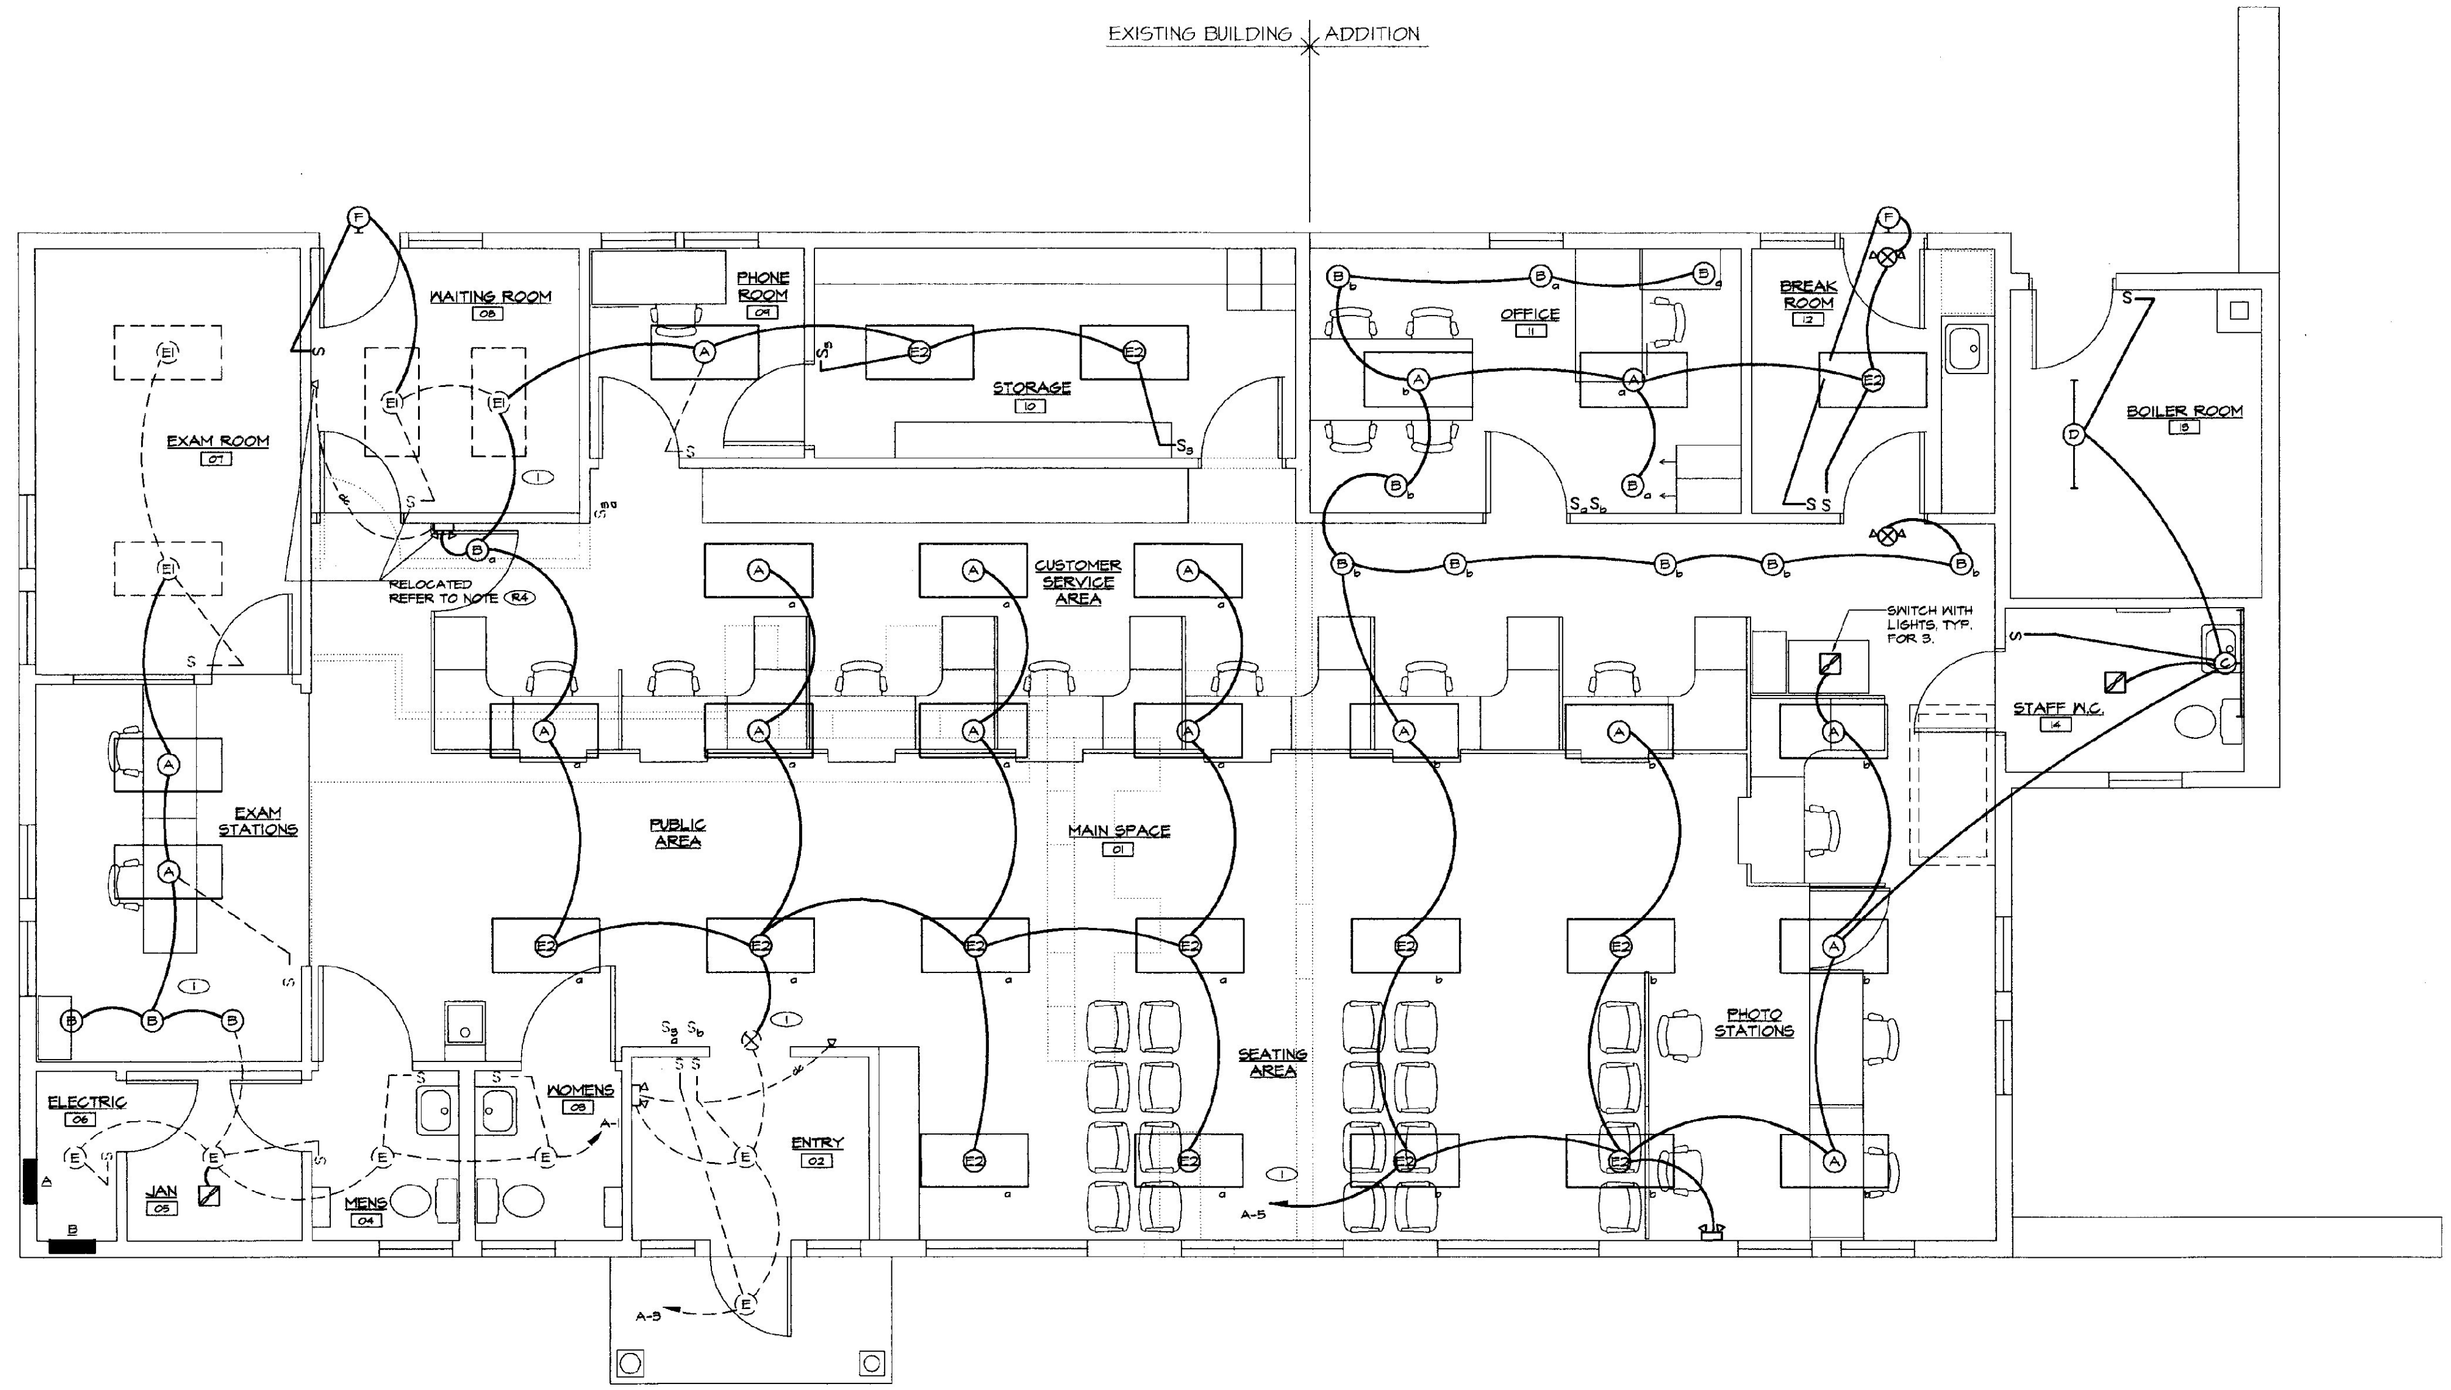

DRAWING NOTES (PLAN SYMBOL ⊕)

1. RE-USE EXISTING CIRCUIT AND HOMERUN TO PANELBOARD. EXTEND TO NEW OUTLETS AS INDICATED, USING 2#12, 1#12G.
2. CONNECT TO 4 CIRCUIT WIRING HARNESS PROVIDED WITH WORK STATIONS. CONNECT ISOLATED GROUNDS OF CIRCUITS A-6,8 & 10 TO GROUND CONDUCTOR IN WIRING HARNESS. CONNECT NORMAL GROUNDS OF ALL CIRCUITS TO METAL HOUSING OF POWER POLE.
3. POWER POLE PROVIDED WITH WORK STATIONS. 1 POLE FOR POWER CIRCUITS, 1 POLE FOR LAN AND TELEPHONE WIRING.
4. REMOVE EXISTING 20A-2P CIRCUIT BREAKER AND INSTALL 2@20A-1P CIRCUIT BREAKERS. PROVIDE 2#12, 1#12G CIRCUIT CONDUCTORS.
5. PROVIDE NEW 20A-1P CIRCUIT BREAKER IN EXISTING SPACE. PROVIDE 2#12, 1#12G CIRCUIT CONDUCTORS.
6. EXTEND EXISTING FIRE ALARM INITIATION AND NOTIFICATION CIRCUITS TO NEW DEVICES. REFER TO DETAILS FOR GENERAL REQUIREMENTS.
7. CONNECT TO EXISTING 20A-2P CIRCUIT BREAKERS. PROVIDE 3#12, 1#12G CIRCUIT CONDUCTORS.
8. REMOVE (2) EXISTING 2 POLE CIRCUIT BREAKERS AND INSTALL 40A-2P CIRCUIT BREAKERS. PROVIDE 2#8, 1#10G CIRCUIT CONDUCTORS.

MAIN FLOOR PLAN - LIGHTING

SCALE: 1/4"=1'-0"

NOTES:

1) REFER TO ARCHITECT'S REFLECTED CEILING PLAN FOR EXACT LOCATION OF LIGHTING FIXTURES.
2) EXISTING CIRCUIT INFORMATION IS TAKEN FROM AS-BUILT DRAWINGS. FIELD VERIFY EXACT ARRANGEMENT.

AS-BUILT

THE STATE OF VERMONT
CHARLES F. LANE
No. 4100
PROFESSIONAL ENGINEER

ERTEL ASSOCIATES ARCHITECTS 15 CENTRAL STREET WOODSTOCK, VERMONT 05091 LANE ASSOCIATES CONSULTING ENGINEERS 51 KILLINGTON AVENUE RUTLAND, VERMONT 05701	DEPARTMENT OF MOTOR VEHICLES RUTLAND – RENOVATION & ADDITION MAIN FLOOR PLAN - LIGHTING	N ACT. N NOM	JOB #: CADD #: BY: JDL/BML	SCALE : AS NOTED DATE: MAY 2000 REVISIONS:	E1

X:\9606\drawin_SLECT\9906E01.dwg Wed May 03 16:53:20 2000