


New
Proposed
UST's

T6-Boss
Tank sites
1998

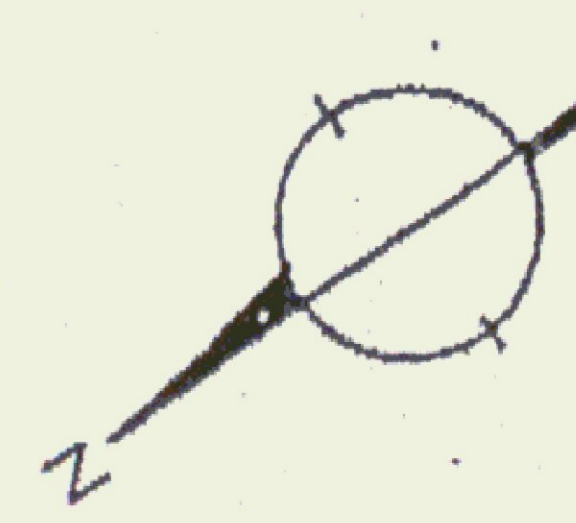

To Montpelier

Route 12

To Northfield

FEB 24 1998

NOTE: NOT OFFICIAL HIGHWAY MAP. ROAD NAMES SHOWN ARE THE OFFICIALLY ASSIGNED NAMES AND SHOULD BE USED IN ANY OFFICIAL TOWN BUSINESS. NOT ALL ROADS SHOWN ARE OPEN TO THE PUBLIC, BUT ARE ASSUMED PASSABLE, AT LEAST DURING SUMMER, IN A PASSENGER VEHICLE.