


ASSUME 3" H. = 100.00'

NOTE:

- EXIST. PIPE 4" CAST IRON, 2' OUT FROM B.L.A.
- CONT. W. CAST IRON, NO HUB, FOR 10'
- CONT. W. 4" TRANSITE PIPE FOR 10'
- CONT. W. 4" " " 45' EL.
- CONT. W. 4" " " PIPE FOR 10'-0"

6512 795

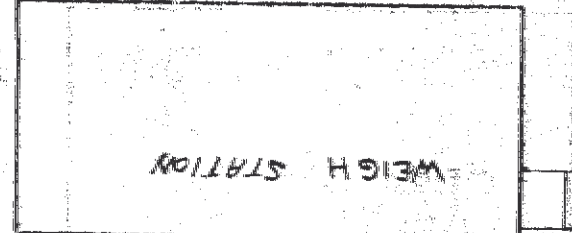

1000 GAL. SEPTIC TANK
PRE-CAST CONCRETE



EL. 97.0

GR. EL. 101.3

EL. 97.8

HOLE DISP. BOX
PRE-CAST CONC.

4" BERMUDA SOIL PIPE SOLID (9'-6" Lg.)

NOTE: ALL LEACH PIPE IS BERMUDA 4" PREF.

LOCATING SIGHT LINE

27.1

27.7

35.7

24.4

28.1

7.3'

EL. 97.4

TEST
HOLE
EL. 97.0

10.1