


State of Vermont
 Department of Buildings & General Services
SOUTHEAST VERMONT WELCOME CENTER
 I-91 at Kilometer Marker 9.01
 Guilford, Vermont

AGENCY OF ADMINISTRATION
 DEPT. OF BUILDINGS & GENERAL SERVICES
 2 GOVERNOR AIKEN AVENUE
 MONTPELIER, VERMONT 05633-5801
 THOMAS W. TORTI, COMMISSIONER


FEDERAL HIGHWAY ADMINISTRATION
 VERMONT DIVISION
 78 STATE STREET ROOM 216
 FEDERAL BUILDING
 MONTPELIER, VERMONT 05602
 FREDERICK DOWNS

AGENCY OF TRANSPORTATION
 133 STATE STREET
 MONTPELIER, VERMONT 05602
 GLENN GERSHANECK, SECRETARY


Paul D. Ricketts
 DEPT. DIVISION ADMINISTRATOR

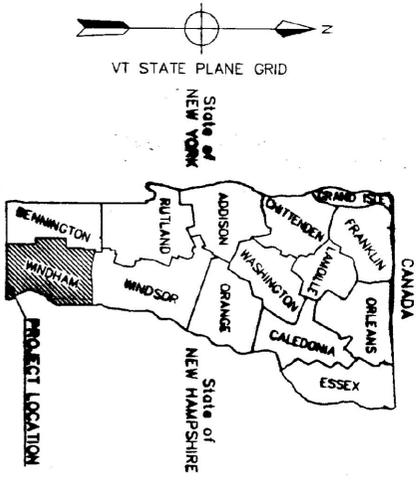

STATE LOCATION
 N.T.S.

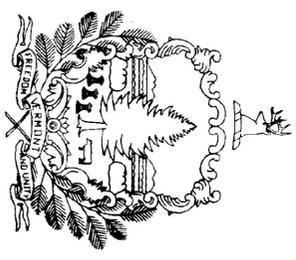

PROJECT LOCATION
 N.T.S.

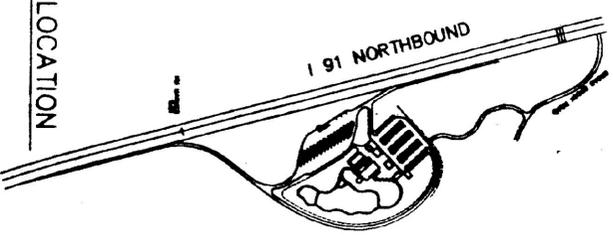

ARCHITECT



TIMOTHY D. SMITH & ASSOCIATES, P.C. ARCHITECTS
 OLD RAILROAD STATION
 802-442-8184

NORTH BENNINGTON, VERMONT 05257
 FAX 802-442-8241

Howard Dean, M.D.
 Governor
 JANUARY 16, 1998

Southest Vermont Welcome Center:
 A new Welcome Center facility located on Interstate 91 at kilometer marker 9.01 including a welcome center building, a maintenance barn, a picnic shed and an information crib with related site development including automobile parking, truck and bus and R.V. parking, an orchard, gardens, a landscaped picnic area, and outdoor exhibit areas.

RECORD
 DRAWING
 INDEX ON NEXT SHEET