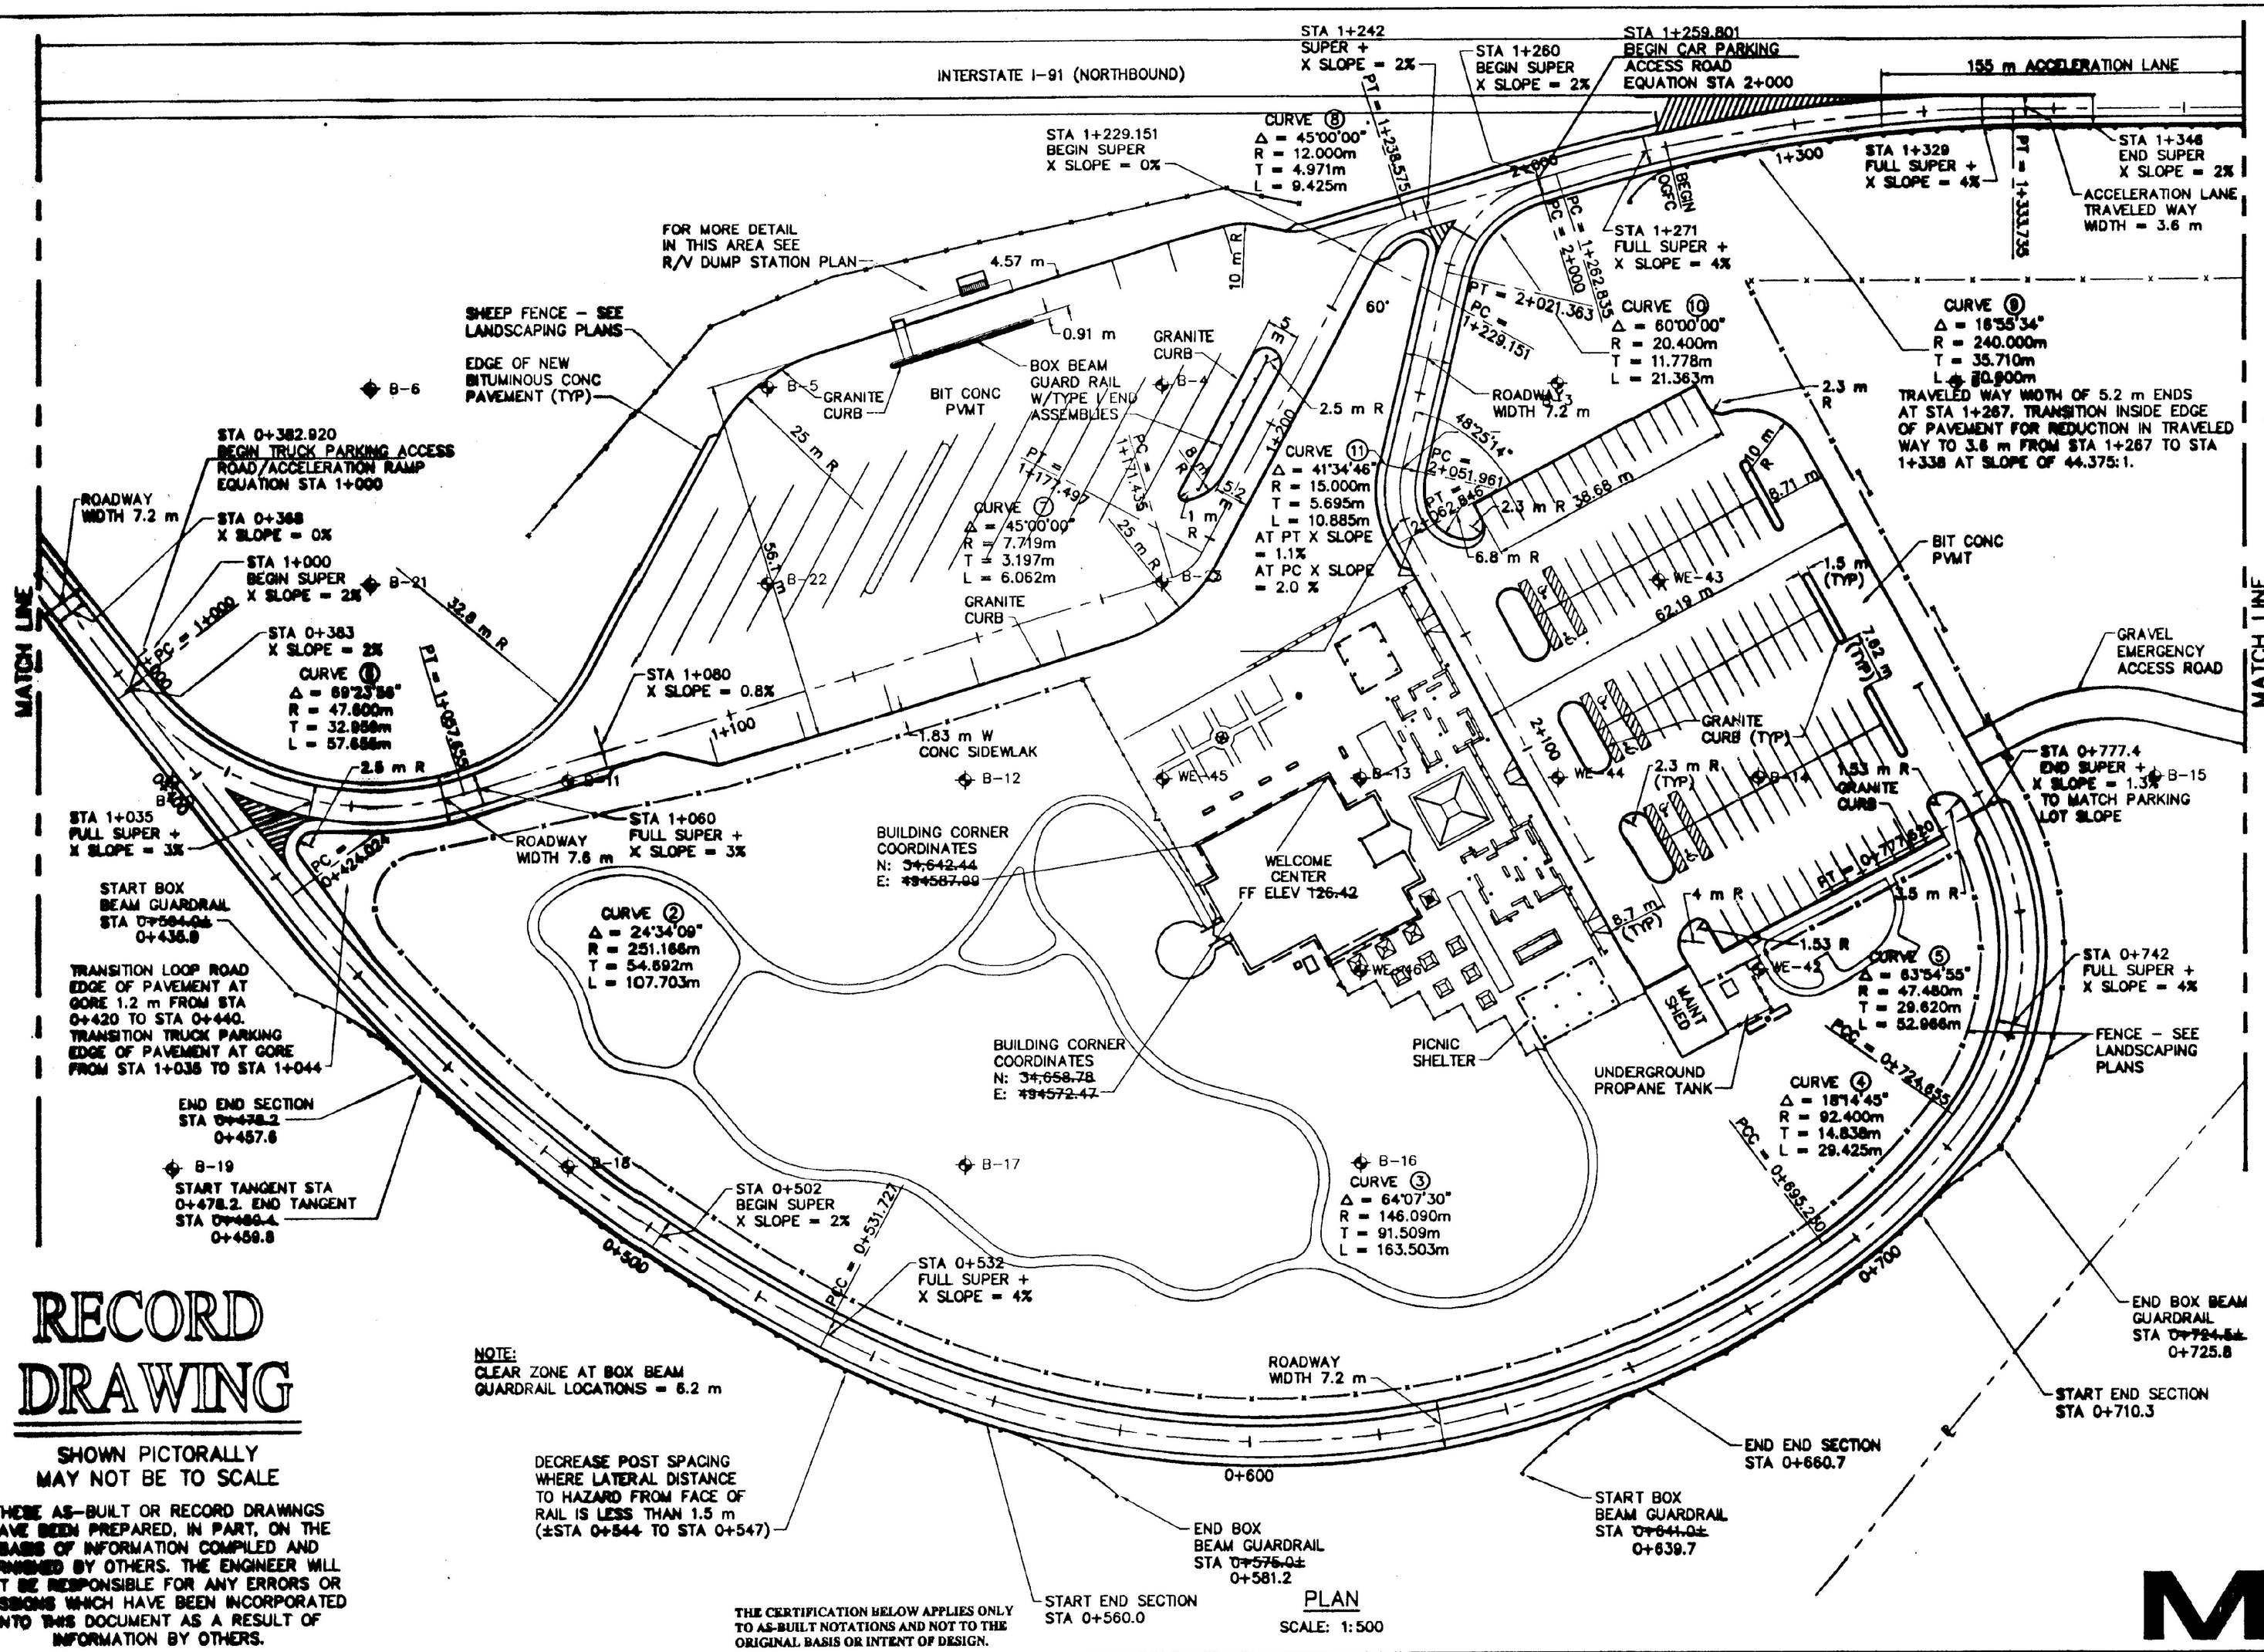

PLAN

SCALE: 1:500

RECORD DRAWING

SHOWN PICTORALLY MAY NOT BE TO SCALE

THESE AS-BUILT OR RECORD DRAWINGS HAVE BEEN PREPARED, IN PART, ON THE BASIS OF INFORMATION COMPILED AND FURNISHED BY OTHERS. THE ENGINEER WILL NOT BE RESPONSIBLE FOR ANY ERRORS OR OMISSIONS WHICH HAVE BEEN INCORPORATED INTO THIS DOCUMENT AS A RESULT OF INFORMATION BY OTHERS.

THE CERTIFICATION BELOW APPLIES ONLY TO AS-BUILT NOTATIONS AND NOT TO THE ORIGINAL BASIS OR INTENT OF DESIGN.

Metric

NO.	DATE	REVISIONS	DRWN	CHKD
2	12/00	AS-BUILT INFORMATION ADDED	DSM	KAS
1	2/[illegible]	REVISIONS PER BGS/FHwA REVIEW	DSM	KAS

TIMOTHY D. SMITH & ASSOCIATES, PC ARCHITECTS
OLD RAILROAD STATION
802-442-8184
NORTH BENNINGTON, VERMONT 05257
FAX 802-442-5241

WRIGHT ENGINEERING, LTD.
CIVIL ENGINEERS
120 MERCHANTS ROW – P.O. BOX 476
RUTLAND, VERMONT 05702-0476
802-775-2511 FAX 775-2815

ROBT W. HALL
CONSULTING ENGINEERS, INC.
540 MEADOW STREET EXTENSION, STE. 2
AGAWAM, MASSACHUSETTS 01001-0002
413-789-6068 FAX 789-3296

T.J. BOYLE AND ASSOCIATES
LANDSCAPE ARCHITECTS
301 COLLEGE STREET
BURLINGTON, VERMONT 05401
802-658-3555 FAX 863-1642

STATE OF VERMONT KEVIN A. SMITH No. 5464 REGISTERED PROFESSIONAL ENGINEER

PROJECT NO.IM 091-1 (30)

SOUTHEAST VERMONT WELCOME CENTER
GUILFORD, VERMONT

SHEET TITLE: ROAD PLAN

DSGN BY: JAC
DRWN BY: DSM
CHKD BY: JAC
CHKD BY: JCO

STATE OF VERMONT
AGENCY OF ADMINISTRATION
DEPARTMENT OF BUILDINGS & GENERAL SERVICES

DATE: 1-16-98 SHEET NO. ____ OF ____ SHEETS

C5

C:\ACAD12\D501DN\D501C5AB Fri Jan 21 13:13:31 2000