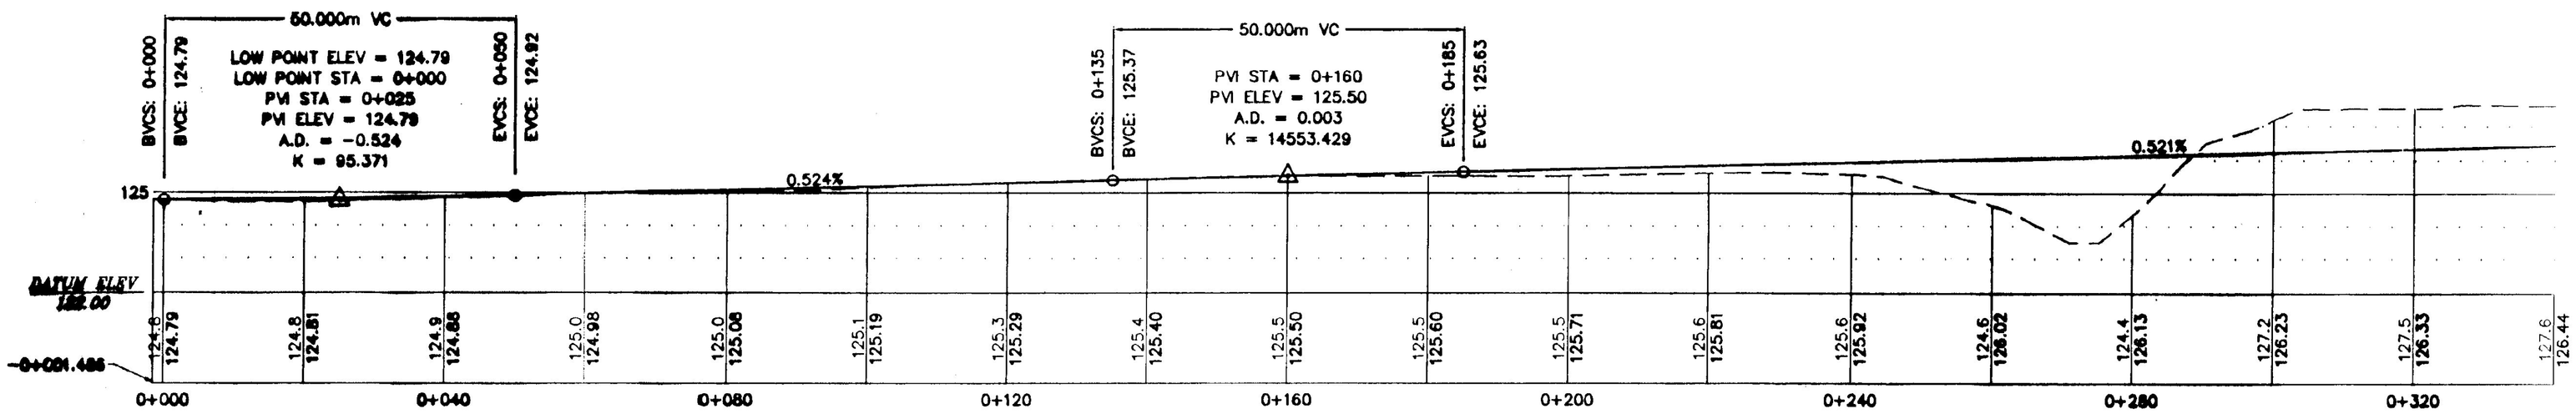

DECELERATION RAMP PROFILE
SCALE: 1:500 H
1:100 V

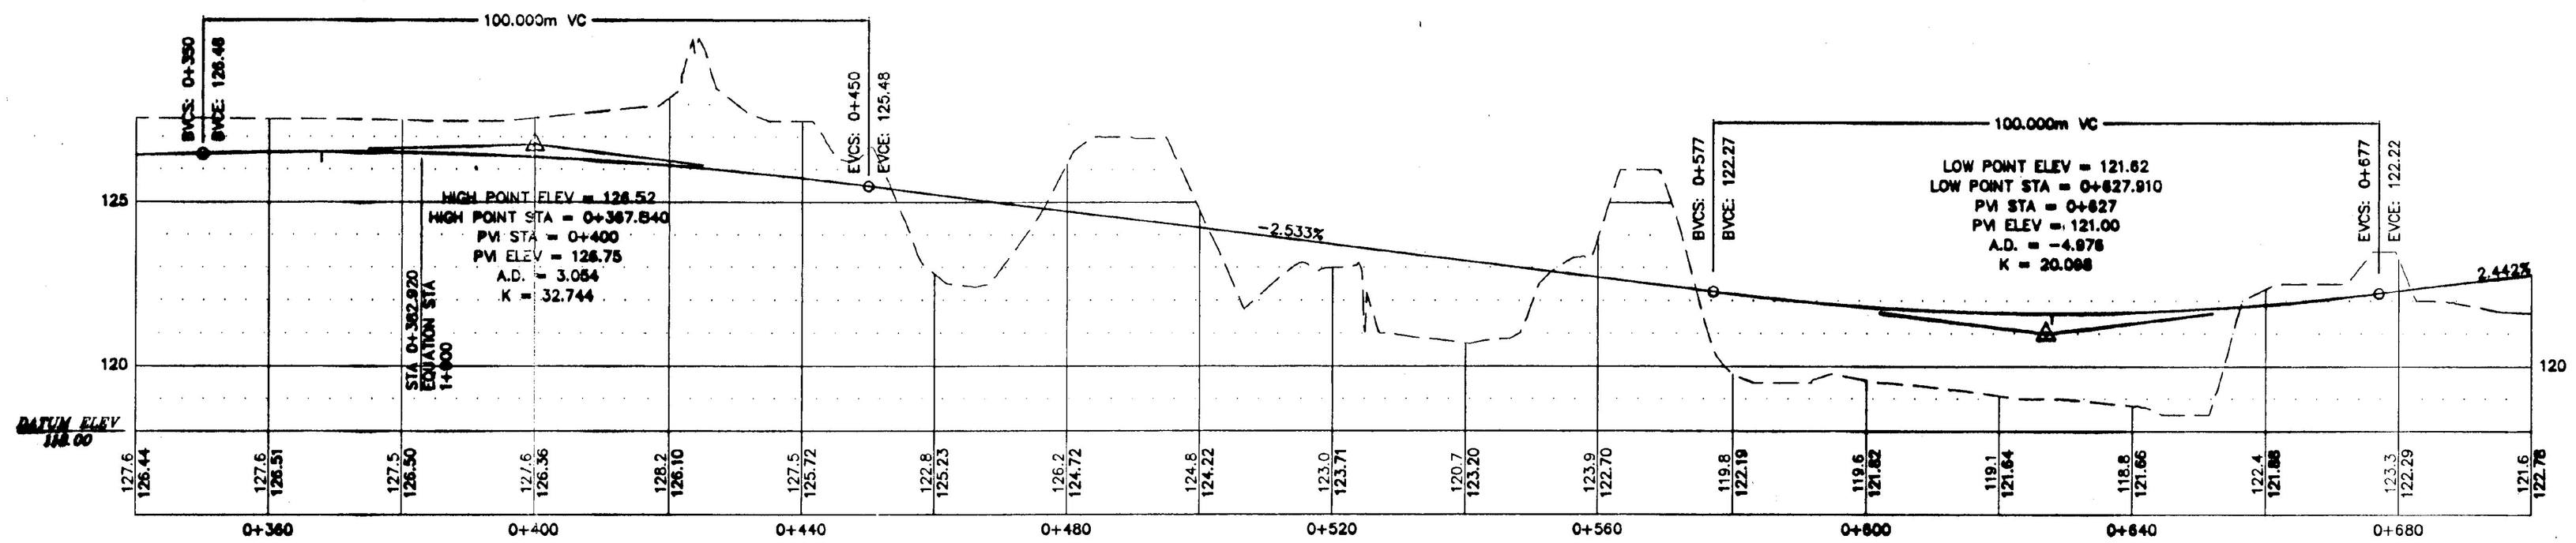

DECELERATION RAMP PROFILE
SCALE: 1:500 H
1:100 V

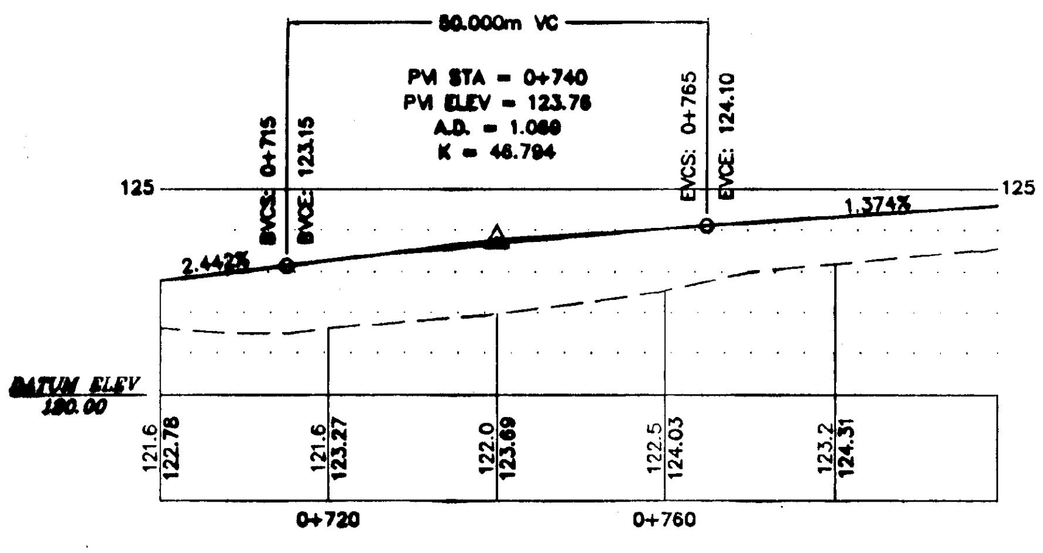

DECELERATION RAMP PROFILE
SCALE: 1:500 H
1:100 V

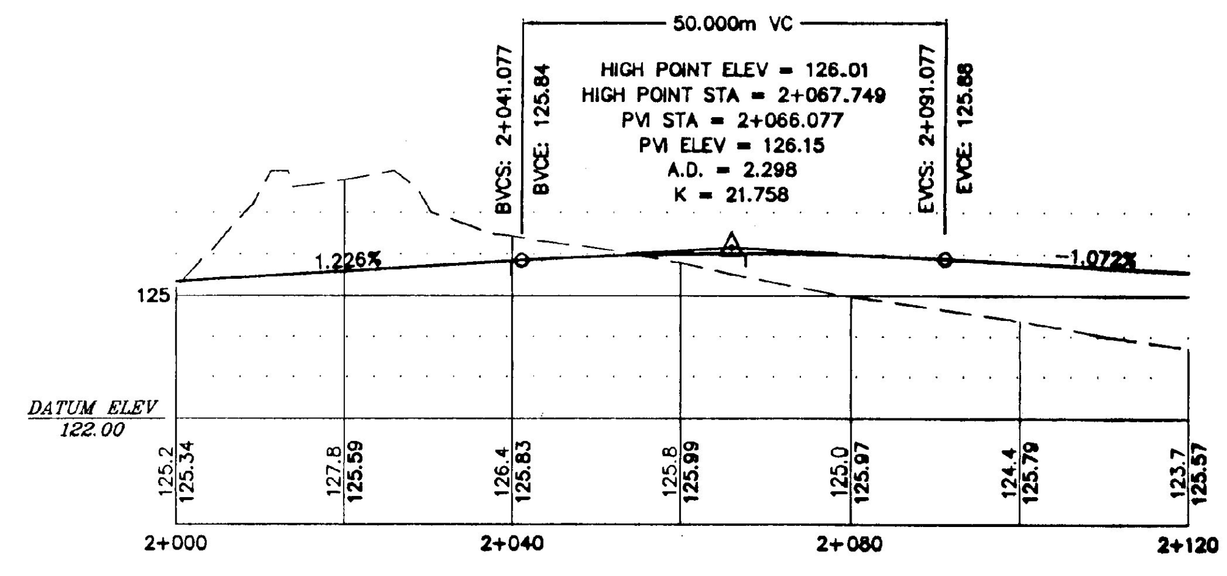

CAR PARKING EXIT ROAD PROFILE
SCALE: 1:500 H
1:100 V

RECORD DRAWING

SHOWN PICTORALLY
MAY NOT BE TO SCALE

THESE AS-BUILT OR RECORD DRAWINGS HAVE BEEN PREPARED, IN PART, ON THE BASIS OF INFORMATION COMPILED AND FURNISHED BY OTHERS. THE ENGINEER WILL NOT BE RESPONSIBLE FOR ANY ERRORS OR OMISSIONS WHICH HAVE BEEN INCORPORATED INTO THIS DOCUMENT AS A RESULT OF INFORMATION BY OTHERS.

THE CERTIFICATION BELOW APPLIES ONLY TO AS-BUILT NOTATIONS AND NOT TO THE ORIGINAL BASIS OR INTENT OF DESIGN.

Metric

NO.	DATE	REVISIONS	DRWN	CHKD
1	12/99	NO AS-BUILT INFORMATION ADDED	DSM	KAS

TIMOTHY D. SMITH & ASSOCIATES, PC ARCHITECTS
OLD RAILROAD STATION
802-442-8184
NORTH BENNINGTON, VERMONT 05257
FAX 802-442-5241

WRIGHT ENGINEERING, LTD.
CIVIL ENGINEERS
126 MERCHANTS ROW - P.O. BOX 176
RUTLAND, VERMONT 05702-0176
802-775-5611 FAX 775-2015

ROBT W. HALL
CONSULTING ENGINEERS, INC.
540 MEADOW STREET EXTENSION, STE. 2
AGAWAM, MASSACHUSETTS 01001-0002
413-789-0000 FAX 789-3286

T.J. BOYLE AND ASSOCIATES
LANDSCAPE ARCHITECTS
301 COLLEGE STREET
BURLINGTON, VERMONT 05401
802-658-3056 FAX 863-1563

STATE OF VERMONT
KEVIN A. SMITH
No. 5884
REGISTERED PROFESSIONAL ENGINEER

PROJECT NO.IM 091-1 (30)
SOUTHEAST VERMONT WELCOME CENTER
GUILFORD, VERMONT

SHEET TITLE: DECELERATION RAMP PROFILE

DSGN BY: JAC
DRWN BY: DSM
CHKD BY: JAC
CHKD BY: JCO

STATE OF VERMONT
AGENCY OF ADMINISTRATION
DEPARTMENT OF
BUILDINGS & GENERAL SERVICES

DATE: 1-16-98
SHEET NO._____OF_____SHEETS

C7

C:\ACAD12\95010N\95010C7AB Thu Dec 9 13:01:18 1999