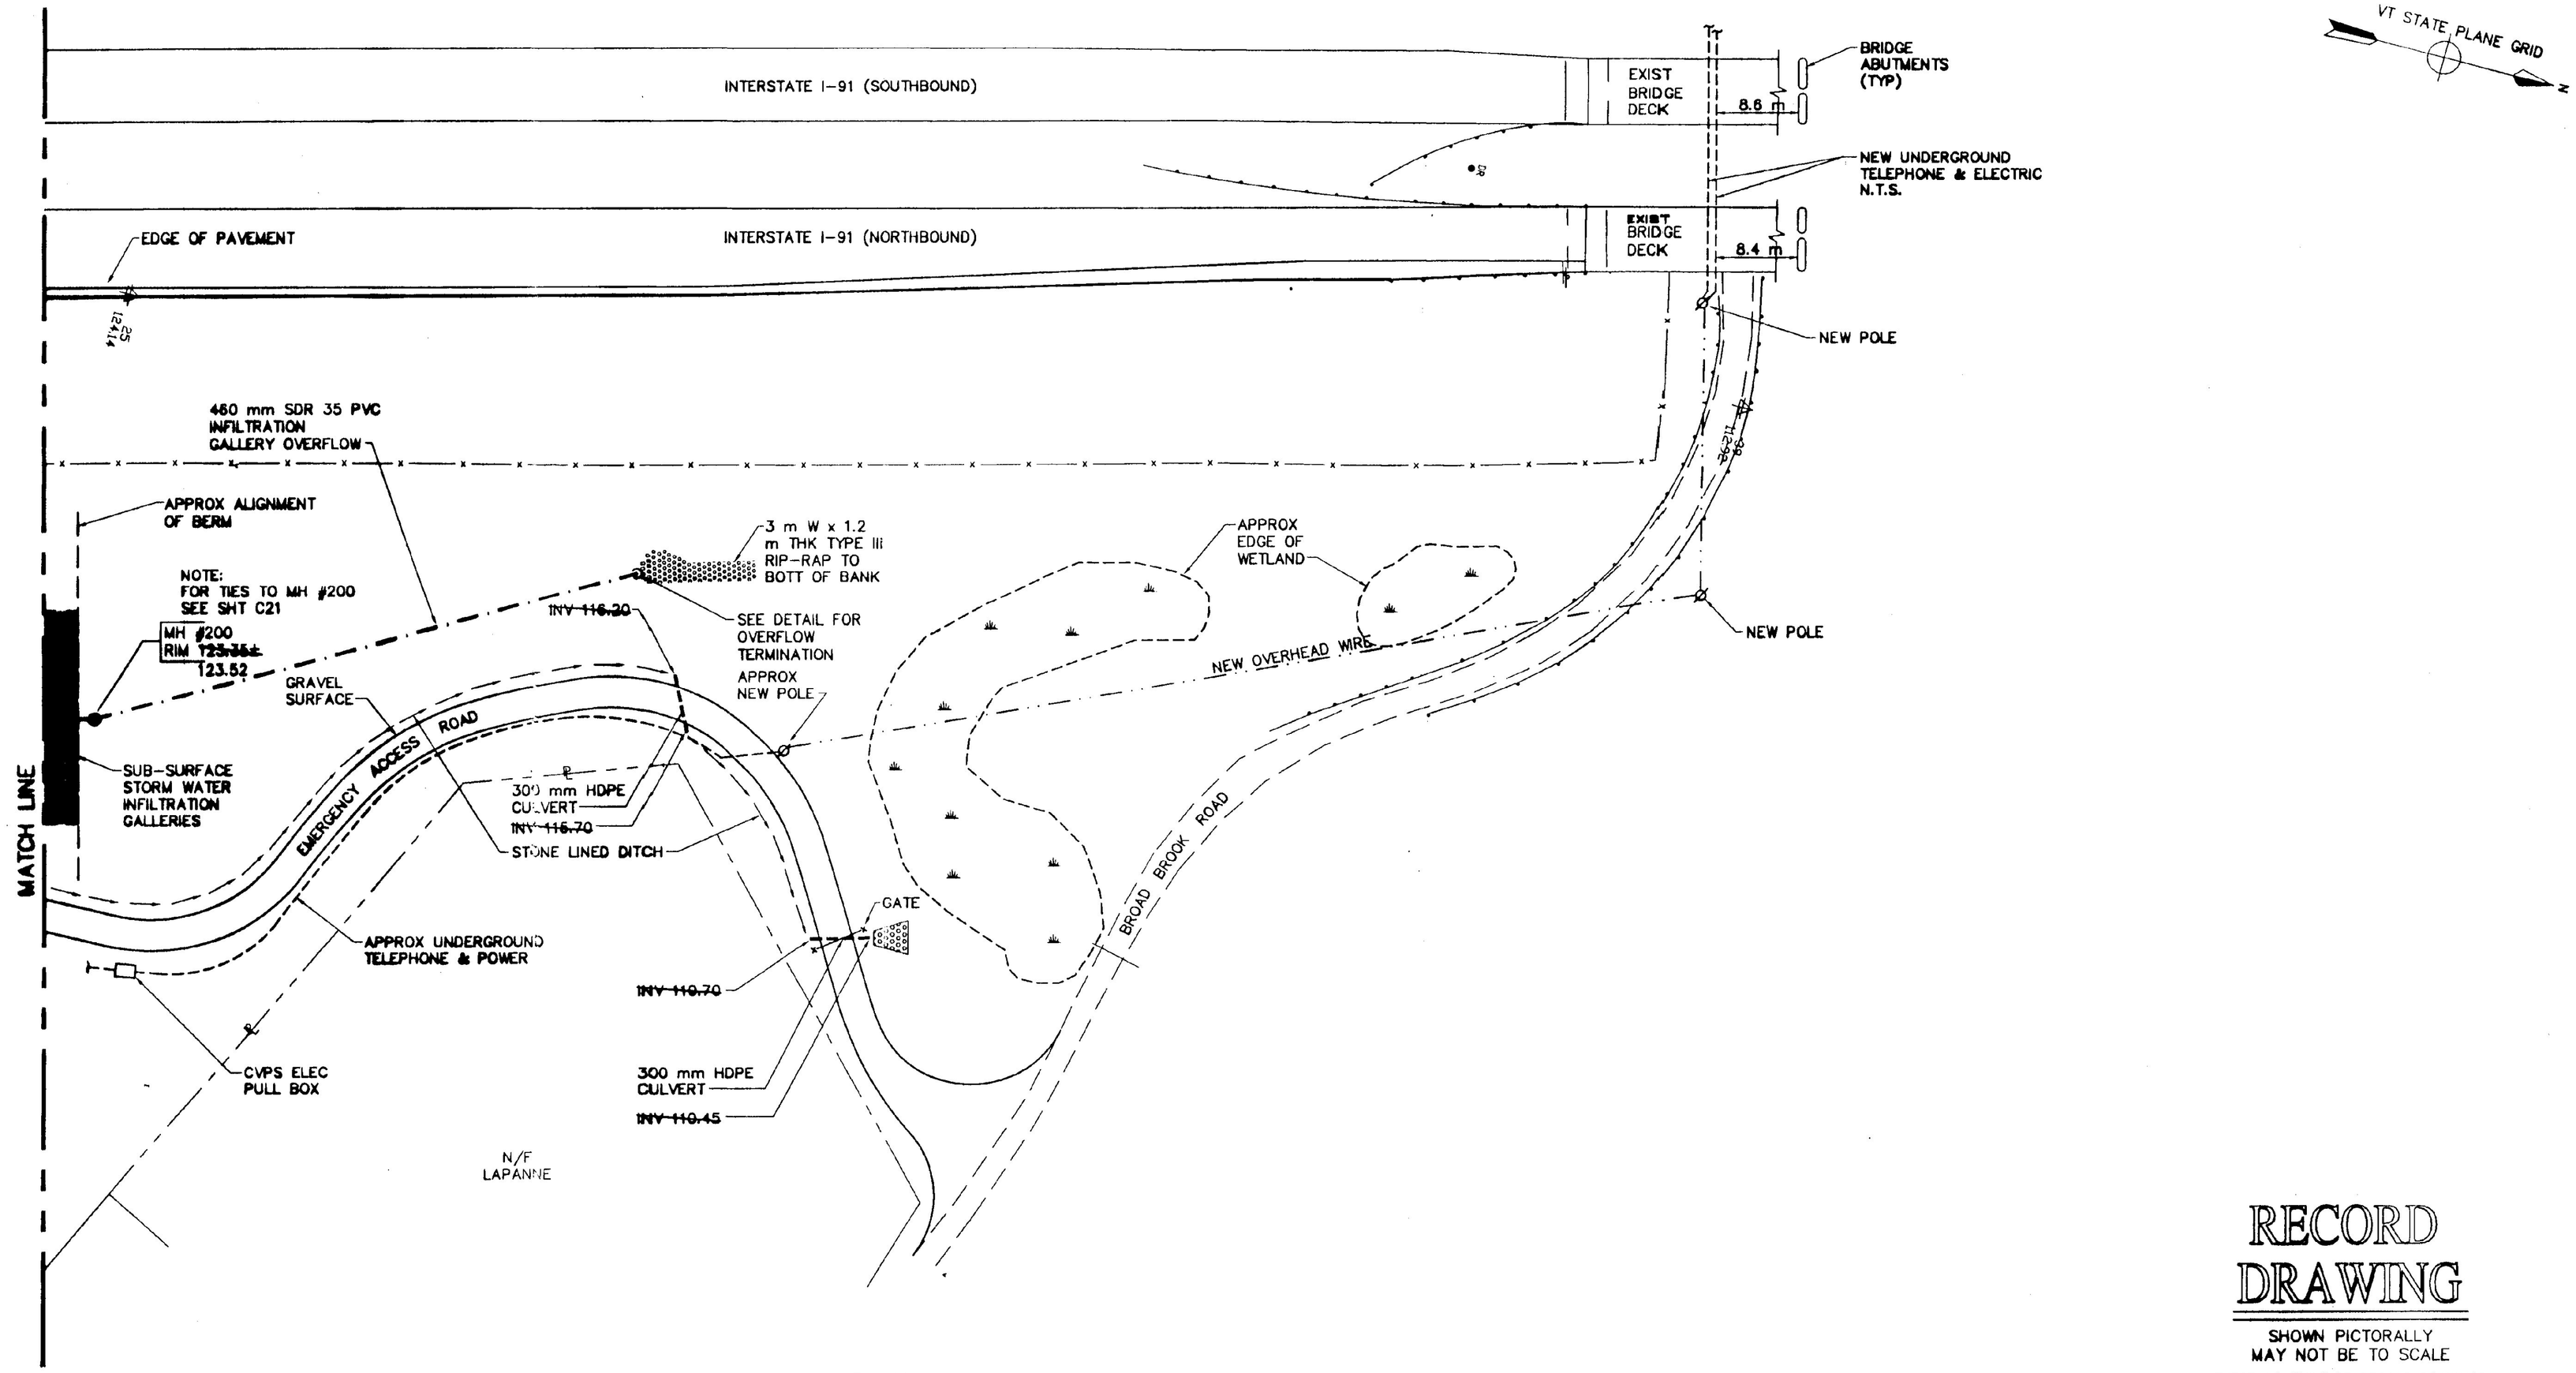

PLAN

SCALE: 1:500

RECORD DRAWING

SHOWN PICTORALLY MAY NOT BE TO SCALE

THESE AS-BUILT OR RECORD DRAWINGS HAVE BEEN PREPARED, IN PART, ON THE BASIS OF INFORMATION COMPILED AND FURNISHED BY OTHERS. THE ENGINEER WILL NOT BE RESPONSIBLE FOR ANY ERRORS OR OMISSIONS WHICH HAVE BEEN INCORPORATED INTO THIS DOCUMENT AS A RESULT OF INFORMATION BY OTHERS.

Metric

NO.	DATE	REVISIONS	DRWN	CHKD
1	12/99	AS-BUILT INFORMATION ADDED	DSM	KAS

TIMOTHY D. SMITH & ASSOCIATES, PC ARCHITECTS
OLD RAILROAD STATION NORTH BENNINGTON, VERMONT 05257
802-442-8184 FAX 802-442-5241

WRIGHT ENGINEERING, LTD. CIVIL ENGINEERS — 128 MERCHANTS ROW - P.O. BOX 178, RUTLAND, VERMONT 05702-0178, 802-775-2611, FAX 775-8015
ROBT W. HALL CONSULTING ENGINEERS, INC. — 640 MEADOW STREET EXTENSION, STE. 2, AGAWAM, MASSACHUSETTS 01001-0002, 413-789-0860, FAX 789-3295
T.J. BOYLE AND ASSOCIATES LANDSCAPE ARCHITECTS — 301 COLLEGE STREET, BURLINGTON, VERMONT 05401, 802-658-3555, FAX 863-1582

STATE OF VERMONT MARK P. YOUNGSTROM No. 3877 REGISTERED PROFESSIONAL ENGINEER 12-5-00

PROJECT NO.IM 091-1 (30)
SOUTHEAST VERMONT WELCOME CENTER
GUILFORD, VERMONT

SHEET TITLE: STORM WATER ~~AND EROSION CONTROL~~ PLAN

DSGN BY: JAC
DRWN BY: DSM
CHKD BY: JAC
CHKD BY: MPY

STATE OF VERMONT
AGENCY OF ADMINISTRATION
DEPARTMENT OF BUILDINGS & GENERAL SERVICES

DATE: 1-16-98 SHEET NO._____ OF _____ SHEETS

C22

C:\ACAD12\9501N\9501C22A Fri Jan 21 14:02:29 2000