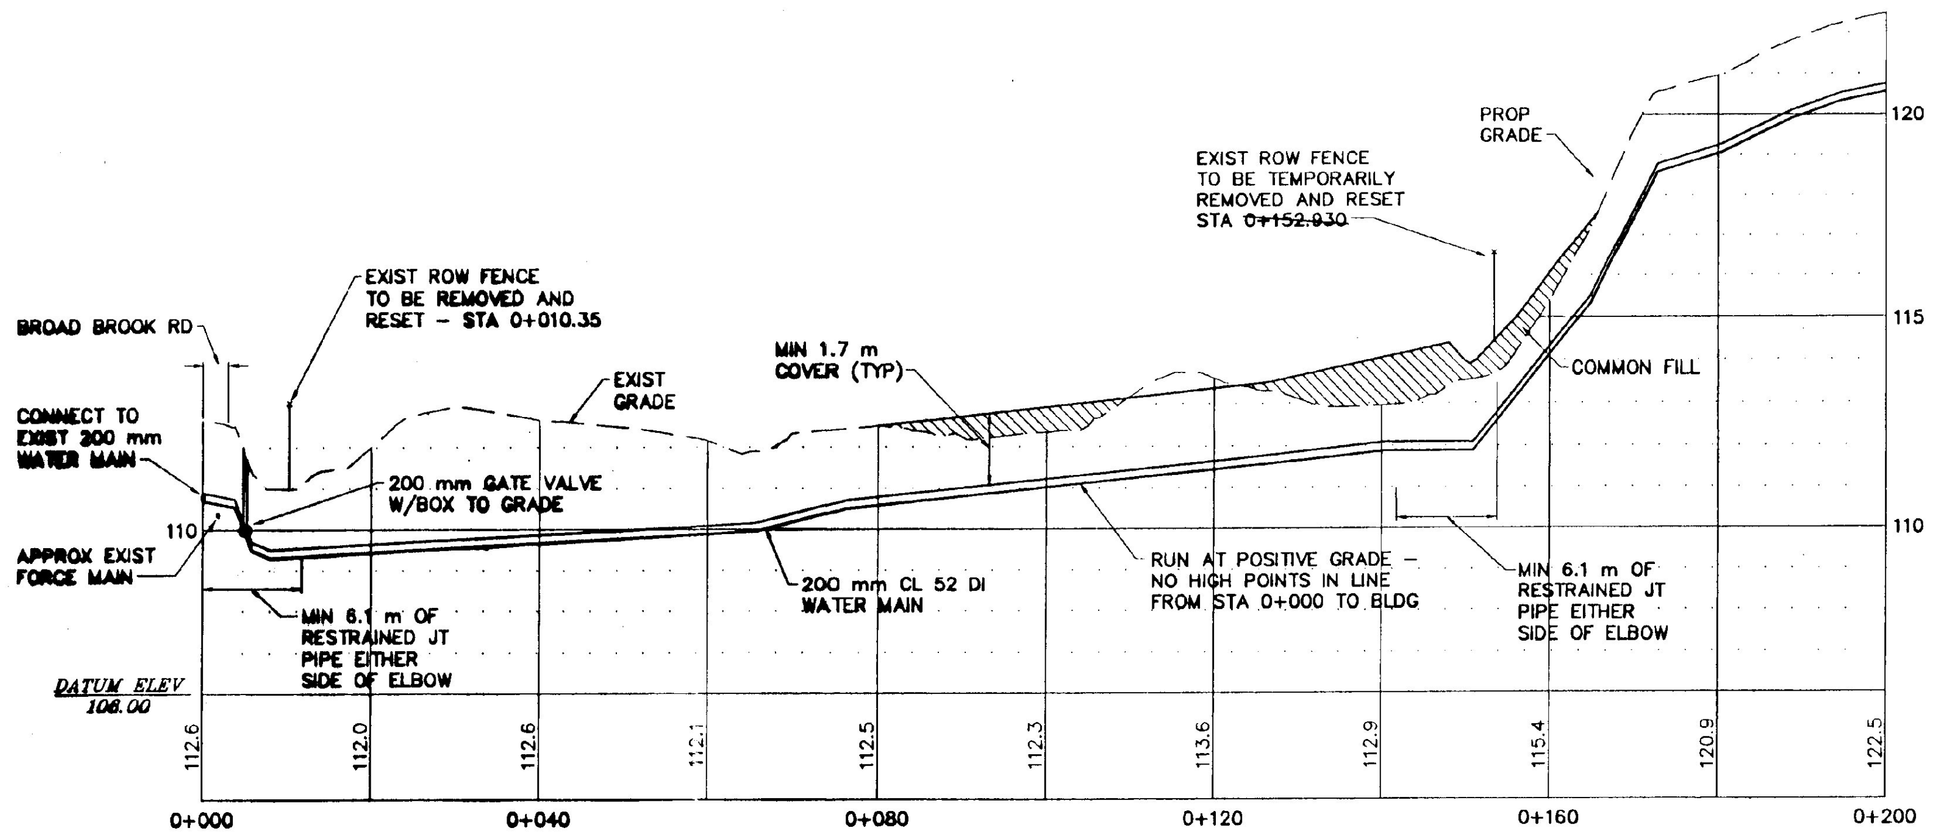

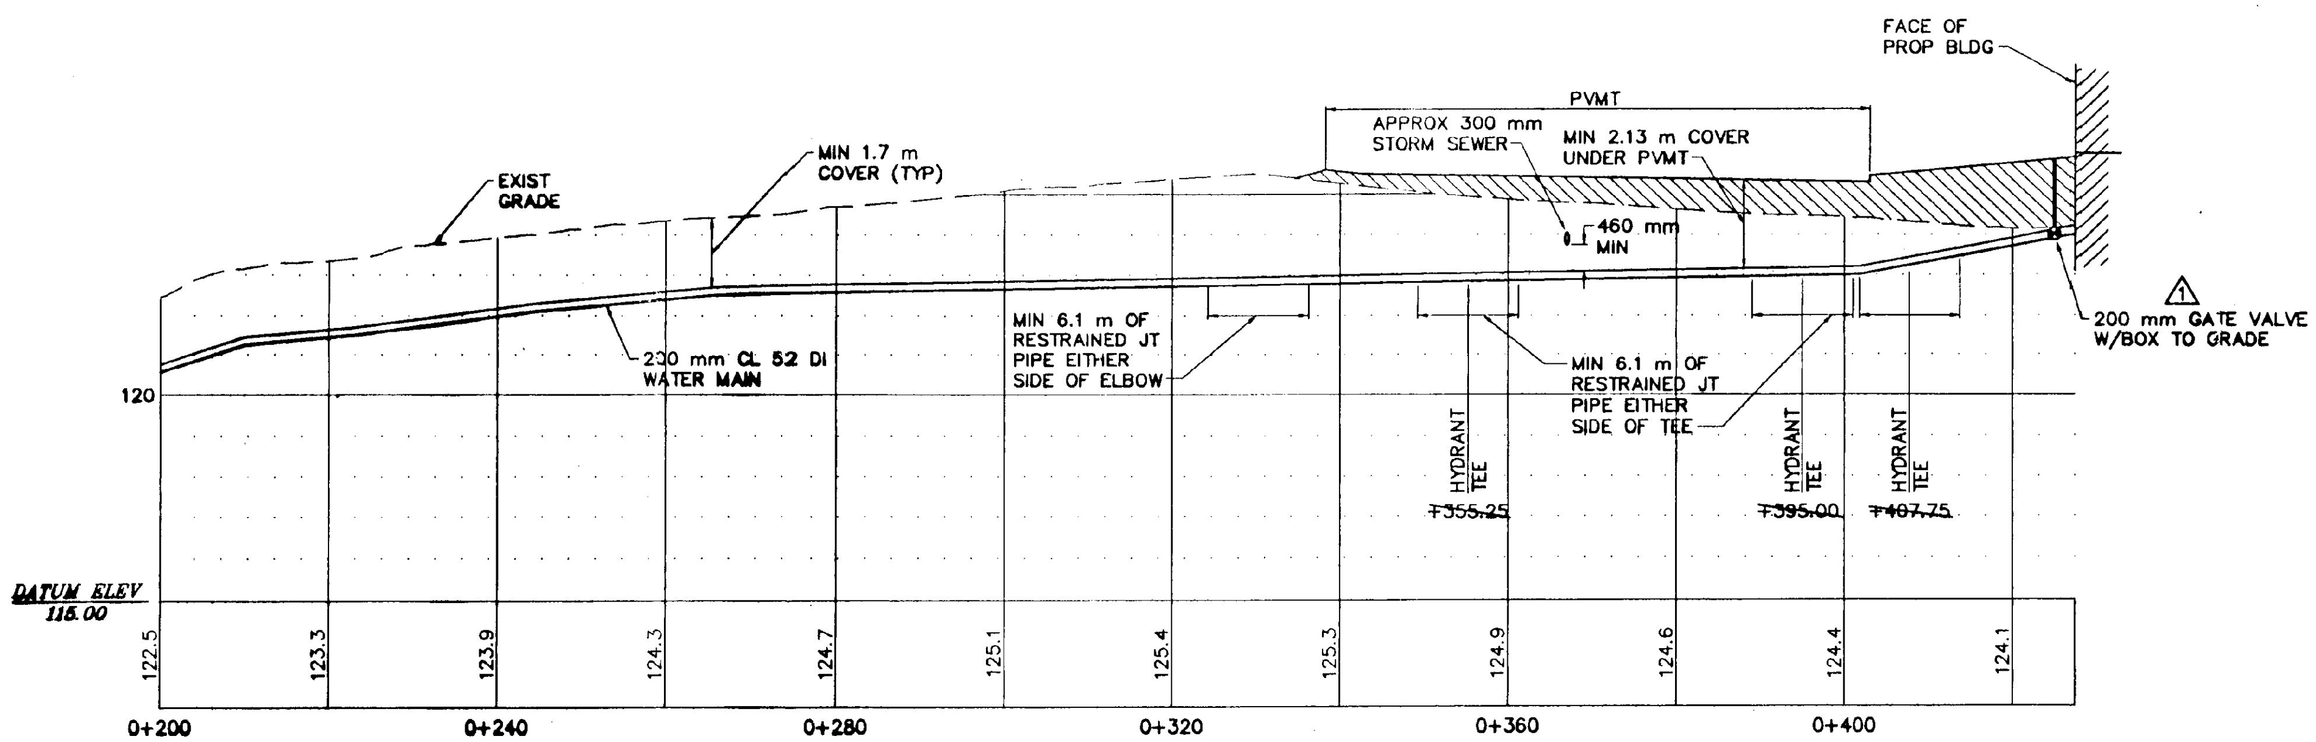

WATER MAIN PROFILE

SCALE: 1:500 H
1:100 V

RECORD DRAWING

SHOWN PICTORALLY
MAY NOT BE TO SCALE

THESE AS-BUILT OR RECORD DRAWINGS HAVE BEEN PREPARED, IN PART, ON THE BASIS OF INFORMATION COMPILED AND FURNISHED BY OTHERS. THE ENGINEER WILL NOT BE RESPONSIBLE FOR ANY ERRORS OR OMISSIONS WHICH HAVE BEEN INCORPORATED INTO THIS DOCUMENT AS A RESULT OF INFORMATION BY OTHERS.

Metric

NO.	DATE	REVISIONS	DRWN	CHKD
2	12/98	NO AS-BUILT INFORMATION ADDED	DSM	KAS
1	2/19/98	REVISIONS PER BGS/FHWA REVIEW	DSM	KAS

TIMOTHY D. SMITH & ASSOCIATES, PC ARCHITECTS
OLD RAILROAD STATION
802-442-8184
NORTH BENNINGTON, VERMONT 05257
FAX 802-442-5241

WRIGHT ENGINEERING, LTD.
CIVIL ENGINEERS
128 MERCHANTS ROW – P.O. BOX 176
RUTLAND, VERMONT 05702-0176
802-775-2511 FAX 775-2515

ROBT W. HALL
CONSULTING ENGINEERS, INC.
540 MEADOW STREET EXTENSION, STE. 2
AGAWAM, MASSACHUSETTS 01001-0002
413-789-0960 FAX 789-3295

T.J. BOYLE AND ASSOCIATES
LANDSCAPE ARCHITECTS
201 COLLEGE STREET
BURLINGTON, VERMONT 05401
802-658-3555 FAX 863-1582

STATE OF VERMONT MARK P. YOUNGSTROM No. 2473 LICENSED PROFESSIONAL ENGINEER 1-25-00

PROJECT NO.IM 091-1 (30)

SOUTHEAST VERMONT WELCOME CENTER
GUILFORD, VERMONT

SHEET TITLE: WATER MAIN PROFILE

DSGN BY: JAC
DRWN BY: DSM
CHKD BY: JAC
CHKD BY: MPY

STATE OF VERMONT
AGENCY OF ADMINISTRATION
DEPARTMENT OF
BUILDINGS & GENERAL SERVICES

DATE: 1-16-98 SHEET NO._____OF_____SHEETS

C28

C:\ACAD12\95010N\95010C28A Thu Dec 16 15:17:15 1999