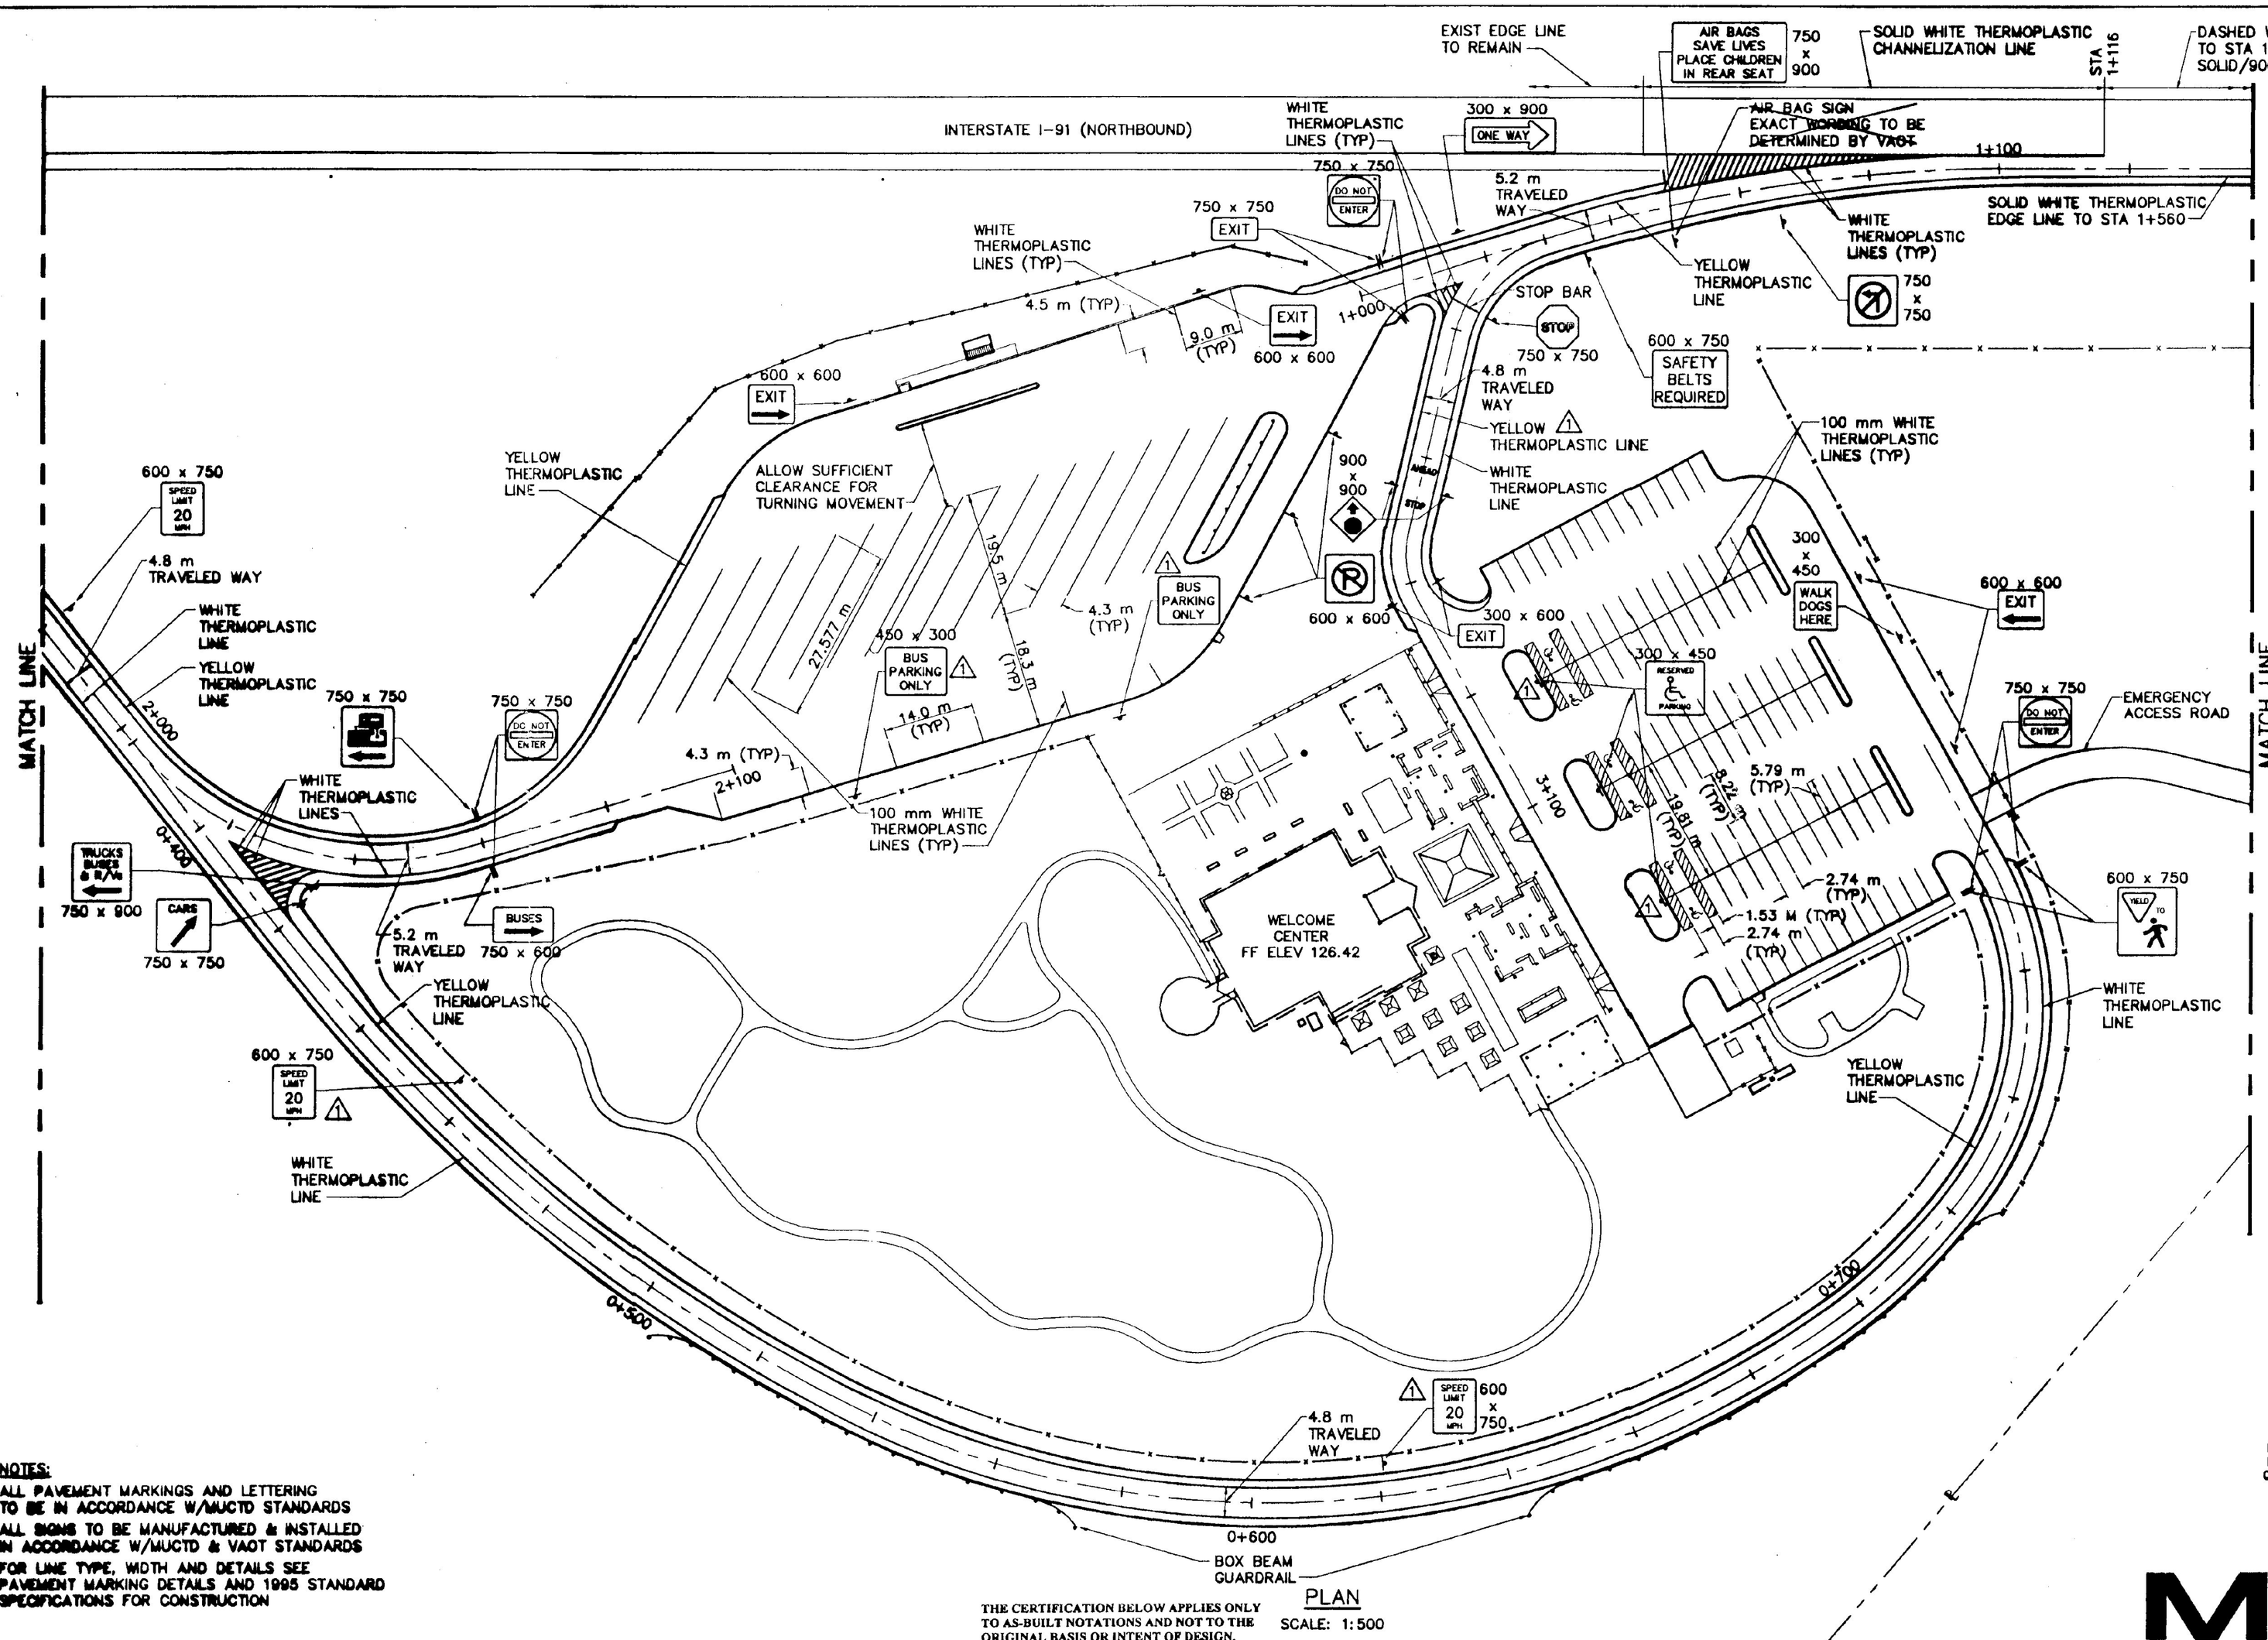

PLAN

SCALE: 1:500

NOTES:

1. ALL PAVEMENT MARKINGS AND LETTERING TO BE IN ACCORDANCE W/MUCTD STANDARDS
2. ALL SIGNS TO BE MANUFACTURED & INSTALLED IN ACCORDANCE W/MUCTD & VAOT STANDARDS
3. FOR LINE TYPE, WIDTH AND DETAILS SEE PAVEMENT MARKING DETAILS AND 1995 STANDARD SPECIFICATIONS FOR CONSTRUCTION

THE CERTIFICATION BELOW APPLIES ONLY TO AS-BUILT NOTATIONS AND NOT TO THE ORIGINAL BASIS OR INTENT OF DESIGN.

RECORD DRAWING

SHOWN PICTORALLY MAY NOT BE TO SCALE

THESE AS-BUILT OR RECORD DRAWINGS HAVE BEEN PREPARED, IN PART, ON THE BASIS OF INFORMATION COMPILED AND FURNISHED BY OTHERS. THE ENGINEER WILL NOT BE RESPONSIBLE FOR ANY ERRORS OR OMISSIONS WHICH HAVE BEEN INCORPORATED INTO THIS DOCUMENT AS A REBUILT OF INFORMATION BY OTHERS.

Metric

NO.	DATE	REVISIONS	DRWN	CHKD
2	12/98	AS-BUILT INFORMATION ADDED	DSM	KAS
1	2/18/98	REVISIONS PER BGS/FHwA REVIEW	DSM	KAS

TIMOTHY D. SMITH & ASSOCIATES, PC ARCHITECTS
OLD RAILROAD STATION
802-442-8184
NORTH BENNINGTON, VERMONT 05257
FAX 802-442-5241

WRIGHT ENGINEERING, LTD.
CIVIL ENGINEERS
188 MERCHANTS ROW - P.O. BOX 178
RUTLAND, VERMONT 05702-0178
802-775-2511 FAX 775-8815

ROBT W. HALL
CONSULTING ENGINEERS, INC.
648 MEADOW STREET EXTENSION, STE. 2
AGAWAM, MASSACHUSETTS 01001-0002
413-789-0860 FAX 789-3295

T.J. BOYLE AND ASSOCIATES
LANDSCAPE ARCHITECTS
301 COLLEGE STREET
BURLINGTON, VERMONT 05401
802-658-3555 FAX 863-1562

STATE OF VERMONT KEVIN A. SMITH No. 5864 REGISTERED PROFESSIONAL ENGINEER

PROJECT NO.IM 091-1 (30)
SOUTHEAST VERMONT WELCOME CENTER
GUILFORD, VERMONT

SHEET TITLE: PAVEMENT MARKING & SIGNAGE PLAN

DSGN BY: JAC
DRWN BY: DSM
CHKD BY: JAC
CHKD BY: JCO

STATE OF VERMONT
AGENCY OF ADMINISTRATION
DEPARTMENT OF
BUILDINGS & GENERAL SERVICES

DATE: 1-16-98 SHEET NO._____OF_____SHEETS

C31

C:\ACAD12\950IN\950IC31A Fr: Dec 17 10:26:31 1999