


Garden Planting

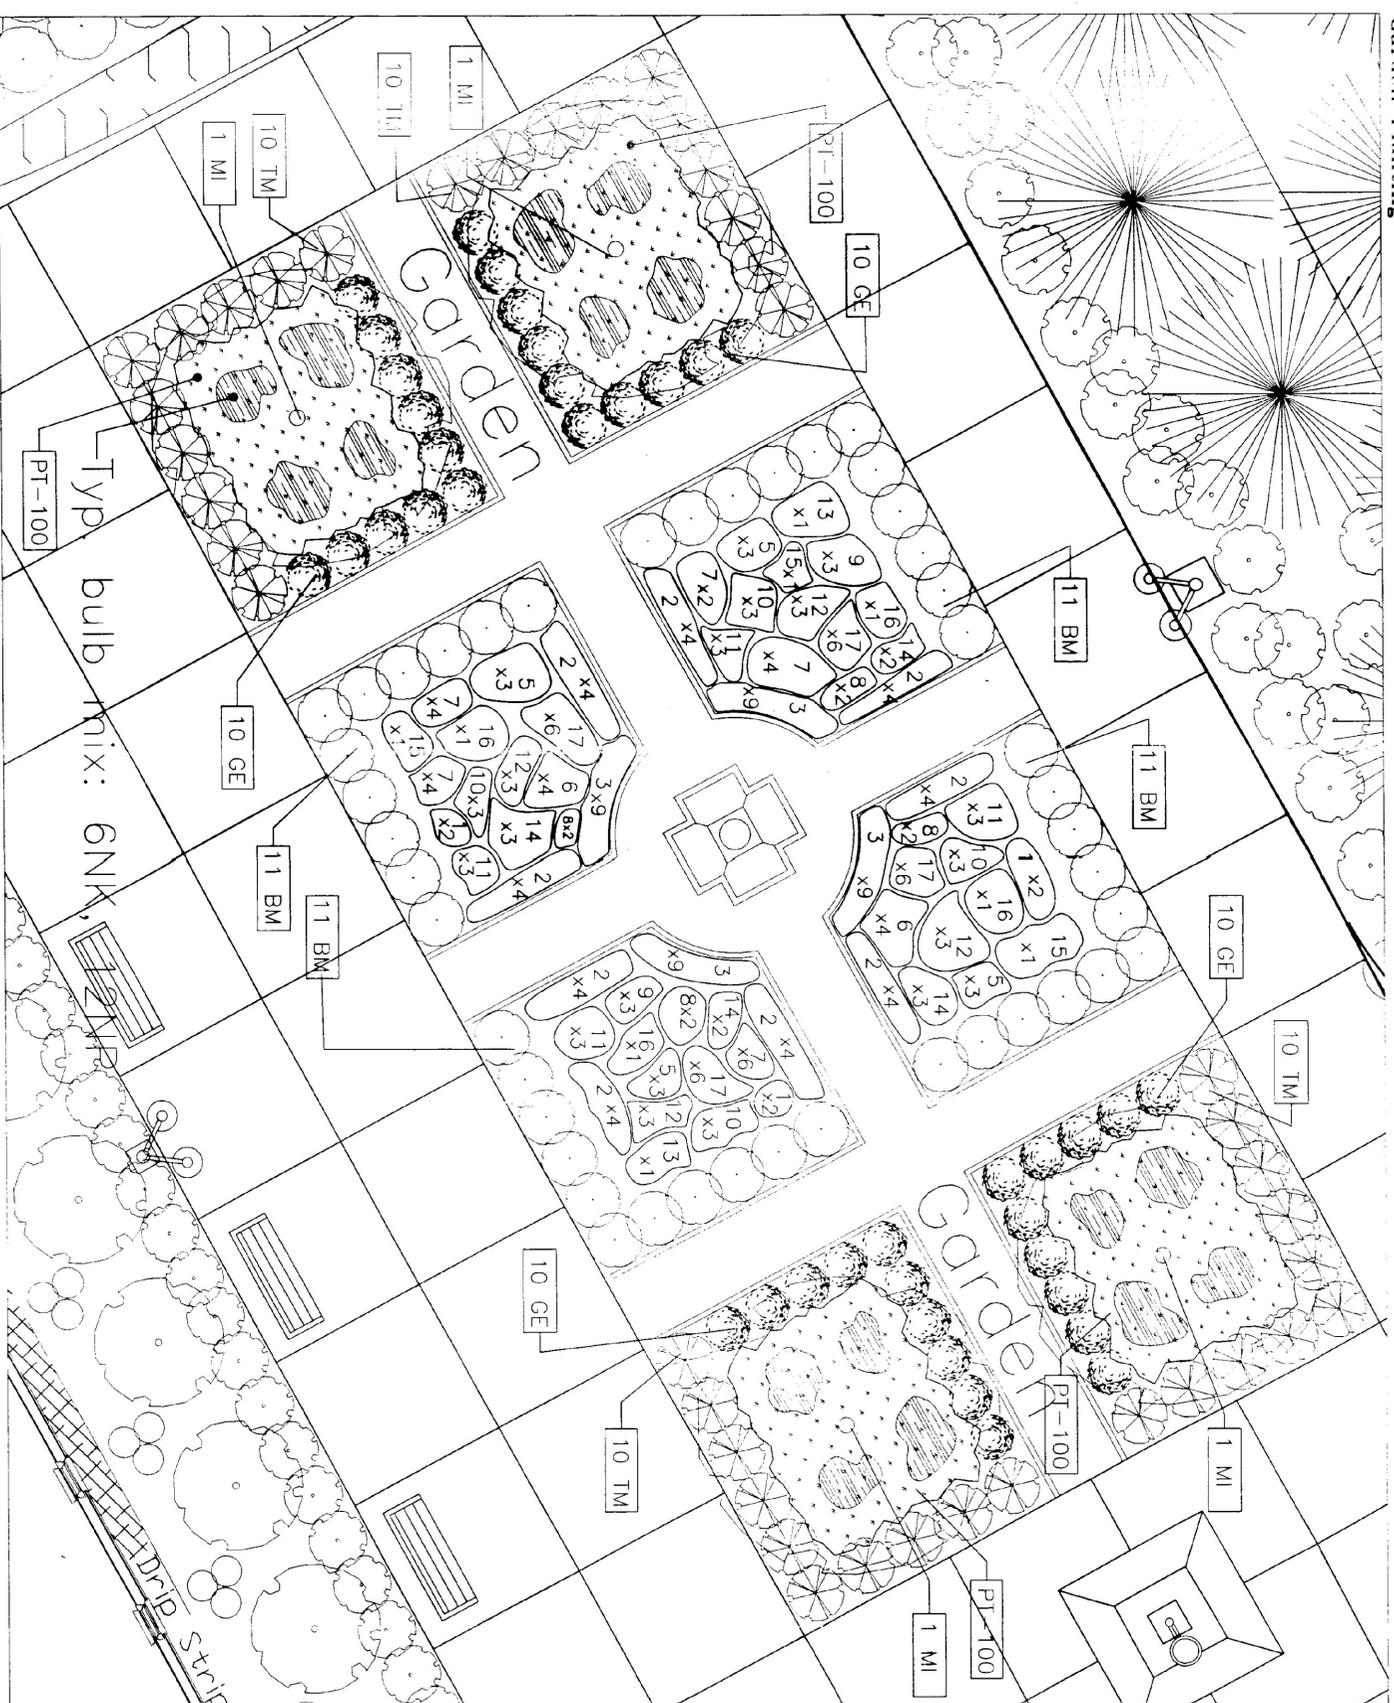


1:50

1-91 WELCOME CENTER
Garden Planting - Sheet 1.3

Qty	Code	Botanical Name	Common Name	Size	Note
8	1	Achillea yarrow 'Summer Shade Mix'	Hybrid Yarrow	16	
32	2	Alum. sativens var. 'Glacium'	Circle Onion	16	
36	3	Achimille Mollis 'improved form'	Lady's Mantle	16	
12	5	Sedum 'Autumn Joy'	Autumn Joy Sedum	16	
8	6	Aster 'frikartii 'Monarch'	Michauxias Daisy	16	
8	7	Aster 'roze-oranjie Purple Dome'	Purple Dome Aster	16	
8	8	Campanula carpatica Blue Chips	Carpathian Harebell	16	
6	9	Campanula persicifolia 'Tallons Beauty Blue'	Peach Leaved Bellflower	16	
12	10	Campanula persicifolia 'Tallons Beauty Blue'	Telham's Bellflower	16	
12	11	Leucanthemum vulgare 'Becky'	Becky Daisy	16	
12	12	Veronica spicata Sunny Border Blue	Sunny Border Blue Speedwell	16	
2	13	Rubuspecta fulvida 'Goldstrum'	Black-eyed Susan	16	
10	14	Coreopsis verticillata 'Moonbeam'	Moonbeam Tickseed	16	
4	15	Echinacea purpurea 'White Queen'	White Queen Coneflower	16	
4	16	Echinacea purpurea 'White Queen'	White Queen Coneflower	16	
24	17	Hemerocallis 'Stella D'Or'	Stella D'Or Daylily	16	

Qty	Code	Botanical Name	Common Name	Size	Note
44	BM	Bolus microphylla 'Green Gem'	Green Gem Boxwood	15-18" J6 Pol. @ 2' o.c.	
40	GE	Ceranium endressii 'Wargrove Pink'	Wargrove Pink Ceranium	16	2' o.c.
4	MI	Meicus 'Red Jade'	Red Jade Centaury	2.5-3" Col B & B. Spec. Multi 4	
100*	MK	Mc cussus King Alfred'	King Alfred Daffodil	10p Size 16 Drills of 6	
200*	MP	Mc cussus poeticus	Daffodil	2-1/4" pol 12 o.c.	10p Size 16 Drills of 12
400	PT	Pachysandra terminalis	Pachysandra	18-24" B & B 32" o.c.	
40	TM	Pa us medio densiflorus	Dense Japanese Yew	18-24" B & B 32" o.c.	

RECORD
DRAWING
Metric

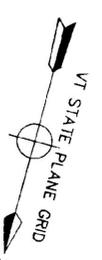

STATE OF VERMONT
AGENCY OF TRANSPORTATION
SOUTHEAST VERMONT WELCOME CENTER
CULFORD, VERMONT
13-2

TIMOTHY D. SMITH & ASSOCIATES, PC ARCHITECTS
OLD RAILROAD STATION
802-442-8184
NORTH BENNINGTON, VERMONT 05257
FAX 802-442-8241

ROBT W. HALL
CONSULTING ENGINEERS, INC.
LANDSCAPE ARCHITECTS
301 CANTON STREET
BURLINGTON, VERMONT 05401
802-698-8535
FAX 802-698-8535

WRIGHT ENGINEERING, LTD.
CIVIL ENGINEERS
128 MERCHANTS ROW - P.O. BOX 178
RUTLAND, VERMONT 05702-0178
802-775-5511
FAX 775-8015

PROJECT NO. IM 091-1 (30)
SOUTHEAST VERMONT WELCOME CENTER
FINAL DRAWINGS

DESIGN BY: TJB
DRAWN BY: PFB
CHECKED BY: PFB

DATE: 1/16/98
SHEET NO. OF SHEETS

NO. DATE REVISIONS
DRAWN CHECKD