




1 SPLIT RAIL GATE DETAIL
L7

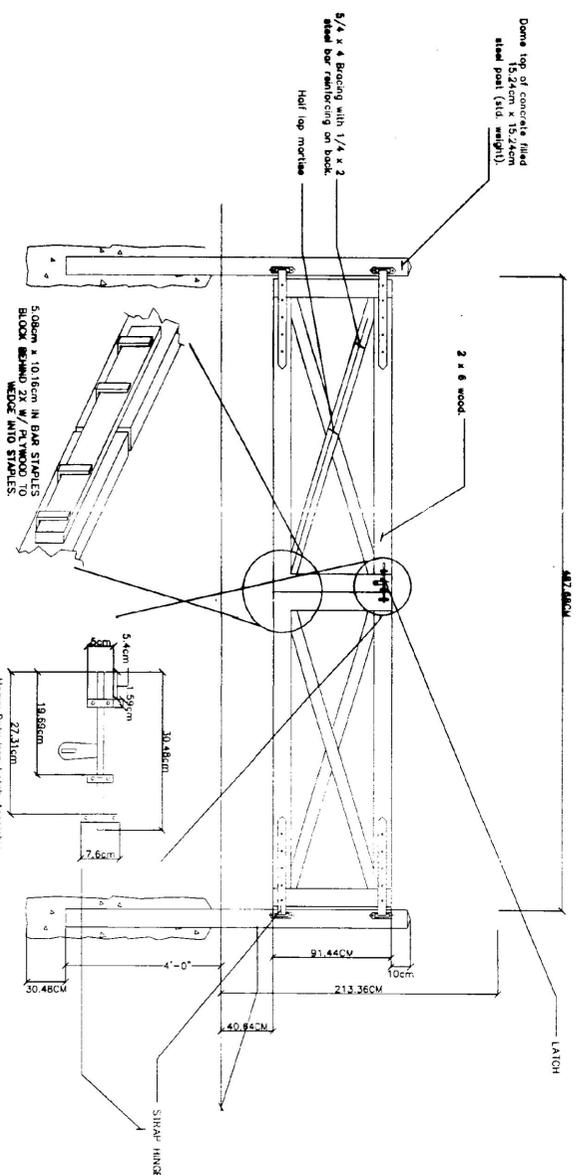

3 ACCESS ROAD GATE DETAIL
L7

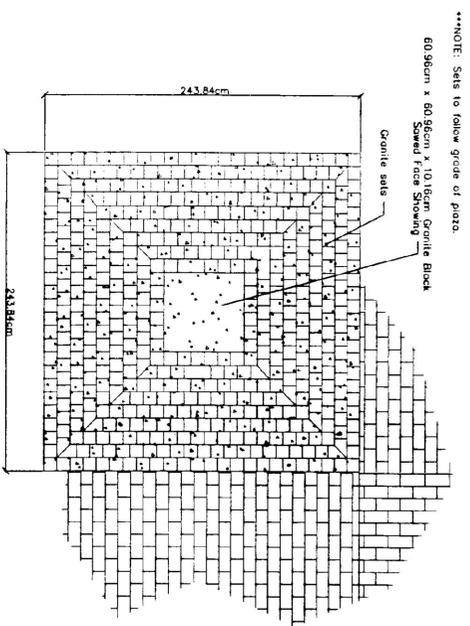

2 MOCK DRAIN INLET
L7

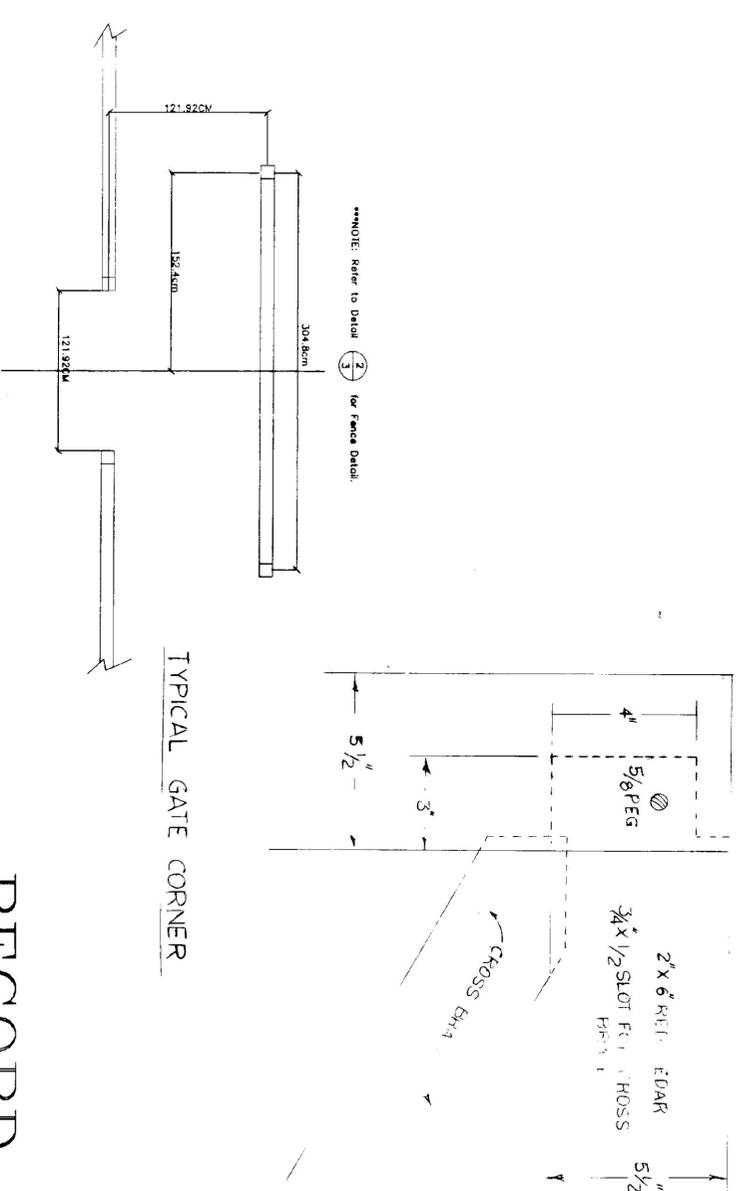

4 SPLIT RAIL FENCE SETBACK DETAIL
L7

RECORD
DRAWING
Metric
NTS

NO.	DATE	REVISIONS	DRWN	CHKD	<p>TIMOTHY D. SMITH & ASSOCIATES, PC ARCHITECTS OLD RAILROAD STATION 802-442-8184</p> <p>ROBT W. HALL CONSULTING ENGINEERS, INC. NORTH BENNINGTON, VERMONT 05257 FAX 802-442-9241</p> <p>T.J. BOYLE AND ASSOCIATES LANDSCAPE ARCHITECTS 54 GARDEN ST. 2ND FLOOR BURLINGTON, VERMONT 05401 TEL 802-858-3555 FAX 802-858-3555</p>
<p>PROJECT NO. JM 091-1 (30) SOUTHEAST VERMONT WELCOME CENTER FINAL DRAWINGS</p>					
<p>DESIGN BY: TJB DRAWN BY: PFB CHECKED BY: PFB</p>		<p>STATE OF VERMONT AGENCY OF TRANSPORTATION SOUTHEAST VERMONT WELCOME CENTER GUILDFORD, VERMONT</p>			
<p>DATE: 1/16/98</p>		<p>SHEET NO. _____ OF _____ SHEETS</p>			