

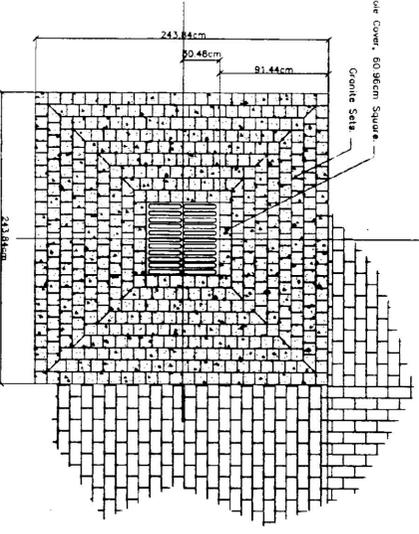
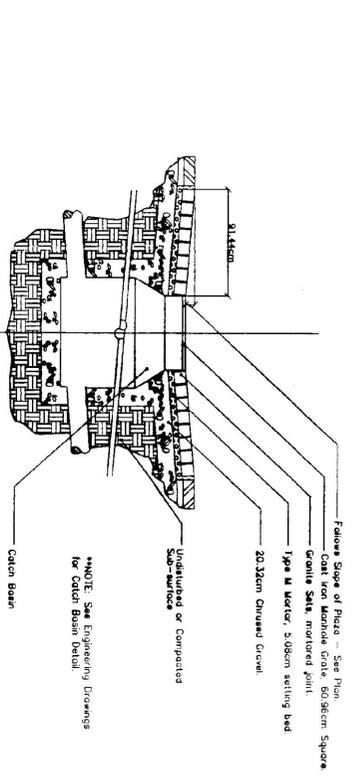



1 GRANITE TREE PLANTER DETAIL
L8

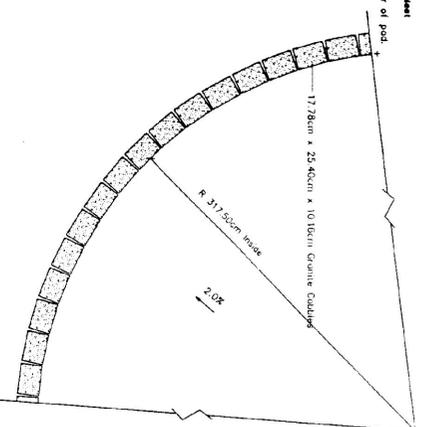

2 GRANITE DRAIN INLET DETAIL
L8

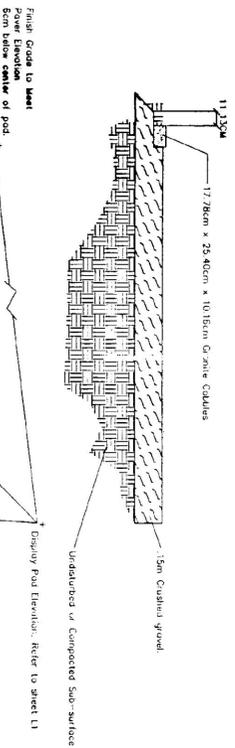

3 DISPLAY PAD DETAIL
L8

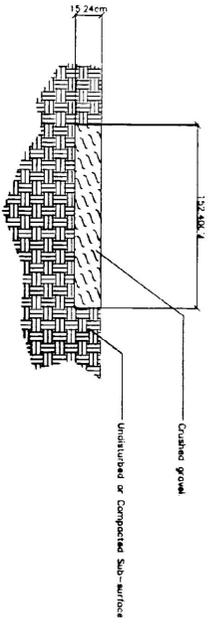

4 DISPLAY AREA PATH DETAIL
L8

RECORD
DRAWING

Metric NTS

NO.	DATE	REVISIONS	DRWN	CHKD	<p>TIMOTHY D. SMITH & ASSOCIATES, PC ARCHITECTS OLD RAILROAD STATION 802-442-8184</p> <p>WRIGHT ENGINEERING, LTD. CIVIL ENGINEERS 128 WASHINGTON ST. - P.O. BOX 174 BURLINGTON, VERMONT 05401-0002 TEL 776-8018 FAX 776-8018</p> <p>ROBT W. HALL CONSULTING ENGINEERS, INC. 140 MADISON STREET BURLINGTON, VT 5 BURLINGTON, VERMONT 05401 TEL 789-3896 FAX 893-1582</p> <p>T.J. BOYLE AND ASSOCIATES LANDSCAPE ARCHITECTS 301 COLLEGE STREET BURLINGTON, VERMONT 05401 TEL 863-3535 FAX 863-1582</p>
<p>PROJECT NO. IM 091-1 (30) SOUTHEAST VERMONT WELCOME CENTER FINAL DRAWINGS</p>					
<p>DSGN BY: TJB DRWN BY: PFB CHKD BY: PFB</p>		<p>STATE OF VERMONT AGENCY OF TRANSPORTATION SOUTHEAST VERMONT WELCOME CENTER GUILFORD, VERMONT</p>			
<p>DATE: 1/18/98</p>		<p>SHEET NO. _____ OF _____ SHEETS</p>			

L8