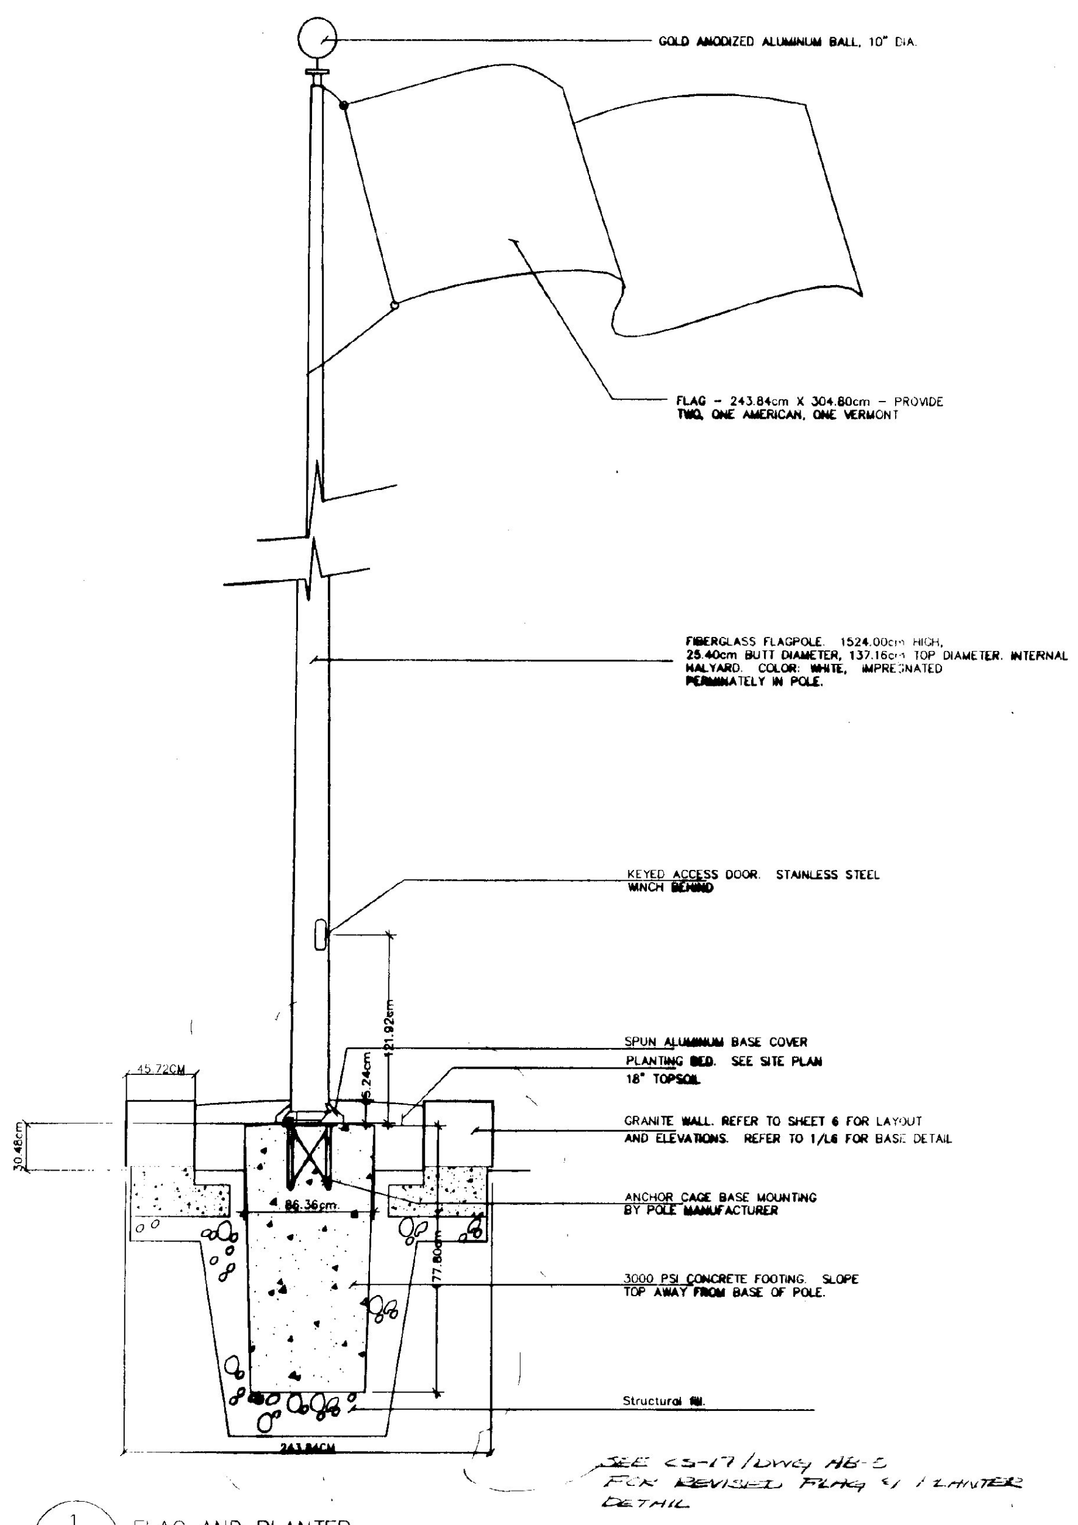

1 / L9 FLAG AND PLANTER

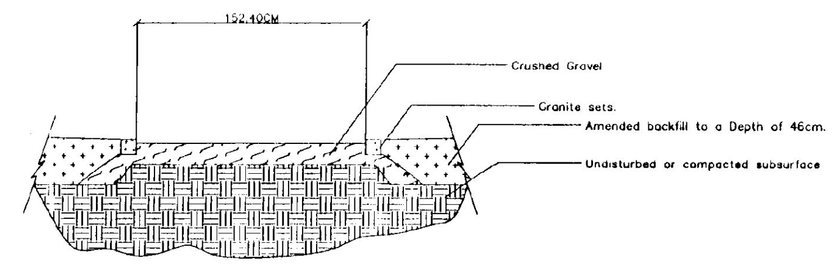

2 / L9 GARDEN PATH DETAIL

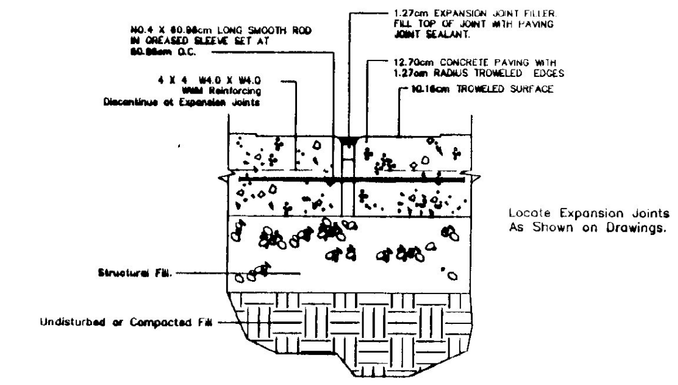

3 / L9 EXPANSION JOINT

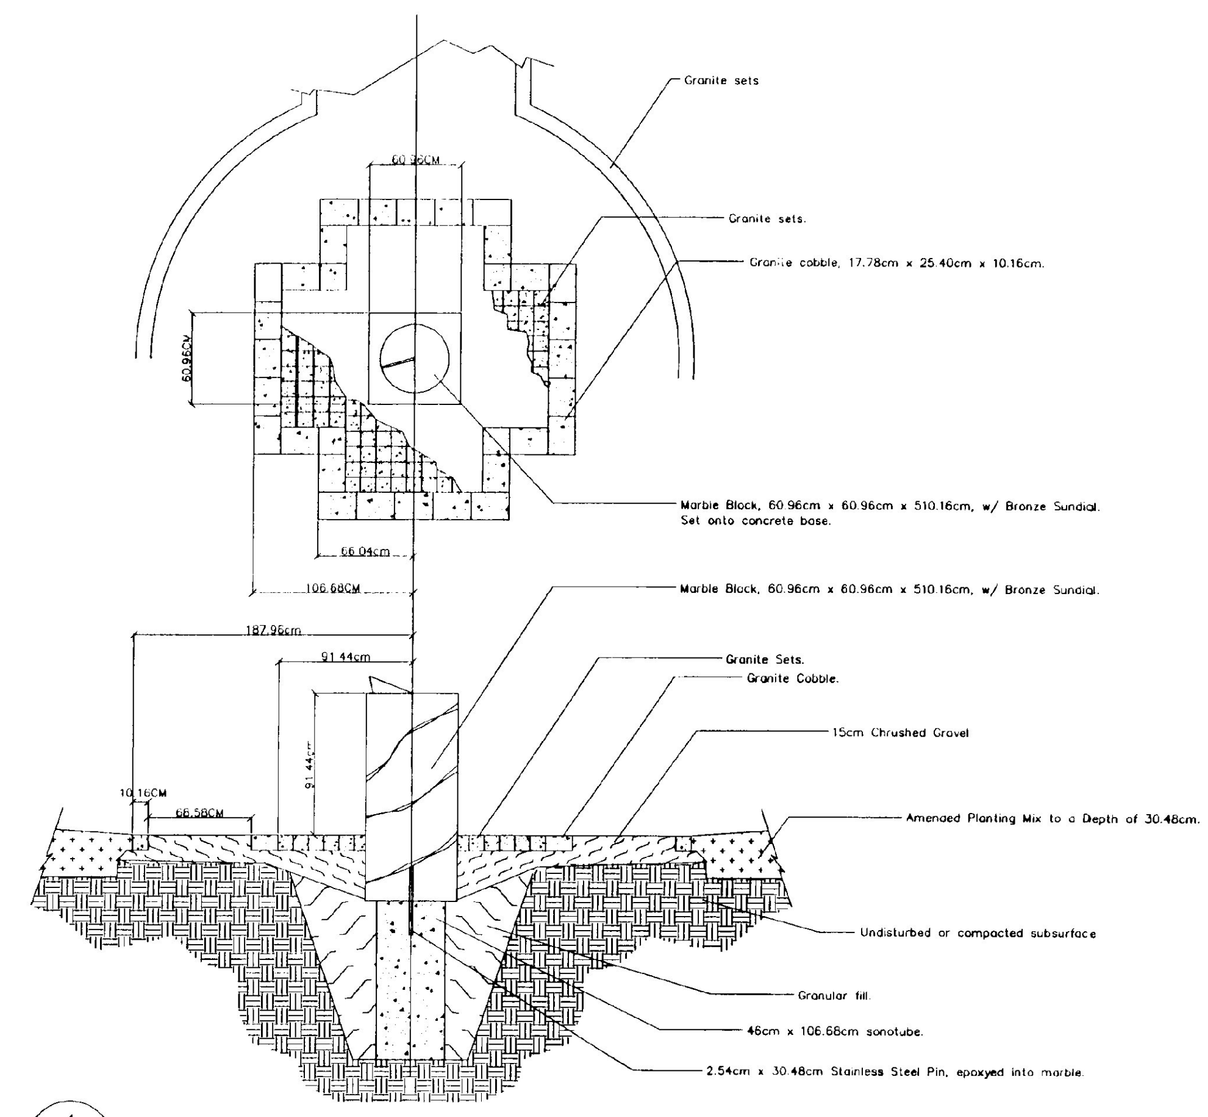

4 / L9 SUNDIAL AND PATH DETAIL

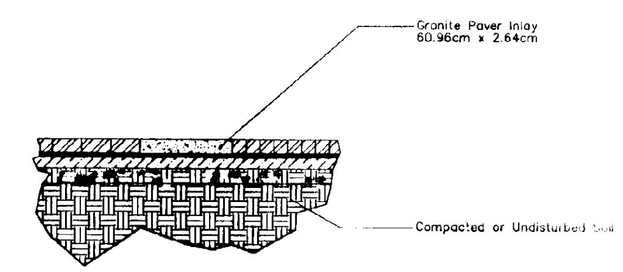

5 / L9 GRANITE PAVER INLAY

RECORD DRAWING

Metric NTS

NO.	DATE	REVISIONS	DRWN	CHKD

TIMOTHY D. SMITH & ASSOCIATES, PC ARCHITECTS
OLD RAILROAD STATION, NORTH BENNINGTON, VERMONT 05257
802-442-8184, FAX 802-442-5241

WRIGHT ENGINEERING, LTD. — CIVIL ENGINEERS — 126 MERCHANTS ROW - P.O. BOX 176, RUTLAND, VERMONT 05702-0176, 802-775-2611, FAX 775-8016
ROBT W. HALL — CONSULTING ENGINEERS, INC. — 640 MEADOW STREET EXTENSION, STE. 2, AGAWAM, MASSACHUSETTS 01001-0002, 413-789-0580, FAX 789-2886
T.J. BOYLE AND ASSOCIATES — LANDSCAPE ARCHITECTS — 301 COLLEGE STREET, BURLINGTON, VERMONT 05401, 802-658-3555, FAX 863-1562

PROJECT NO.IM 091-1 (30)
SOUTHEAST VERMONT WELCOME CENTER
FINAL DRAWINGS

SHEET TITLE: LANDSCAPE DETAILS

DSGN BY: TJB
DRWN BY: PFB
CHKD BY: PFB
CHKD BY: TJB

STATE OF VERMONT
AGENCY OF TRANSPORTATION
SOUTHEAST VERMONT WELCOME CENTER
GUILFORD, VERMONT

DATE: 1/16/98 SHEET NO._____OF_____SHEETS

L9