




1 GARDEN BENCH, DRIP STRIP & PLANTER DETAIL  
L10

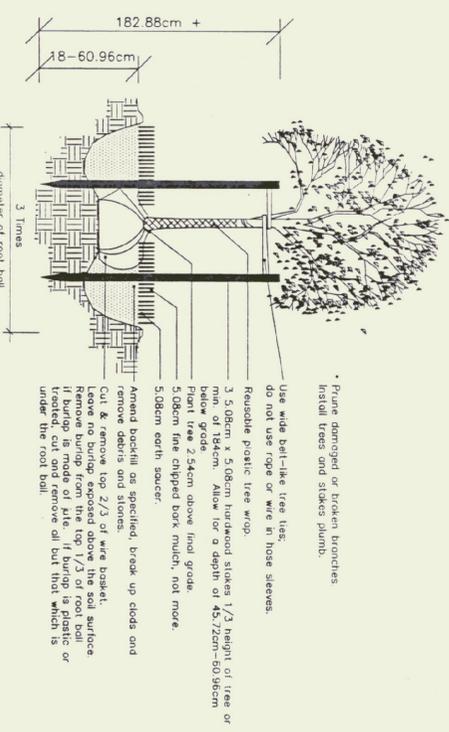


2 PLANTING DETAIL 5.08cm TREES OR LARGER  
L10

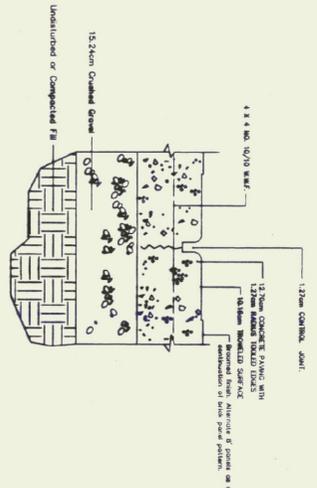

3 CONTROL JOINT  
L10

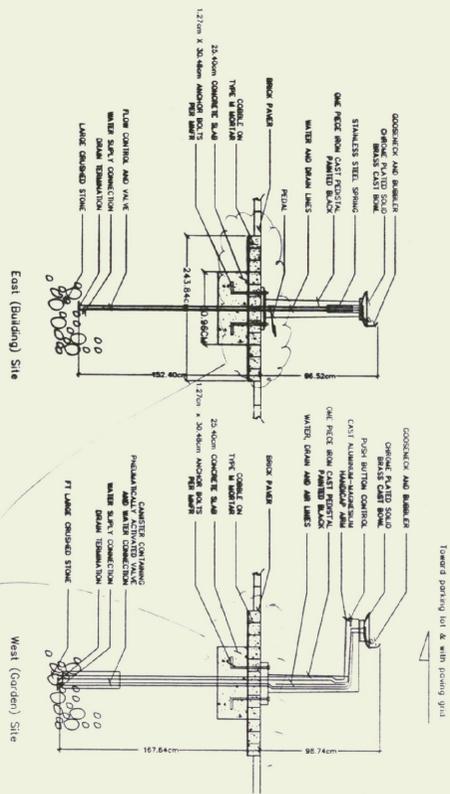

4 DRINKING FOUNTAIN DETAIL  
L10

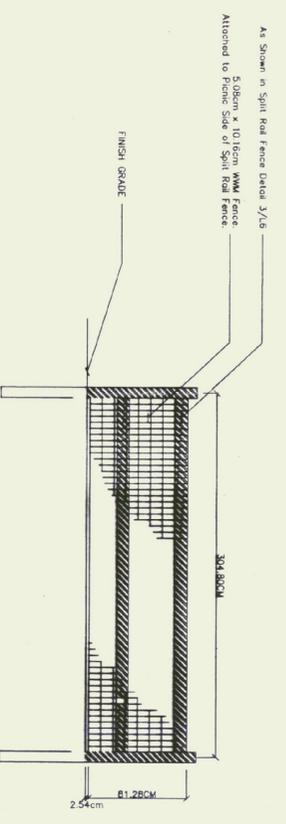

5 SPLIT RAIL FENCE W/ WMM BACKING DETAIL  
L10

NO.	DATE	REVISIONS	DRWN	CHKD

TIMOTHY D. SMITH & ASSOCIATES, PC ARCHITECTS  
 OLD RAILROAD STATION  
 802-442-8184  
 NORTH BENNINGTON, VERMONT 05257  
 FAX 802-442-6241

WRIGHT ENGINEERING, LTD.  
 100 MORGAN AVENUE - P.O. BOX 178  
 802-778-2811  
 CIVIL ENGINEERS

ROBT W. HALL  
 CONSULTING ENGINEERS, INC.  
 640 MADISON STREET EXTENSION, STE. 2  
 BURLINGTON, VERMONT 05401  
 802-778-0980  
 LANDSCAPE ARCHITECTS

T.J. BOYLE AND ASSOCIATES  
 301 COLLIER STREET  
 BURLINGTON, VERMONT 05401  
 802-688-3665  
 LANDSCAPE ARCHITECTS

PROJECT NO. IM 091-1 (30)  
 SOUTHEAST VERMONT WELCOME CENTER  
 FINAL DRAWINGS

DESIGN BY: TJB  
 DRAWN BY: PFB  
 CHECKED BY: PFB

STATE OF VERMONT  
 AGENCY OF TRANSPORTATION  
 SOUTHEAST VERMONT WELCOME CENTER  
 GUILFORD, VERMONT

DATE: 1/16/98  
 SHEET NO. \_\_\_\_\_ OF \_\_\_\_\_ SHEETS

RECORD  
 DRAWING  
 METRIC  
 ARCHITECTS

L10