




1 SHRUB PLANTING DETAIL

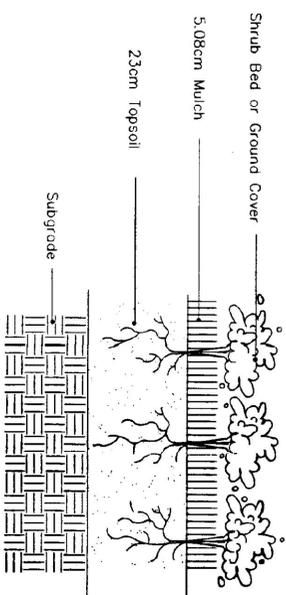

2 TYPICAL GROUNDCOVER PLANTING

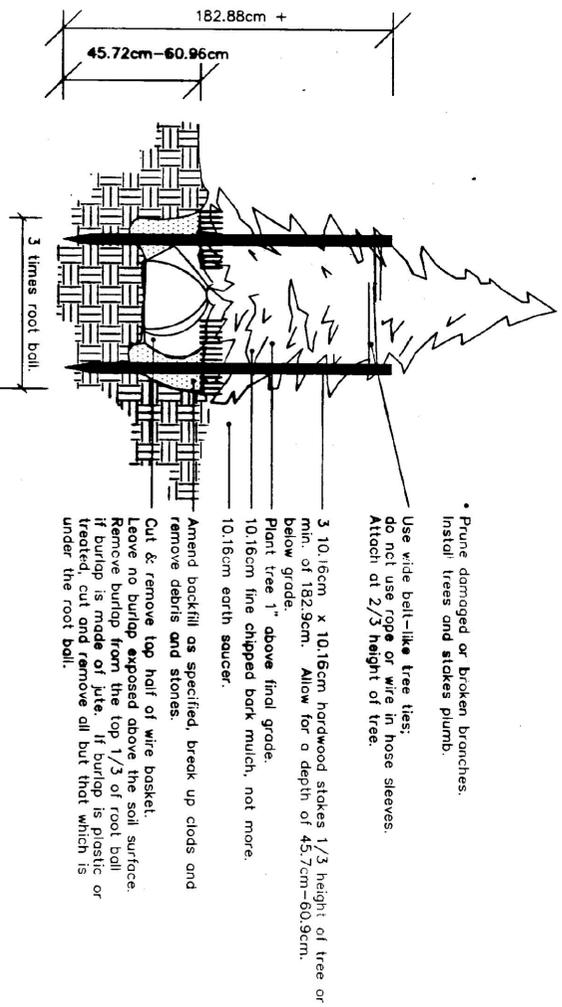

3 PLANTING DETAIL EVERGREEN TREES

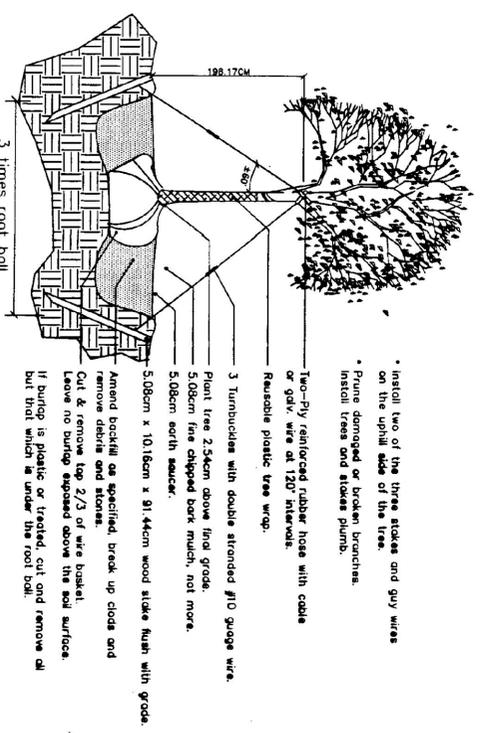

4 PLANTING DETAIL 7.62cm AND GREATER TREES

RECORD
DRAWING
Metric NTS

NO.	DATE	REVISIONS	DRWN	CHKD	TIMOTHY D. SMITH & ASSOCIATES, PC ARCHITECTS OLD RAILROAD STATION 802-442-8184	WRIGHT ENGINEERING, LTD. 150 WASHINGTON ST. - 3RD FLOOR BURLINGTON, VERMONT 05401 TEL: 776-2611 FAX: 776-2616	ROBT W. HALL CONSULTING ENGINEERS, INC. 640 WHEAT STREET BURLINGTON, VERMONT 05401 TEL: 776-2600 FAX: 776-2606	T.J. BOYLE AND ASSOCIATES LANDSCAPE ARCHITECTS 301 COLLEGE STREET BURLINGTON, VERMONT 05401 TEL: 863-1982 FAX: 863-1982
-----	------	-----------	------	------	--	--	---	---

PROJECT NO: IM 091-1 (30)	PROJECT TITLE: LANDSCAPE DETAILS
SOUTHEAST VERMONT WELCOME CENTER	
FINAL DRAWINGS	

DSGN BY: TJB	CHKD BY: TJB
DRWN BY: PFB	
CHKD BY: PFB	

STATE OF VERMONT	DATE: 1/16/98
AGENCY OF TRANSPORTATION	
SOUTHEAST VERMONT WELCOME CENTER	
GUILFORD, VERMONT	

111