


1 CRAWLSPACE PLAN
1/8" = 1'-0"

2 LOFT PLAN
1/8" = 1'-0"

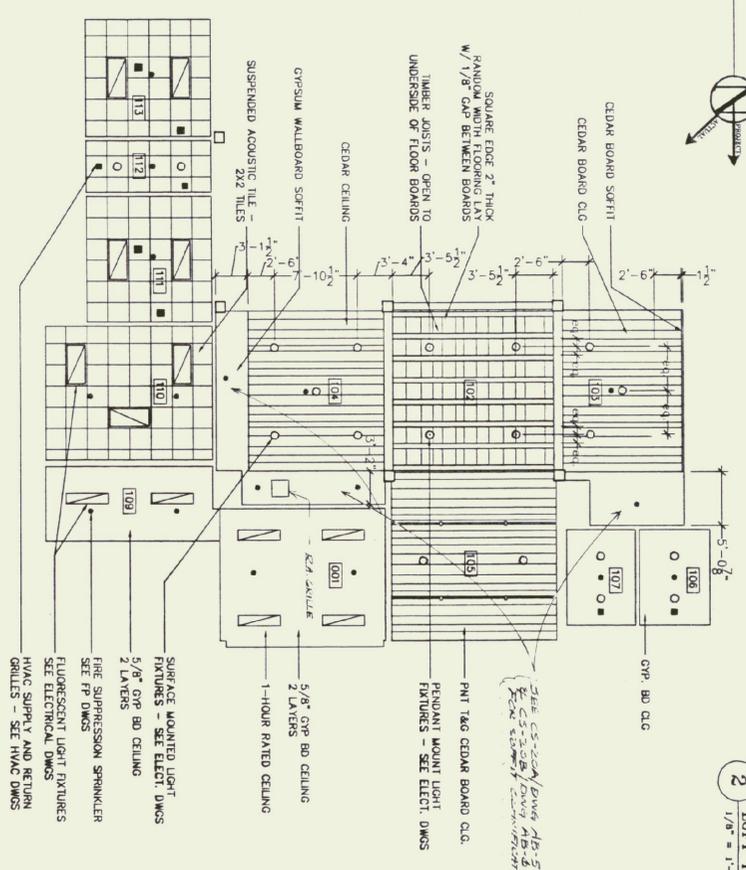

3 PARTIAL REFLECTED CEILING PLAN
1/8" = 1'-0"

RECORD
DRAWING
FINISH FLOOR 126.42M = 0'-0"
SEE PARTITION DETAILS SHEET A11


NO.	DATE	REVISIONS	DRAWN	CHKD

TIMOTHY D. SMITH & ASSOCIATES, PC ARCHITECTS
 OLD RAILROAD STATION
 802-442-8184

BRIGHT ENGINEERING, LTD.
 CIVIL ENGINEERS
 128 HUNTINGTON DR. - P.O. BOX 178
 BURLINGTON, VERMONT 05401-0178
 802-788-8411

ROBT W. HALL
 CONSULTING ENGINEERS, INC.
 540 HAZARD STREET EXTENSION, RTE. 2
 BURLINGTON, VERMONT 05401
 413-738-0800

T.J. BOYLE AND ASSOCIATES
 LANDSCAPE ARCHITECTS
 301 COLLEGE STREET
 BURLINGTON, VERMONT 05401
 802-444-3005

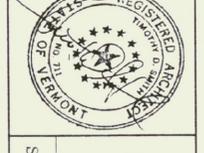

PROJECT NO. IM 091-1 (30)
 SOUTHEAST VERMONT WELCOME CENTER
 GUILFORD, VERMONT

SHEET TITLE: WLCM CNTR BLDG CRAWLSPACE & LOFT PLANS

DSGN BY:
 DRAWN BY:
 CHKD BY:

STATE OF VERMONT
 AGENCY OF ADMINISTRATION
 DEPARTMENT OF
 BUILDINGS & GENERAL SERVICES

DATE: 1-16-98

SHEET NO. _____ OF _____ SHEETS

A2