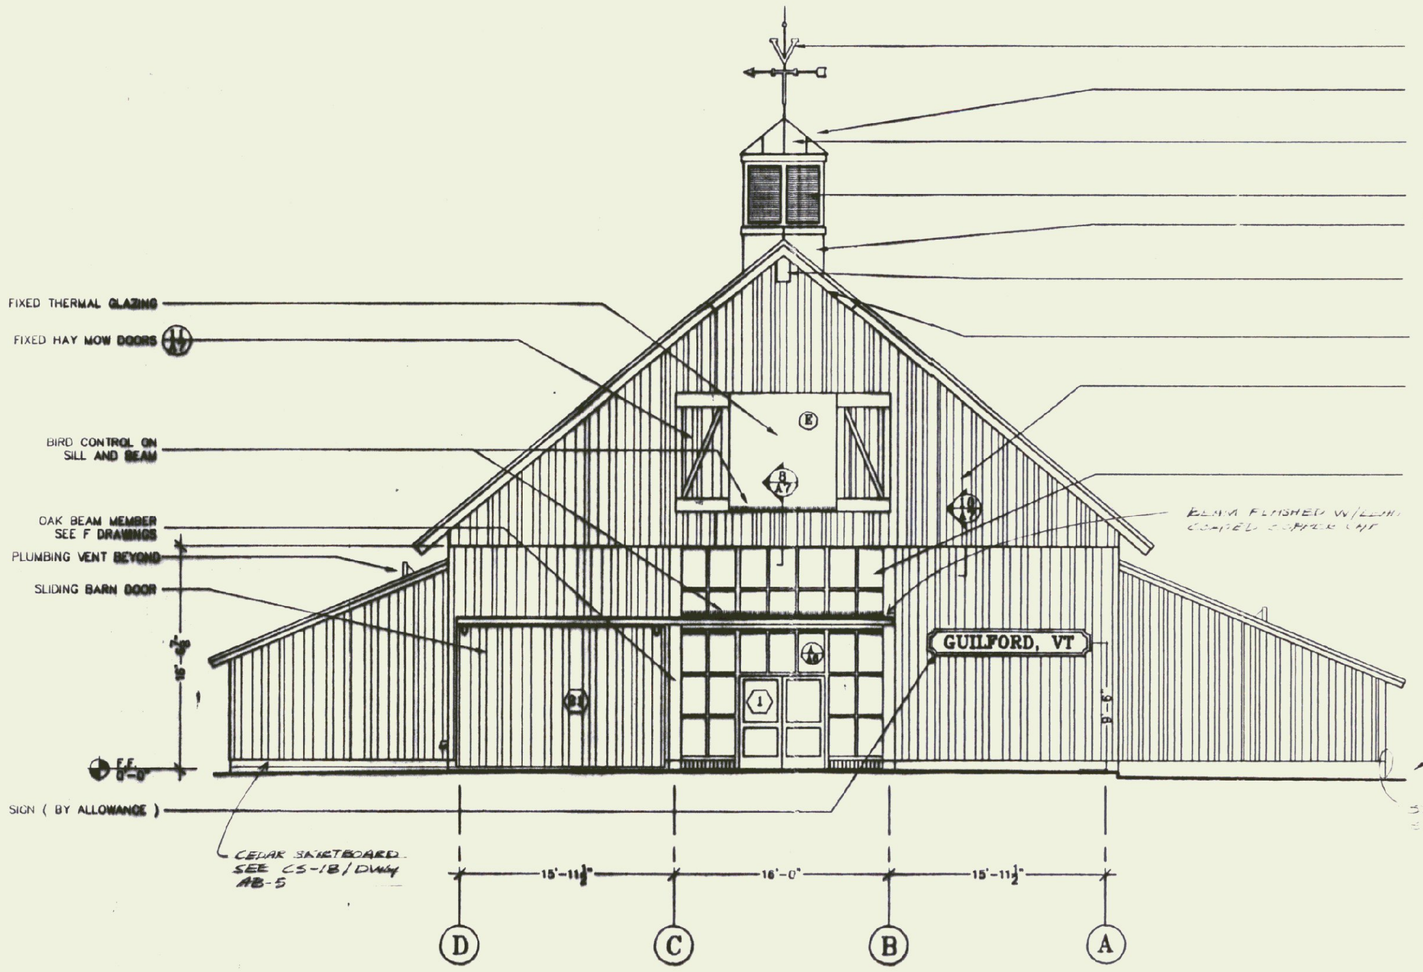

1 NORTH ELEVATION
1/8" = 1'-0"

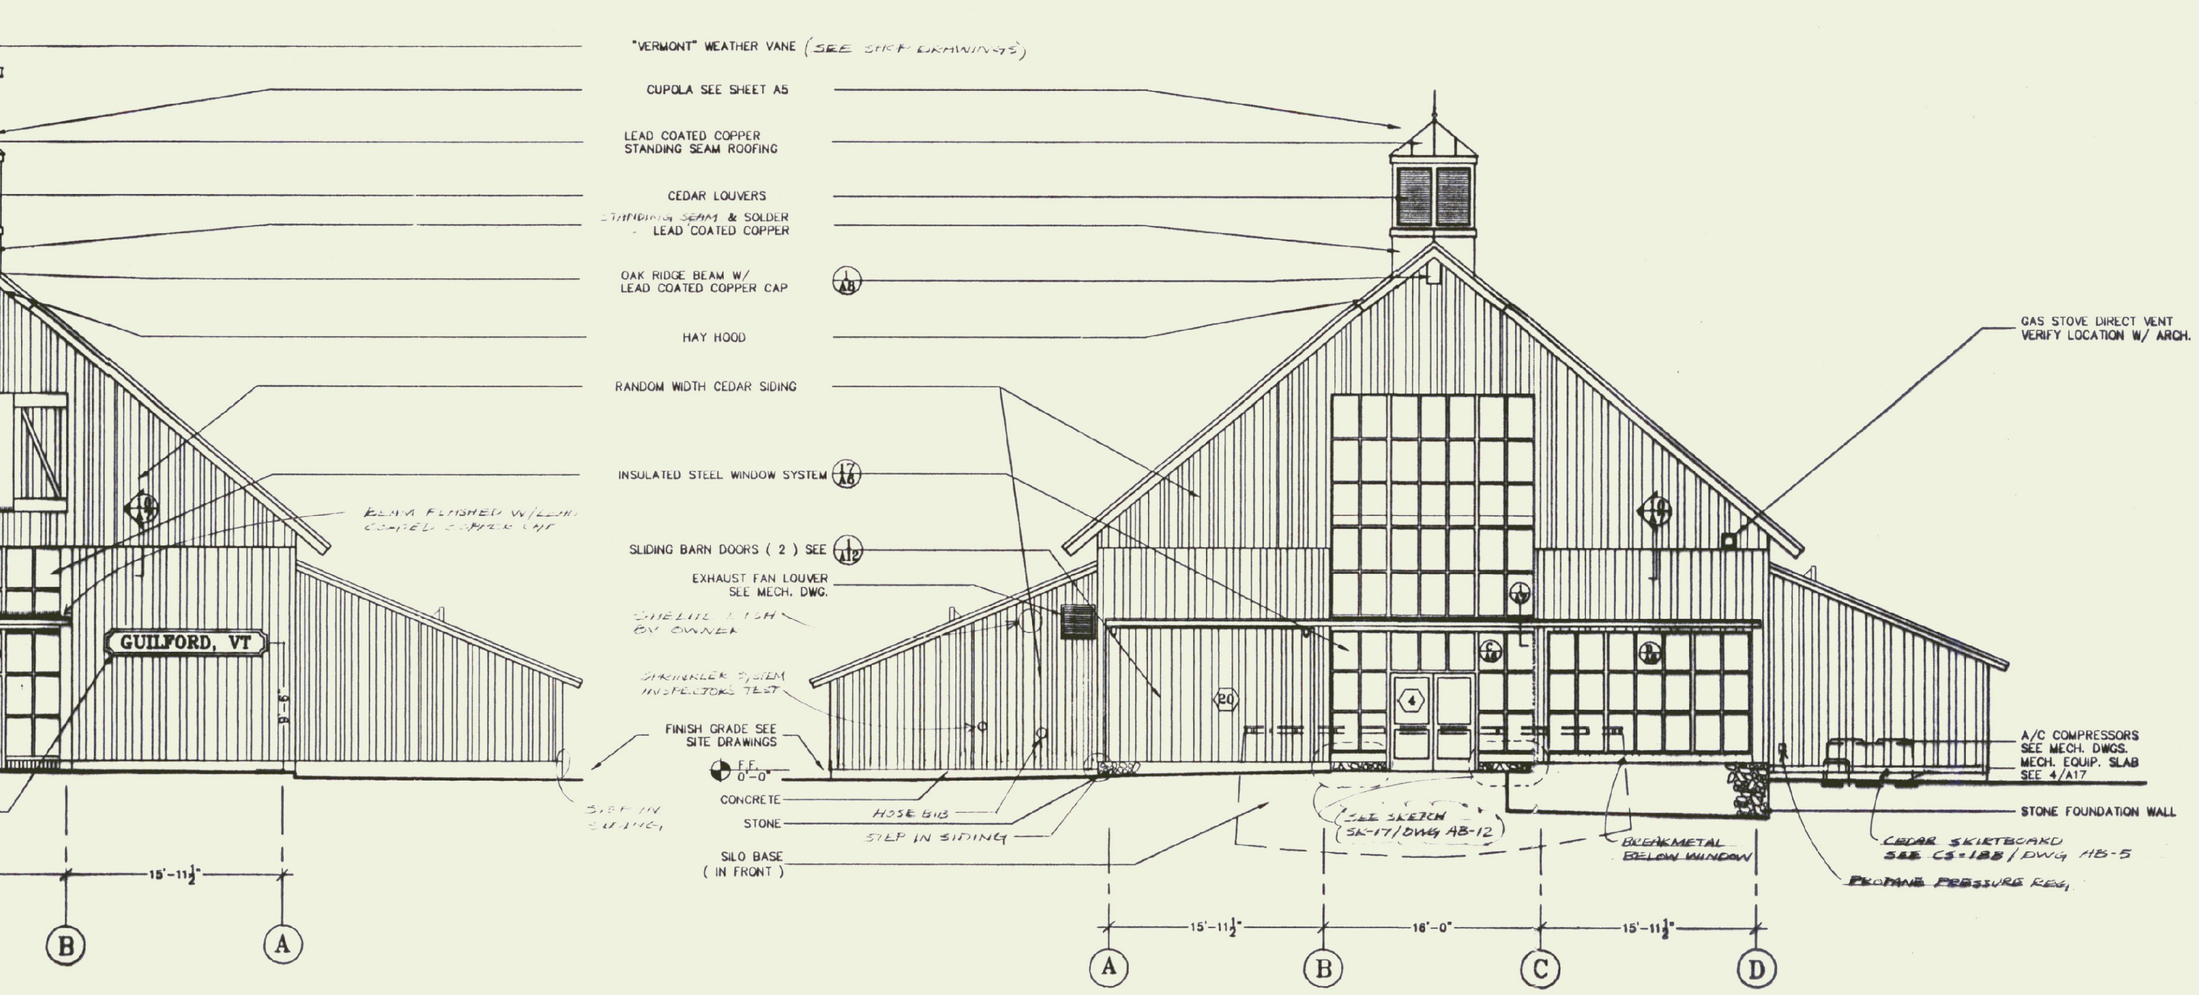

2 SOUTH ELEVATION
1/8" = 1'-0"

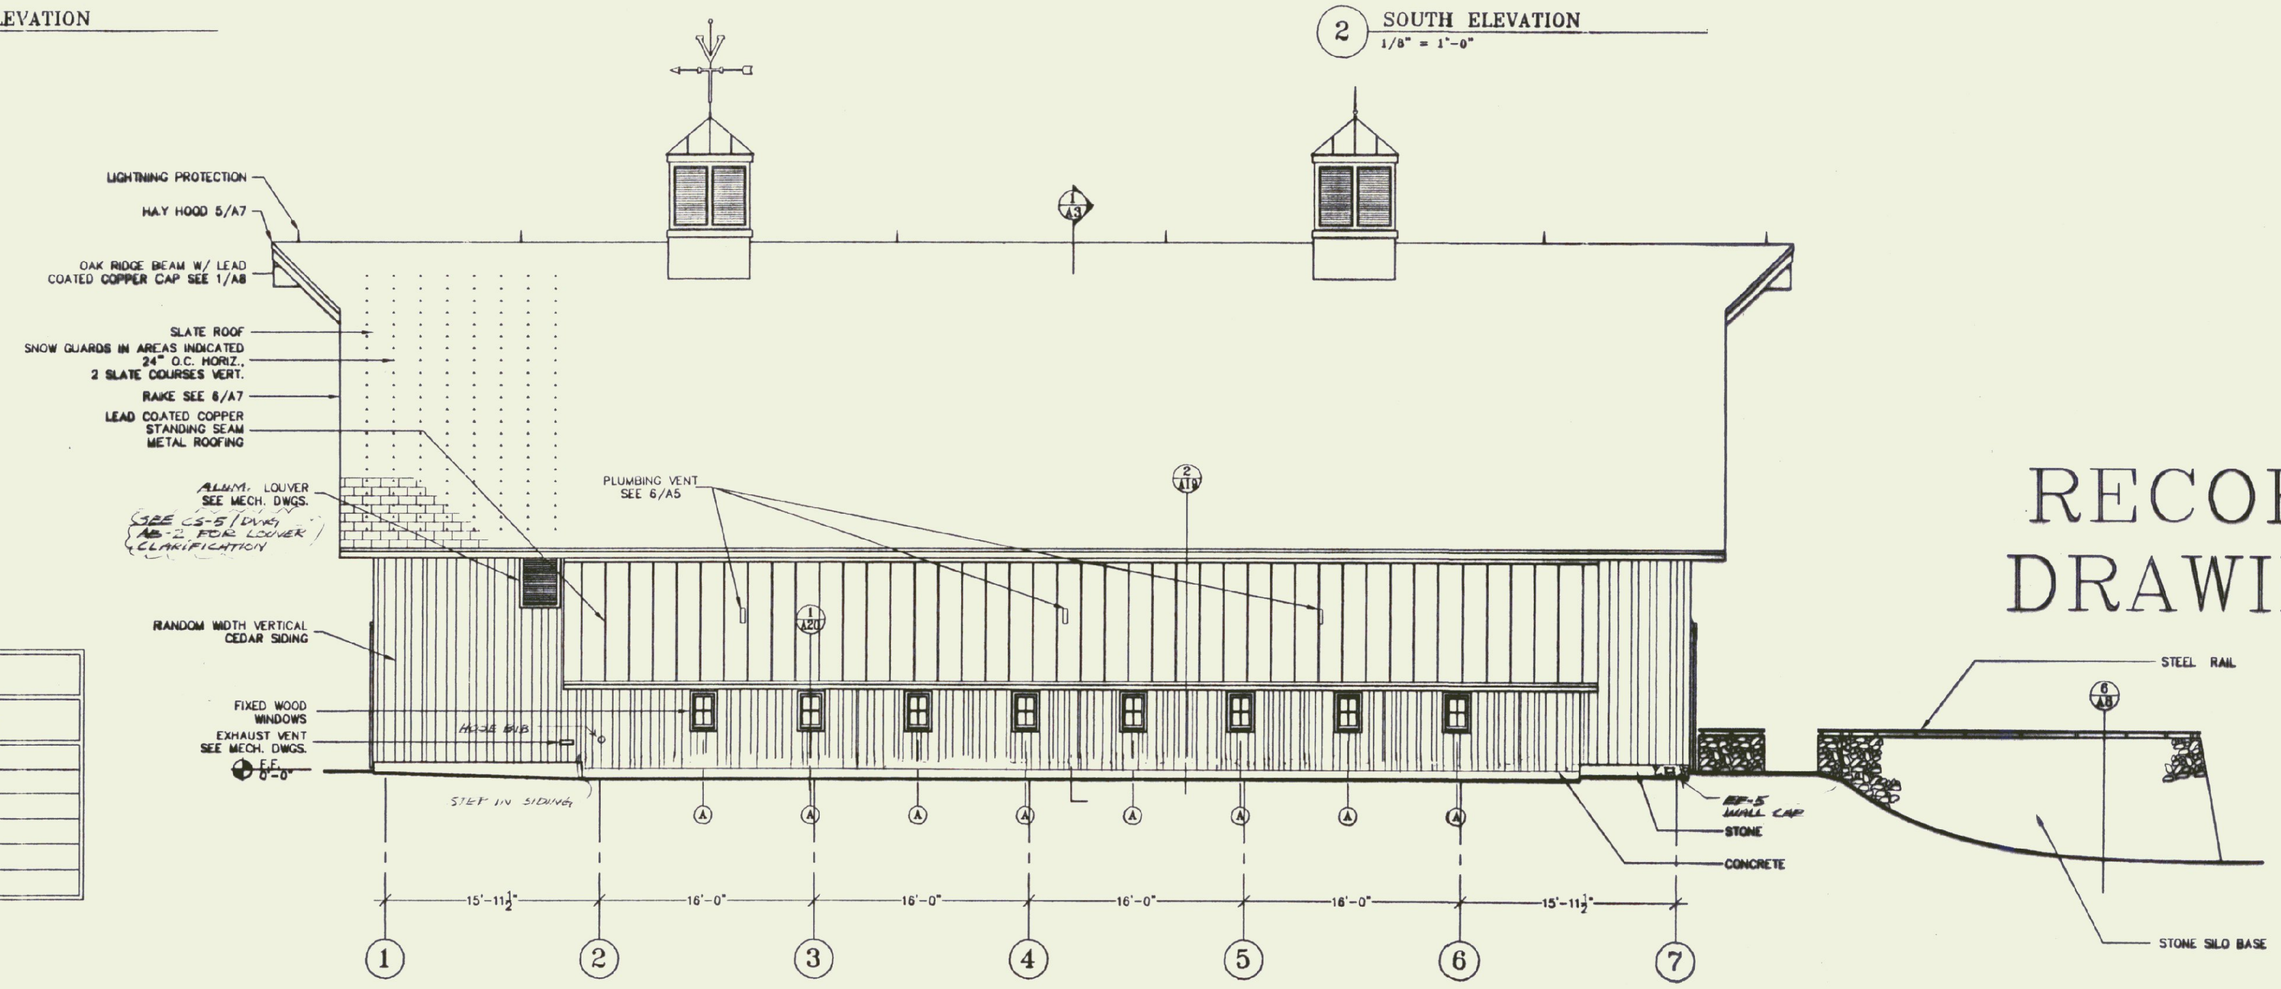

3 WEST ELEVATION
1/8" = 1'-0"

RECORD DRAWING

FINISH FLOOR 0'-0" = 126.42 METERS

WINDOW SCHEDULE – WELCOME CENTER

UNIT	TYPE	QUAN.	SIZE (WXH)	GLAZING	REMARKS
A	WOOD CASEMENT FIXED	8	1'-8" X 2'-8 1/16" (FRAME)	SINGLE GLAZED ABL W/ ENERGY	WITH INSECT SCREEN
B	WOOD CASEMENT OPERABLE	5	1'-8" X 2'-8 1/16" (FRAME)	PANEL OBSCURED GLASS	H
C	WOOD BARN SASH	12	11 1/4" X 1'-5 1/2" (F.V.)	SINGLE GLAZED OBSCURED GLASS	CUSTOM SIZE
D	SITE GLAZED	1	3'-5" X 3'-7" (F.V.)	SINGLE GLAZED TEMPERED	
E	SITE GLAZED	1	8'-2" X 8'-12 1/8" (F.V.)	1" INSULATED - LOW E	SEE DETAILS SHEET A7
F	FIXED SKYLIGHT	16	3'-8 3/4" X 3'-10 3/8"	TEMP. OVER LAM. LOW E	COPPER FLASHING & VALLEYS

NO.	DATE	REVISIONS	DRWN	CHKD

TIMOTHY D. SMITH & ASSOCIATES, PC ARCHITECTS
OLD RAILROAD STATION
802-442-8184
NORTH BENNINGTON, VERMONT 05257
FAX 802-442-5241

WRIGHT ENGINEERING, LTD.
CIVIL ENGINEERS
128 MERCHANTS ROW – P.O. BOX 178
RUTLAND, VERMONT 05702-0178
802-775-2811 FAX 775-8915

ROBT W. HALL
CONSULTING ENGINEERS, INC.
640 MEADOW STREET EXTENSION, STE. 2
AGAWAM, MASSACHUSETTS 01001-9002
413-789-0880 FAX 789-3296

T.J. BOYLE AND ASSOCIATES
LANDSCAPE ARCHITECTS
301 COLLEGE STREET
BURLINGTON, VERMONT 05401
802-658-3555 FAX 863-1562

REGISTERED ARCHITECT TIMOTHY D. SMITH NO. 711 STATE OF VERMONT

PROJECT NO.IM 091-1 (30)
SOUTHEAST VERMONT WELCOME CENTER
GUILFORD, VERMONT

SHEET TITLE: WELCOME CENTER BUILDING ELEVATIONS

DSGN BY:
DRWN BY:
CHKD BY:
CHKD BY:

STATE OF VERMONT
AGENCY OF ADMINISTRATION
DEPARTMENT OF
BUILDINGS & GENERAL SERVICES

DATE: 1-16-98 SHEET NO._____OF_____SHEETS

A4