FINISH FLOOR 0'-0" = 125.70 METERS

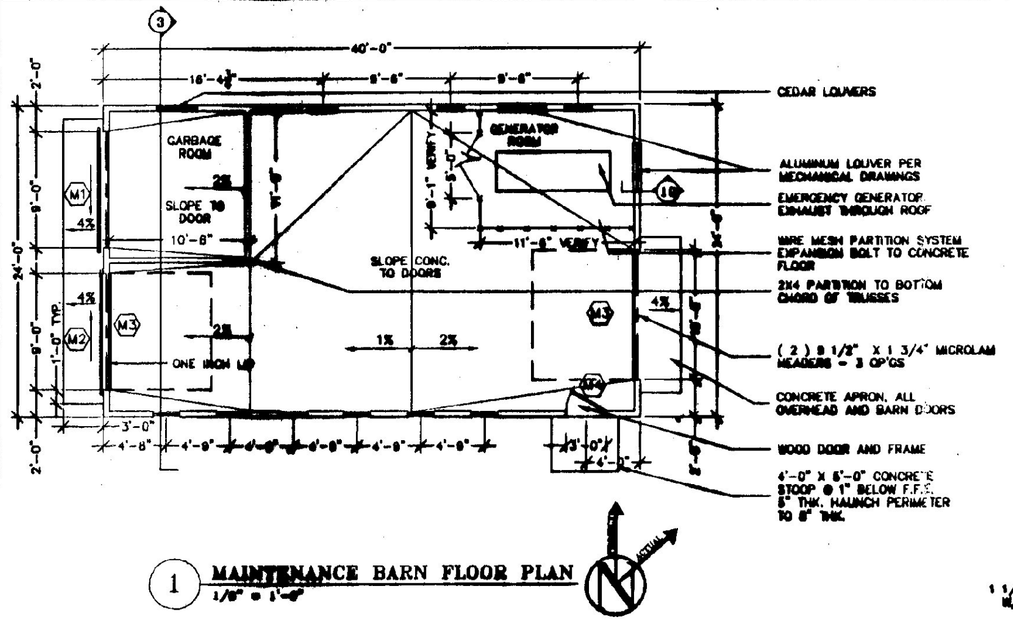

1 MAINTENANCE BARN FLOOR PLAN
1/8" = 1'-0"

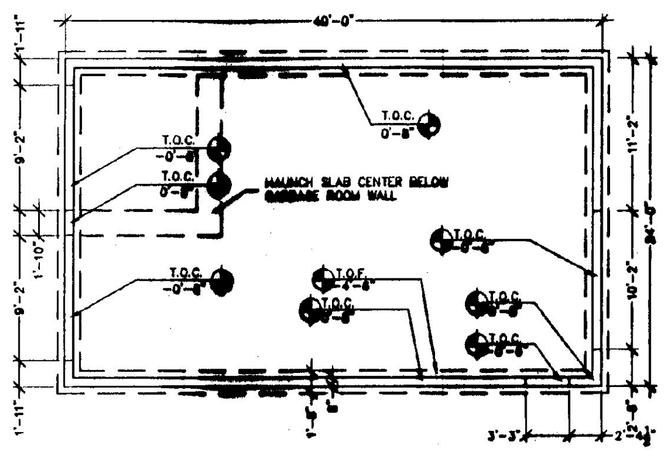

2 MAINTENANCE BARN FOUNDATION PLAN
1/8" = 1'-0"

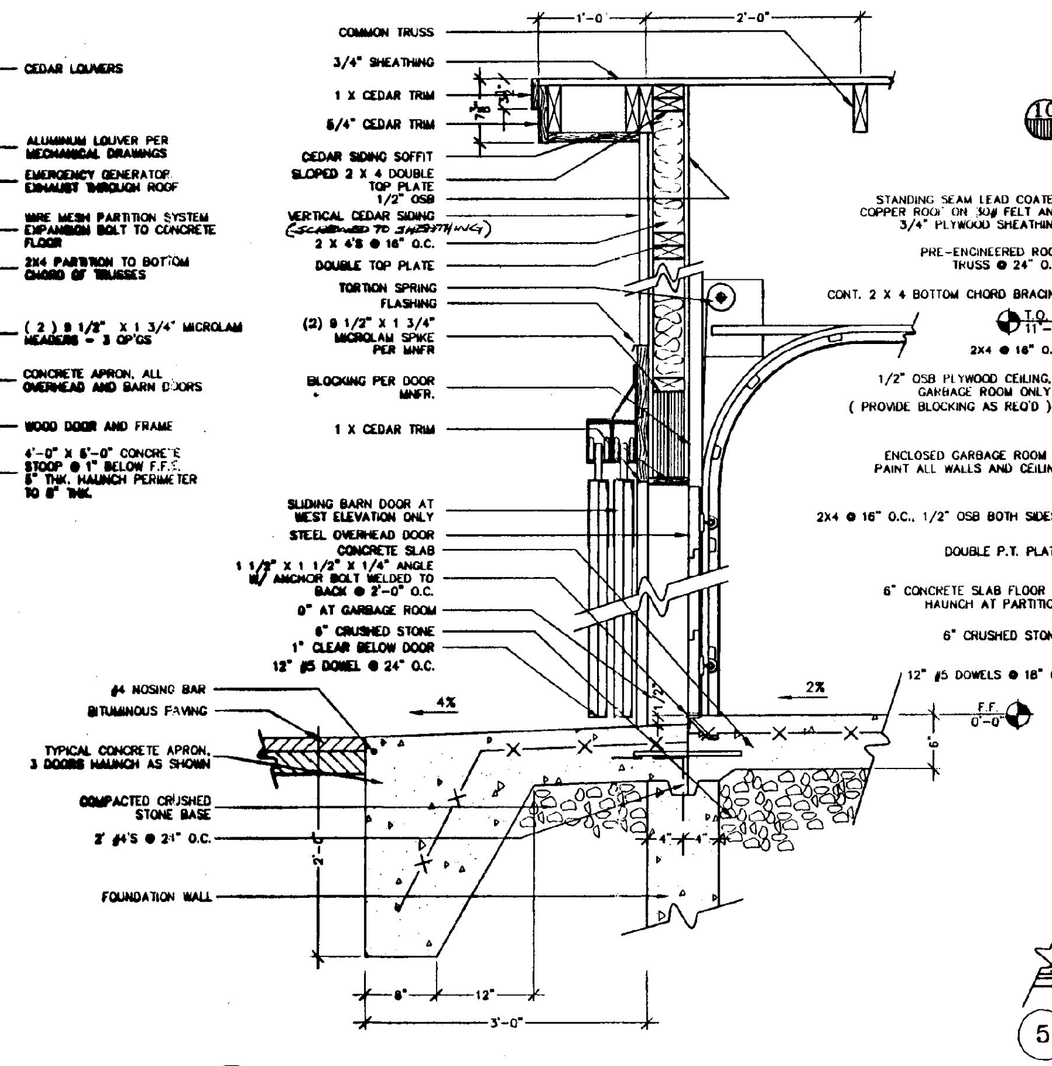

4 MAINTENANCE BARN RAKE AND APRON SECTION
1" = 1'-0"

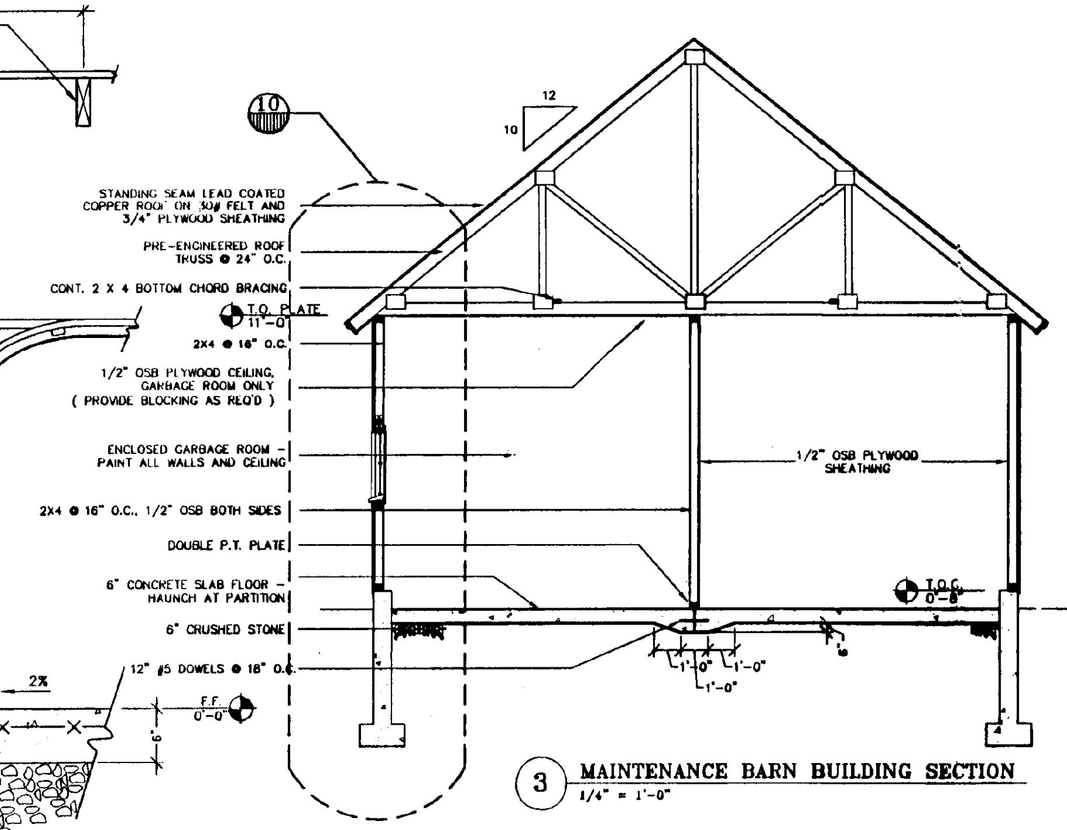

3 MAINTENANCE BARN BUILDING SECTION
1/4" = 1'-0"

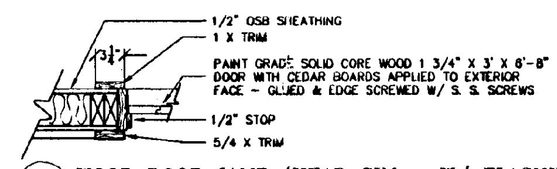

5 WOOD DOOR JAMB (HEAD SIM - W/ FLASHING ABOVE TRIM)
1" = 1'-0"

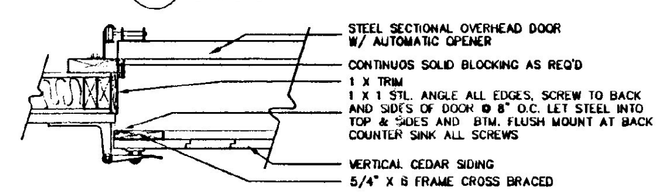

6 SLIDING BARN DOOR SECTION
1" = 1'-0"

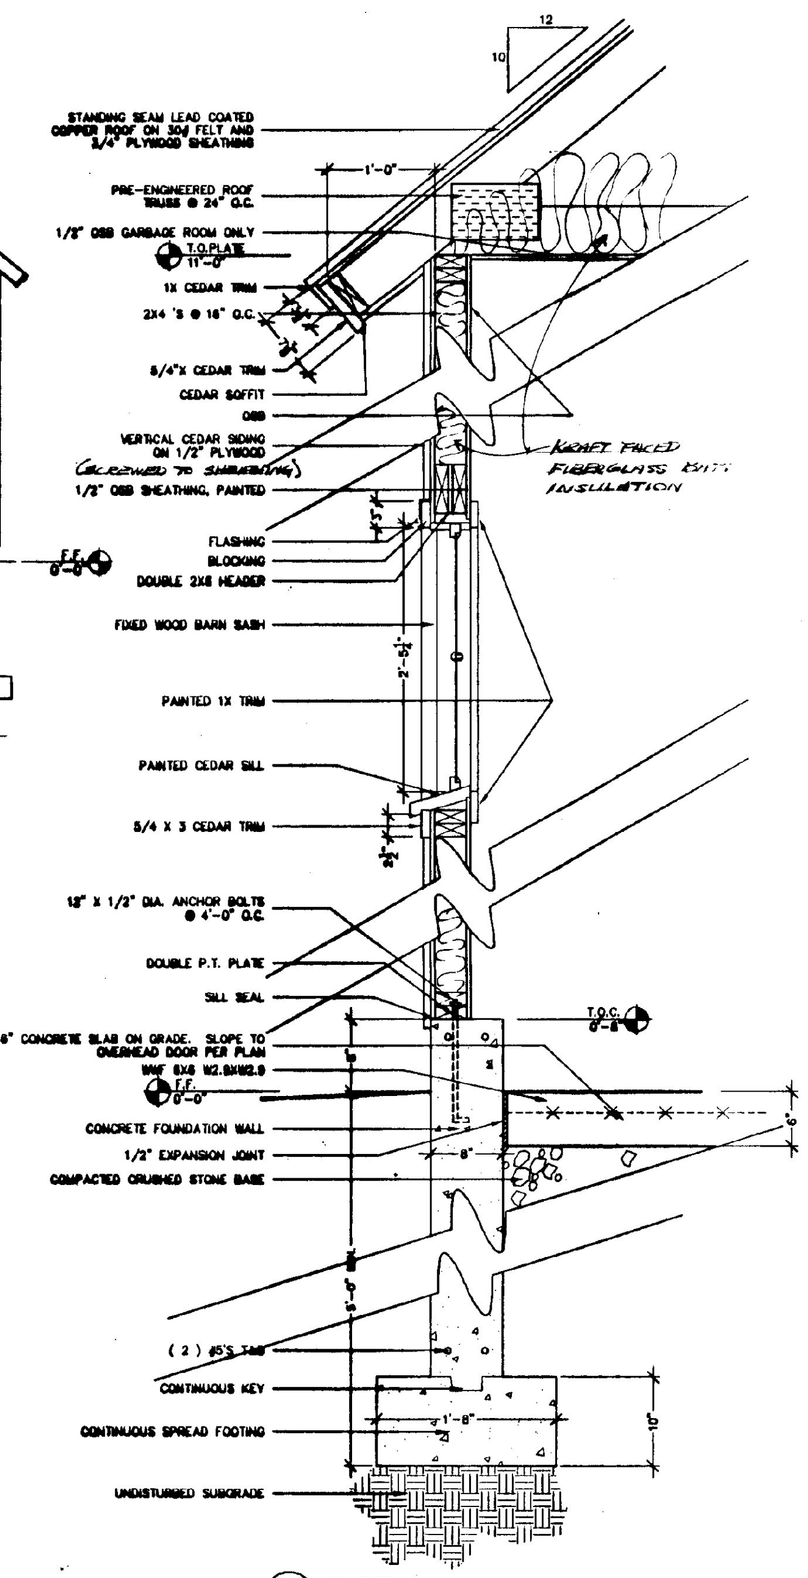

10 MAINTENANCE BARN WALL SECTION
1" = 1'-0"

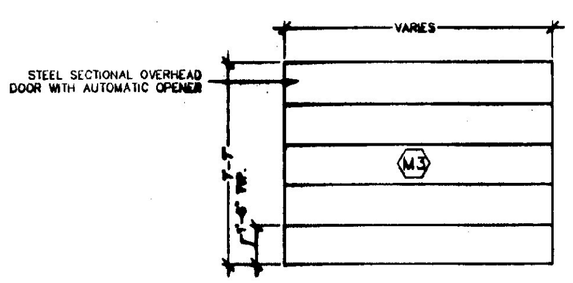

7 OVERHEAD BARN DOOR
1/4" = 1'-0"

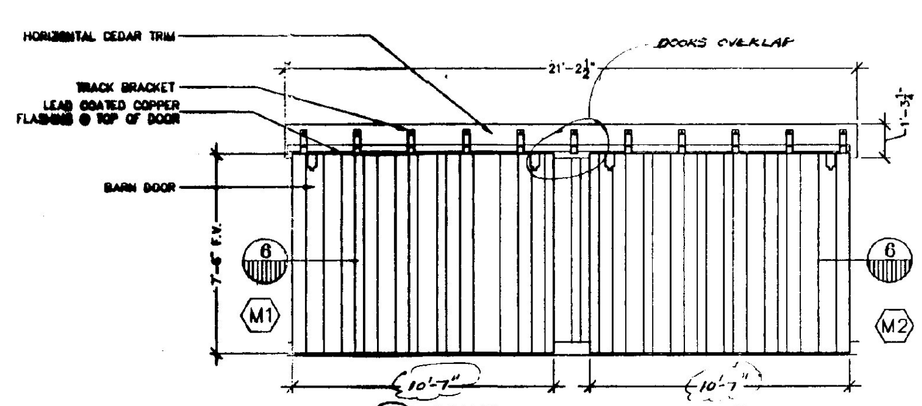

8 DOUBLE SLIDING BARN DOOR
1/4" = 1'-0"

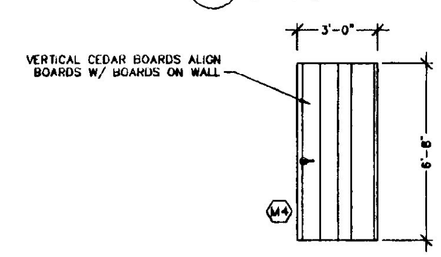

9 WOOD DOOR
1/4" = 1'-0"

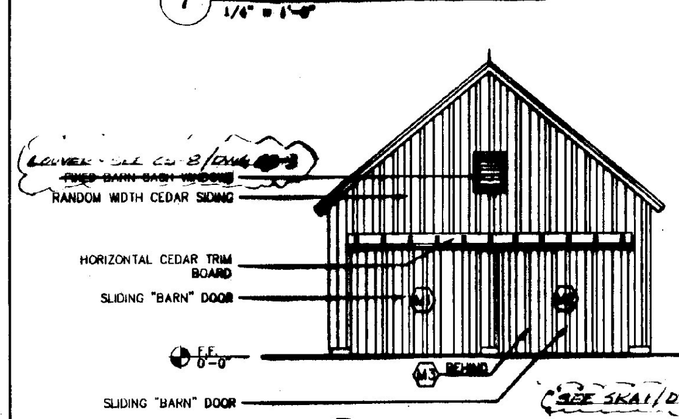

11 MAINTENANCE BARN WEST ELEVATION
1/8" = 1'-0"

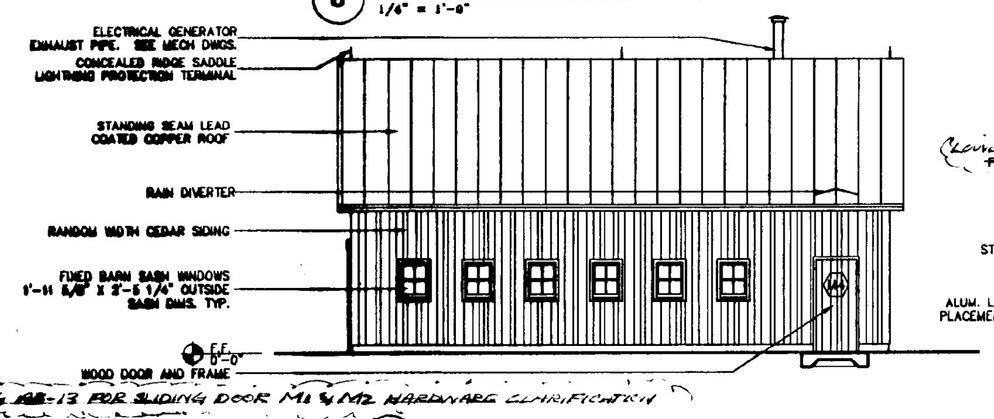

12 MAINTENANCE BARN SOUTH ELEVATION
1/8" = 1'-0"

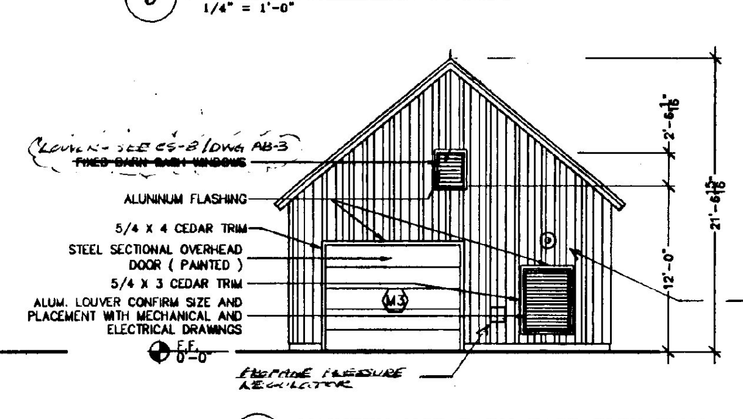

13 MAINTENANCE BARN EAST ELEVATION
1/8" = 1'-0"

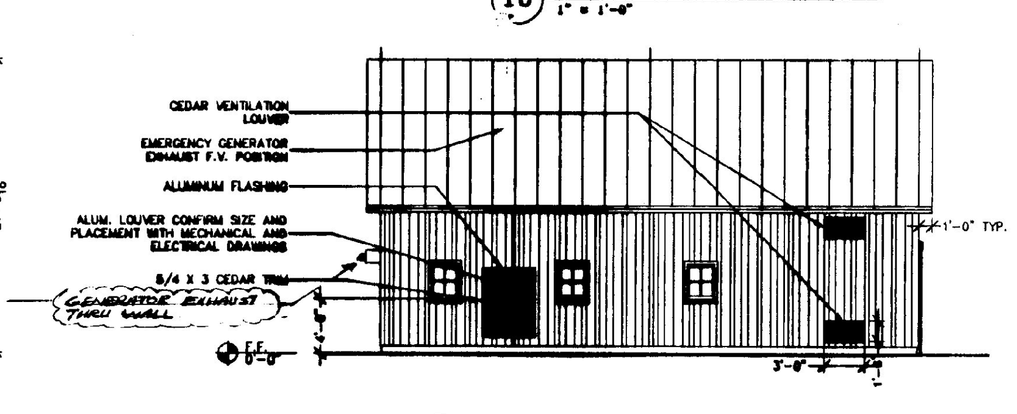

14 MAINTENANCE BARN NORTH ELEVATION
1/8" = 1'-0"

		RECORD DRAWING		
NO.	DATE	REVISIONS	DRWN	CHKD

TIMOTHY D. SMITH & ASSOCIATES, PC ARCHITECTS
OLD RAILROAD STATION
802-442-8184
NORTH BENNINGTON, VERMONT 05257
FAX 802-442-5241

WRIGHT ENGINEERING, LTD.
CIVIL ENGINEERS
100 MERCHANTS ROW - P.O. BOX 178
BURLINGTON, VERMONT 05402-0178
802-862-0611 FAX 862-8015

BOBT W. HALL
CONSULTING ENGINEERS, INC.
540 MEADOW STREET EXTENSION, STE. 2
AGAWAM, MASSACHUSETTS 01001-0002
413-789-0580 FAX 789-2886

T.J. BOYLE AND ASSOCIATES
LANDSCAPE ARCHITECTS
301 COLLEGE STREET
BURLINGTON, VERMONT 05401
802-658-3056 FAX 863-1562

REGISTERED ARCHITECT TIMOTHY D. SMITH NO. 711 STATE OF VERMONT

PROJECT NO.IM 091-1 (30)
SOUTHEAST VERMONT WELCOME CENTER
GUILFORD, VERMONT

SHEET TITLE: MAINTENANCE BARN

DSGN BY:
DRWN BY:
CHKD BY:
CHKD BY:

STATE OF VERMONT
AGENCY OF ADMINISTRATION
DEPARTMENT OF
BUILDINGS & GENERAL SERVICES

DATE: 1-16-98 SHEET NO._____OF_____SHEETS

A22