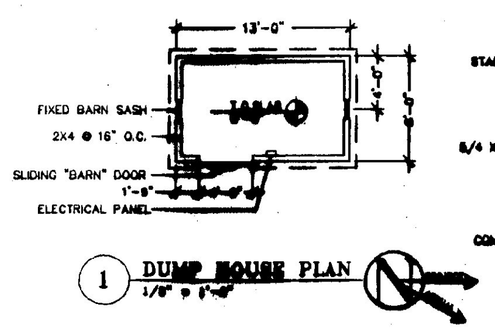

1 DUMP HOUSE PLAN
1/8" = 1'-0"

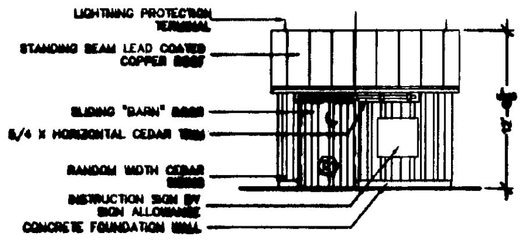

3 DUMP HOUSE FRONT ELEVATION
1/8" = 1'-0"

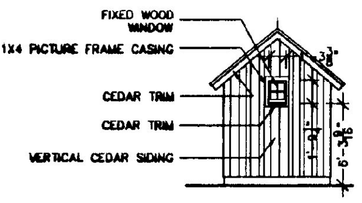

4 DUMP HOUSE SIDE ELEVATION
1/8" = 1'-0"

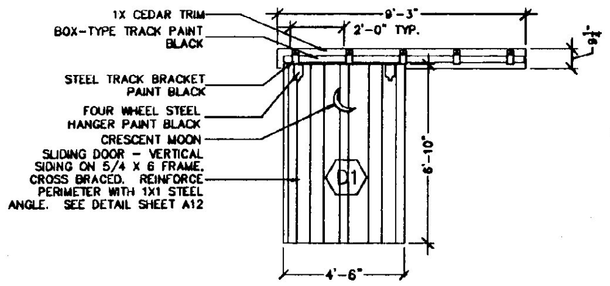

5 DUMP HOUSE SLIDING DOOR
1/4" = 1'-0"

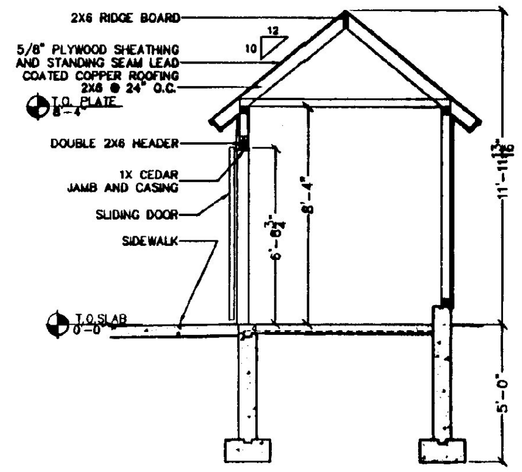

6 DUMP HOUSE BUILDING SECTION
1/4" = 1'-0"

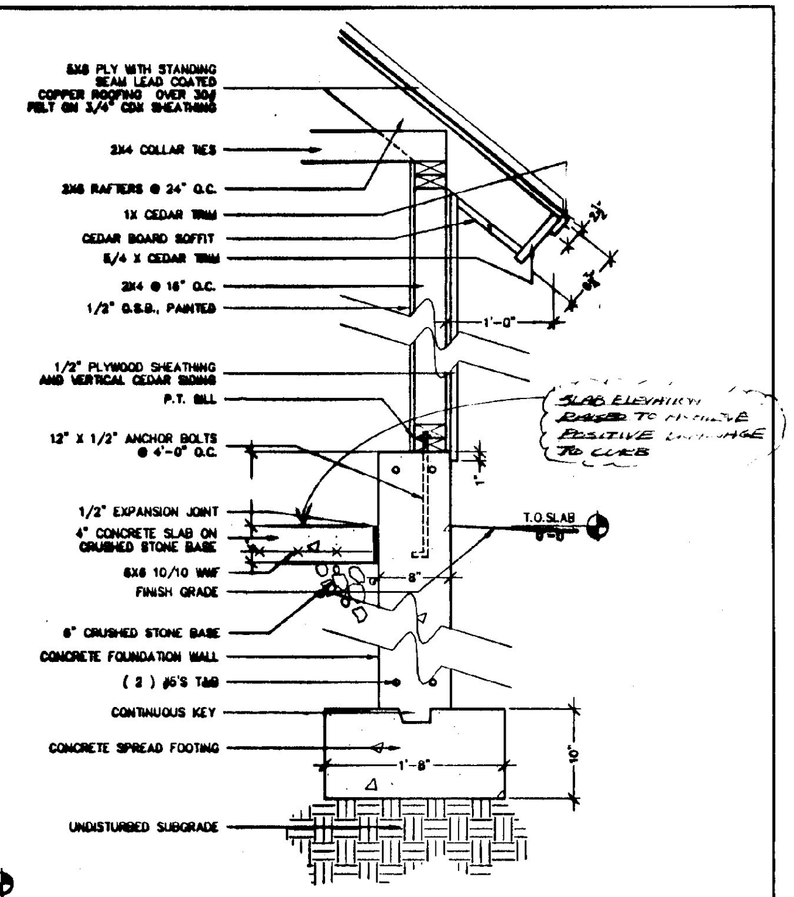

7 DUMP HOUSE WALL SECTION
1" = 1'-0"

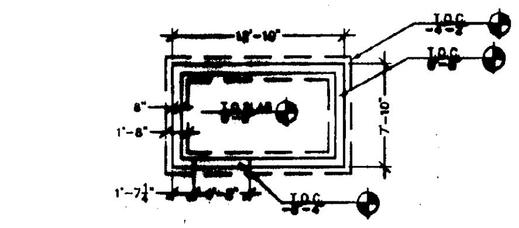

2 DUMP HOUSE FOUNDATION PLAN
1/8" = 1'-0"

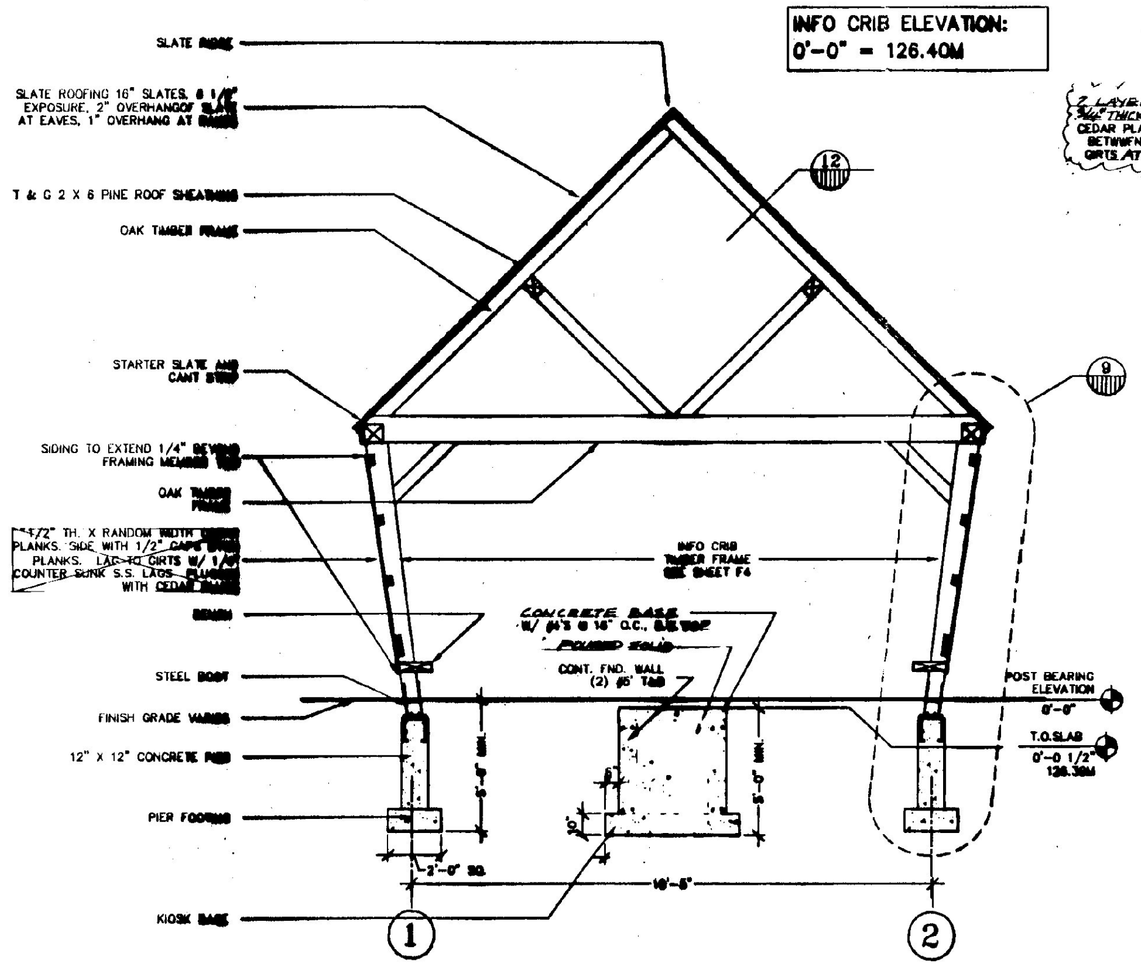

8 INFO CRIB BUILDING SECTION
1/4" = 1'-0"

INFO CRIB ELEVATION:
0'-0" = 126.40M

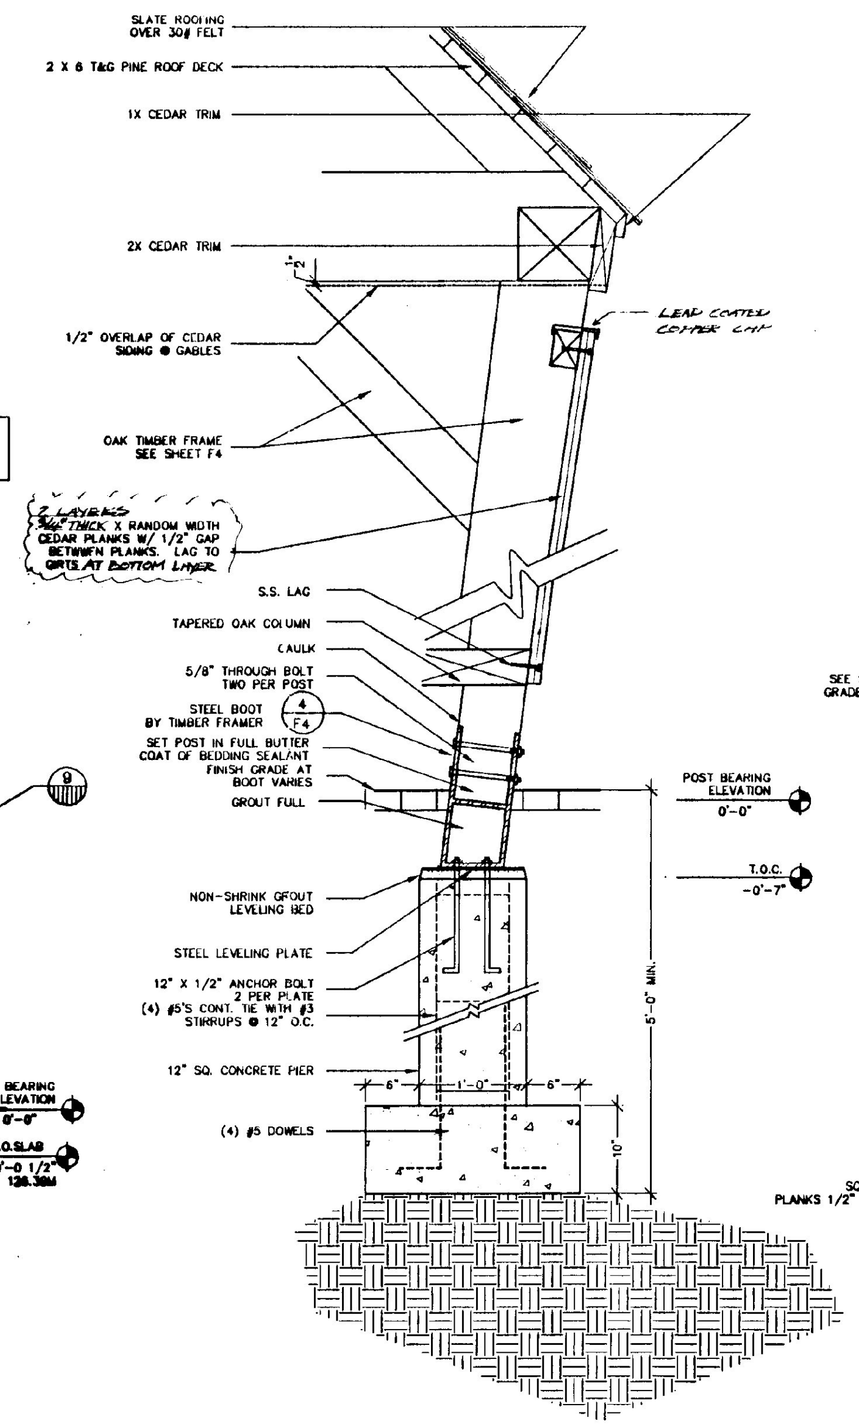

9 INFO CRIB "WALL" SECTION
1" = 1'-0"

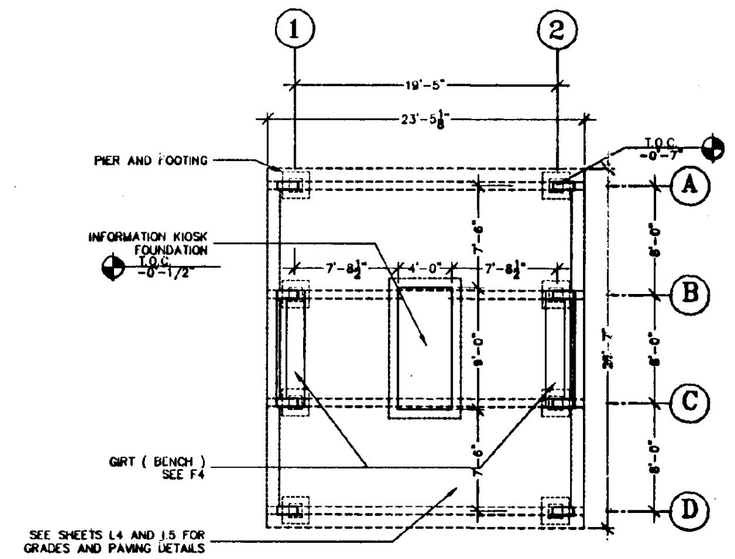

10 INFO CRIB PLAN
1/8" = 1'-0"

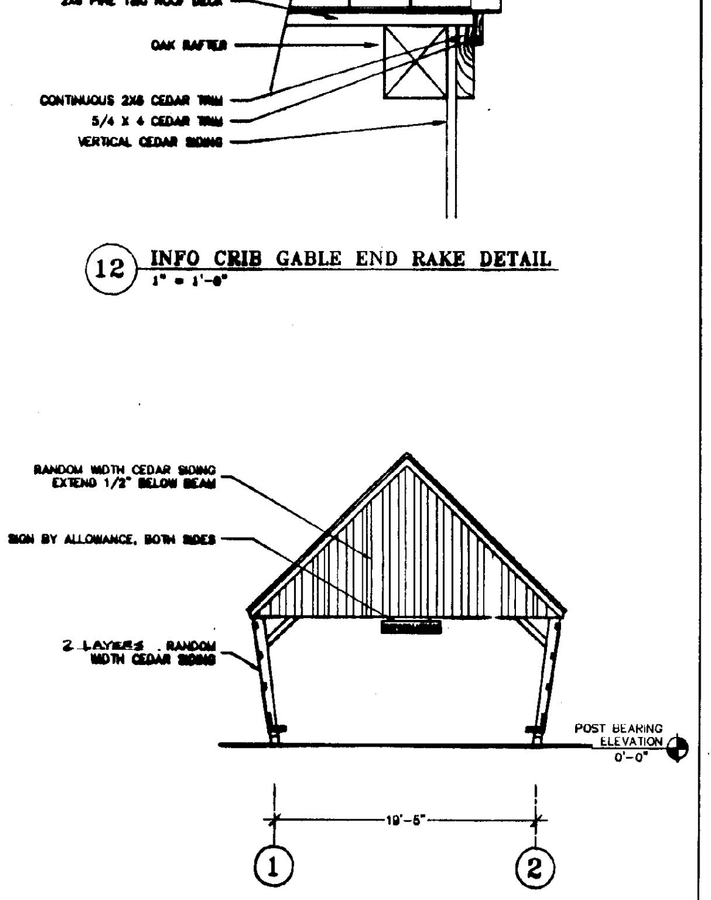

12 INFO CRIB GABLE END RAKE DETAIL
1" = 1'-0"

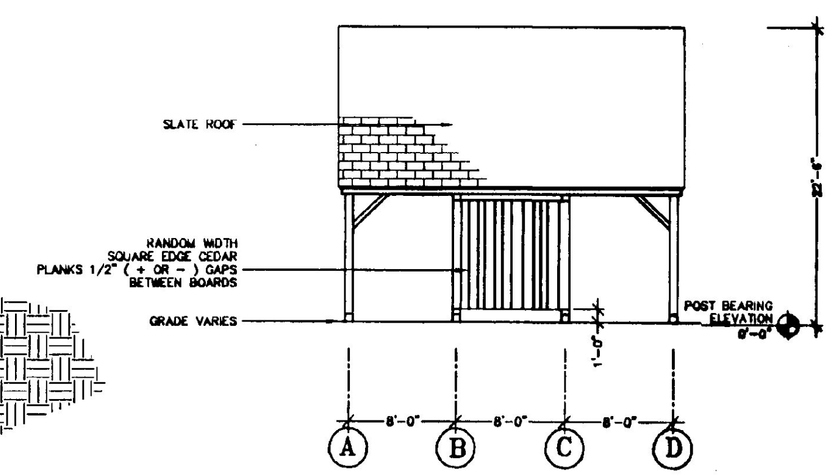

11 INFO CRIB SIDE ELEVATION (N. & S.)
1/8" = 1'-0"

13 INFO CRIB FRONT ELEVATION (E. & W.)
1/8" = 1'-0"

RECORD DRAWING

NO.	DATE	REVISIONS	DRWN	CHKD

TIMOTHY D. SMITH & ASSOCIATES, PC ARCHITECTS
OLD RAILROAD STATION
802-442-8184
NORTH BENNINGTON, VERMONT 05257
FAX 802-442-5241

WRIGHT ENGINEERING, LTD.
CIVIL ENGINEERS
138 MERCHANTS ROW - P.O. BOX 178
BURLINGTON, VERMONT 05402-0178
802-862-0011 FAX 862-6045

ROBT W. HALL
CONSULTING ENGINEERS, INC.
540 MEADOW STREET EXTENSION, STE. 2
AGAWAM, MASSACHUSETTS 01001-0002
413-789-0880 FAX 789-2886

T.J. BOYLE AND ASSOCIATES
LANDSCAPE ARCHITECTS
301 COLLEGE STREET
BURLINGTON, VERMONT 05401
802-658-3585 FAX 863-1562

REGISTERED ARCHITECT TIMOTHY D. SMITH NO. 731 STATE OF VERMONT

PROJECT NO.IM 091-1 (30)
SOUTHEAST VERMONT WELCOME CENTER
GUILFORD, VERMONT

SHEET TITLE: INFO CRIB & RV DUMP BLDG

DSGN BY:
DRWN BY:
CHKD BY:
CHKD BY:

STATE OF VERMONT
AGENCY OF ADMINISTRATION
DEPARTMENT OF
BUILDINGS & GENERAL SERVICES

DATE: 1-16-98 SHEET NO._____OF_____SHEETS

A23