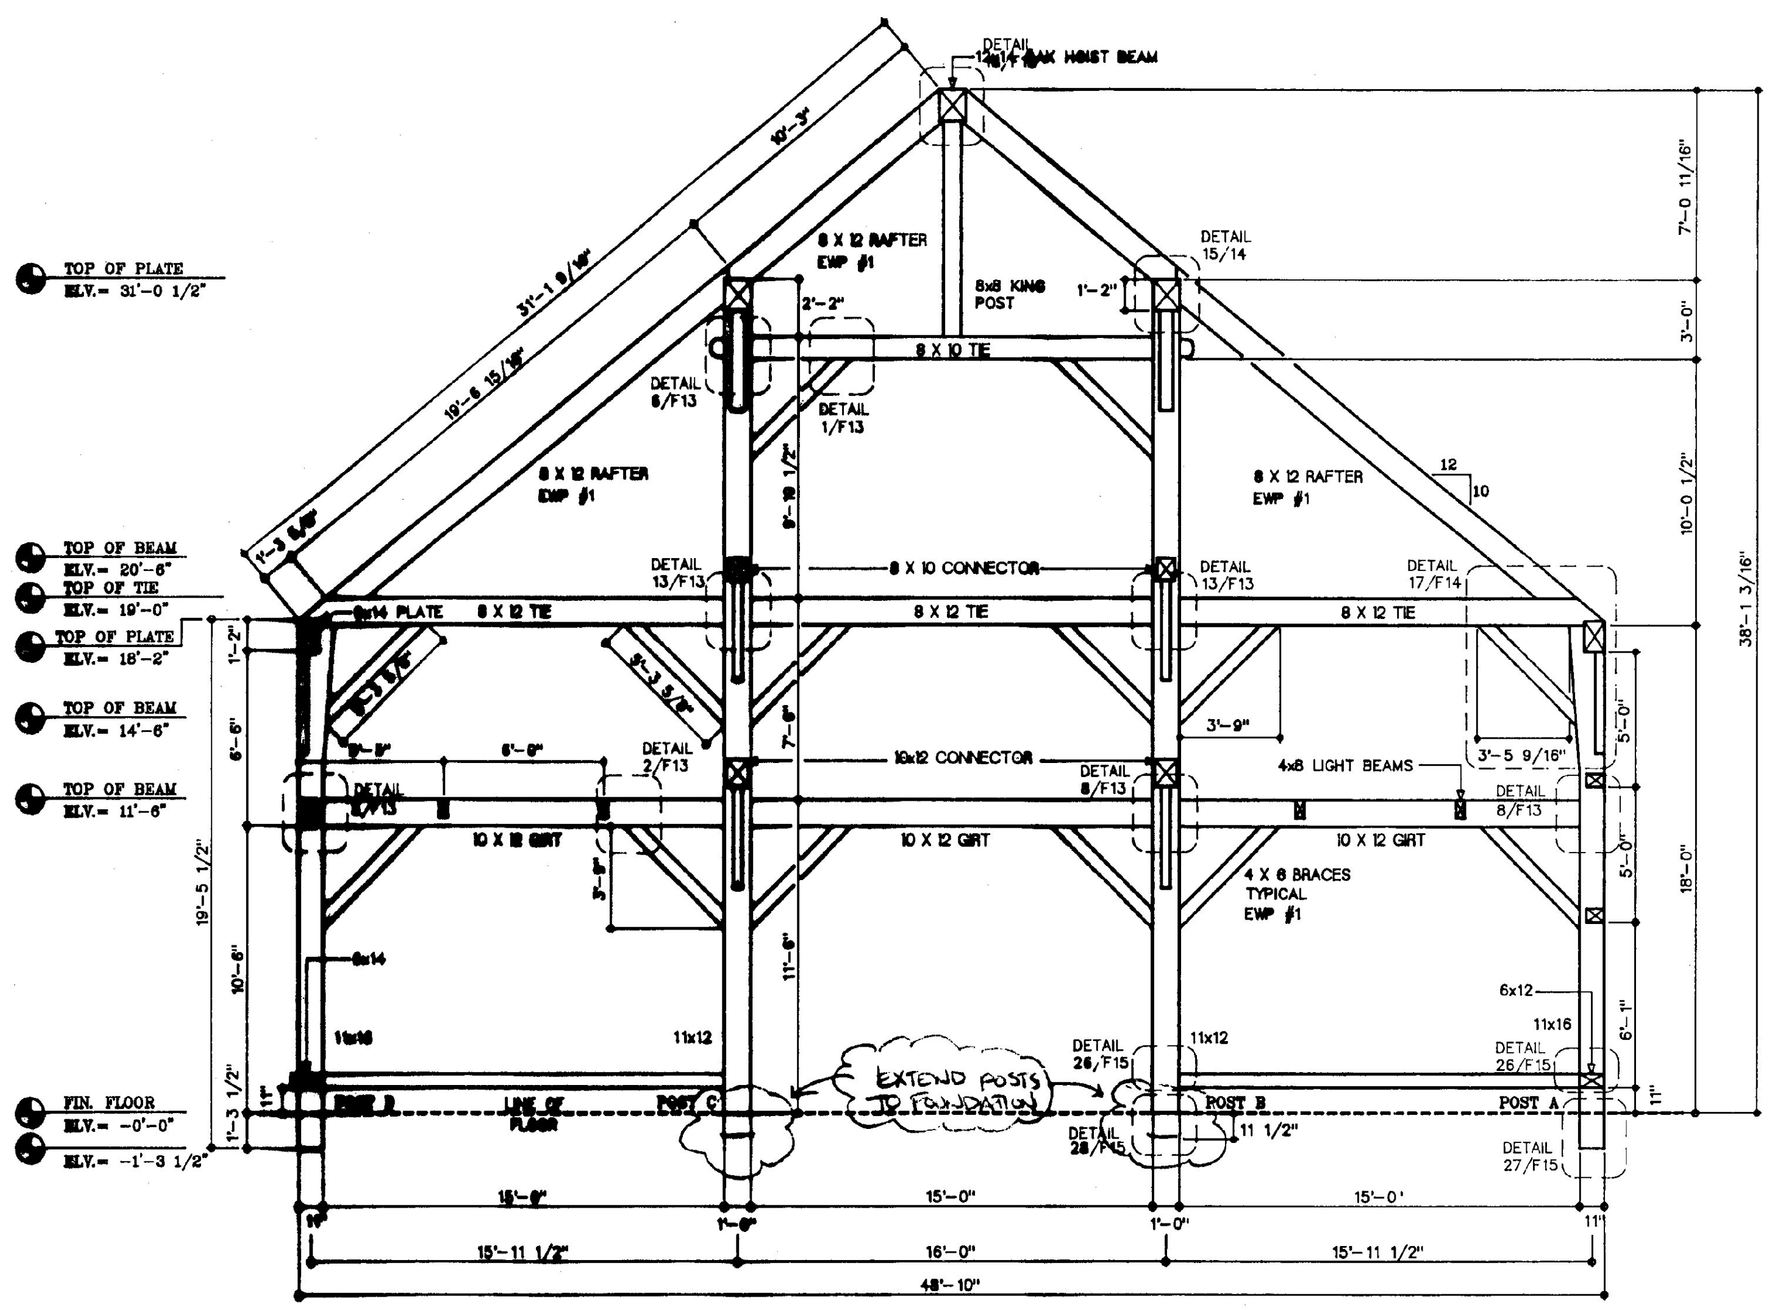


**BENT 7**

RECORD DRAWING

NOTE: ALL TIMBER TO BE EASTERN WHITE PINE #2 & BETTER GRADED FOR APPEARANCE UNLESS OTHERWISE NOTED
ALL PEGS TO BE 1" BIRCH

| REVISIONS | BY |
|---|---|
| | |
| | |
| | |
| | |
| | |
| | |
| | |

VERMONT TIMBER WORKS
SOUTH LONDONDERRY, VT
802-824-5503

SHOP DRAWINGS

BENT 7

ARCH: TIMOTHY D. SMITH & ASSOCIATES
ENG: DUFRESNE & HENRY
G.C.: NEAGLEY & CHASE

PROJECT:
SOUTHEAST VERMONT WELCOME CENTER
GUILFORD, VERMONT

| DRAWN : D.F. | CHECKED : |
|---|---|
| DATE : 8/15/98 | |
| SCALE : 1/4"= 1'-0" | |
| JOB NO. : | |
| SHEET F-6 | |
| OF SHEETS | |