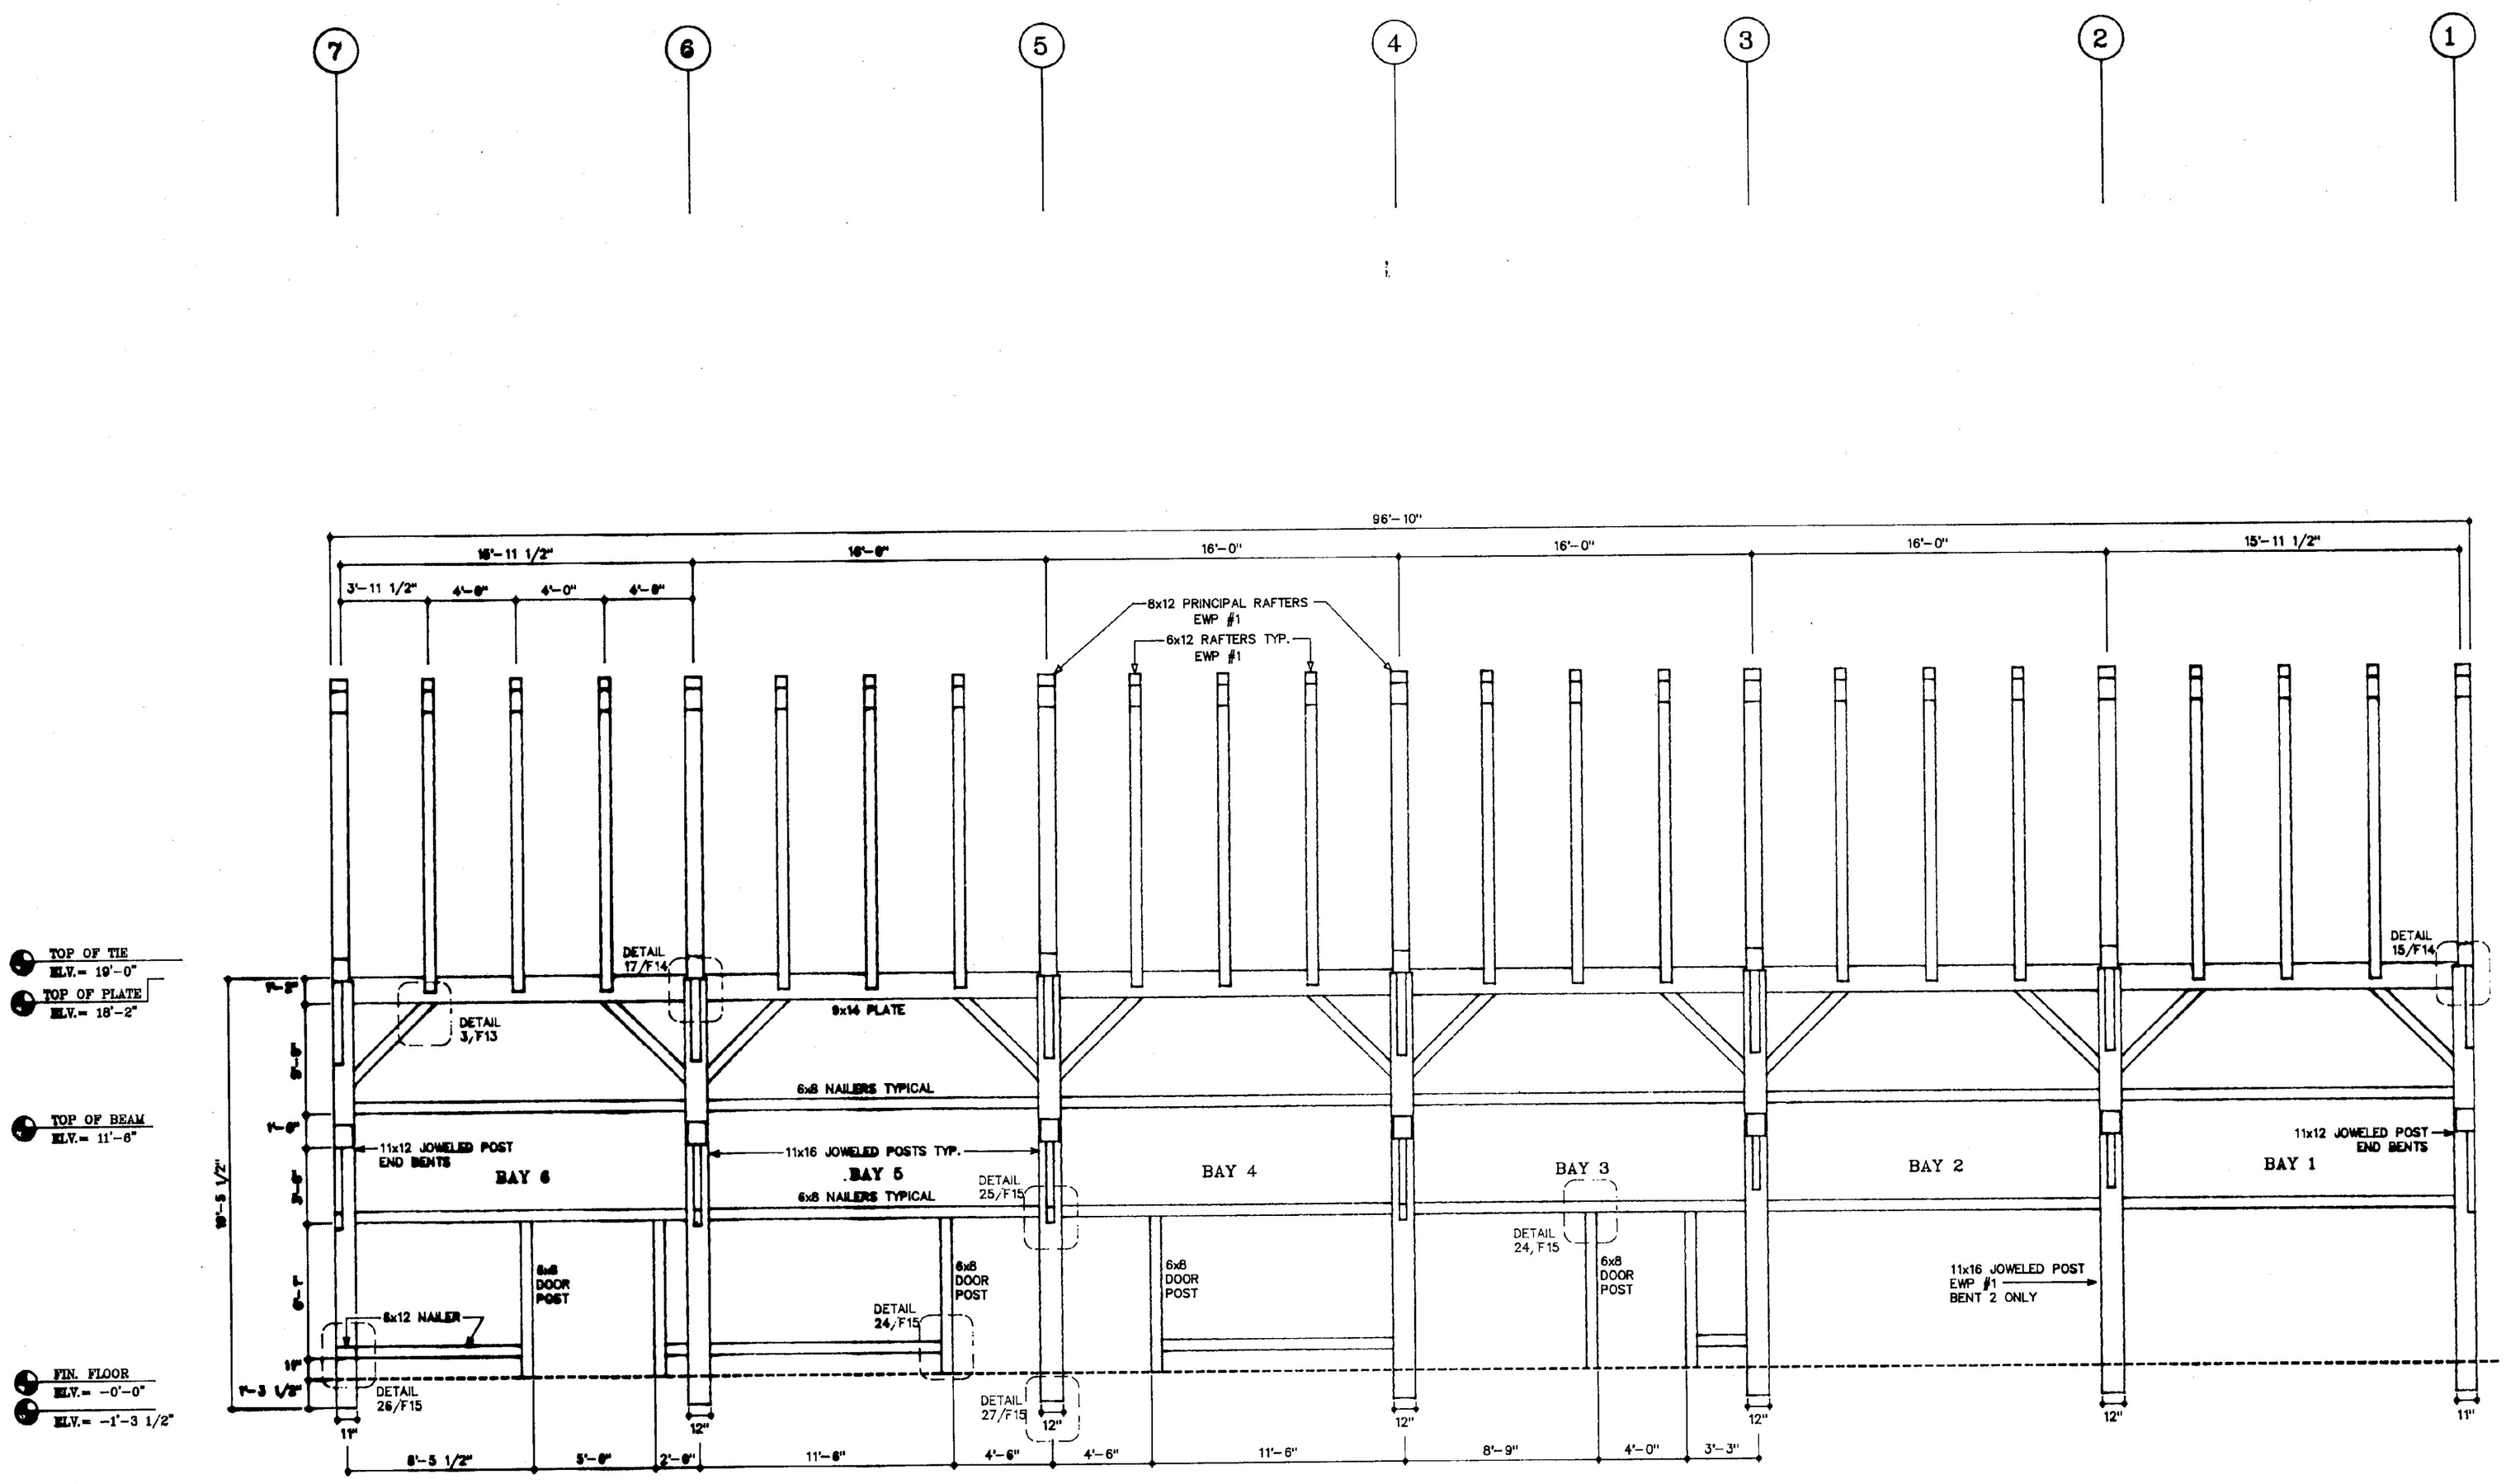

LINE A FRAMING PROFILE

RECORD DRAWING

NOTE: ALL TIMBER TO BE EASTERN WHITE PINE #2 & BETTER GRADED FOR APPEARANCE UNLESS OTHERWISE NOTED
ALL PEGS TO BE 1" BIRCH

REVISIONS	BY

VERMONT TIMBER WORKS
SOUTH LONDONDERRY, VT
802-824-5503

SHOP DRAWINGS

FRAMING PROFILE
LINE A

ARCH: TIMOTHY D. SMITH & ASSOCIATES
ENG: DUFRESNE & HENRY
G.C.: NEAGLEY & CHASE

SOUTHEAST VERMONT WELCOME CENTER
PROJECT: GUILFORD, VERMONT

DRAWN : D.F.	CHECKED :
DATE : 8/15/98	
SCALE : 1/4"= 1'-0"	
JOB NO. :	
SHEET F-7	
OF SHEETS	