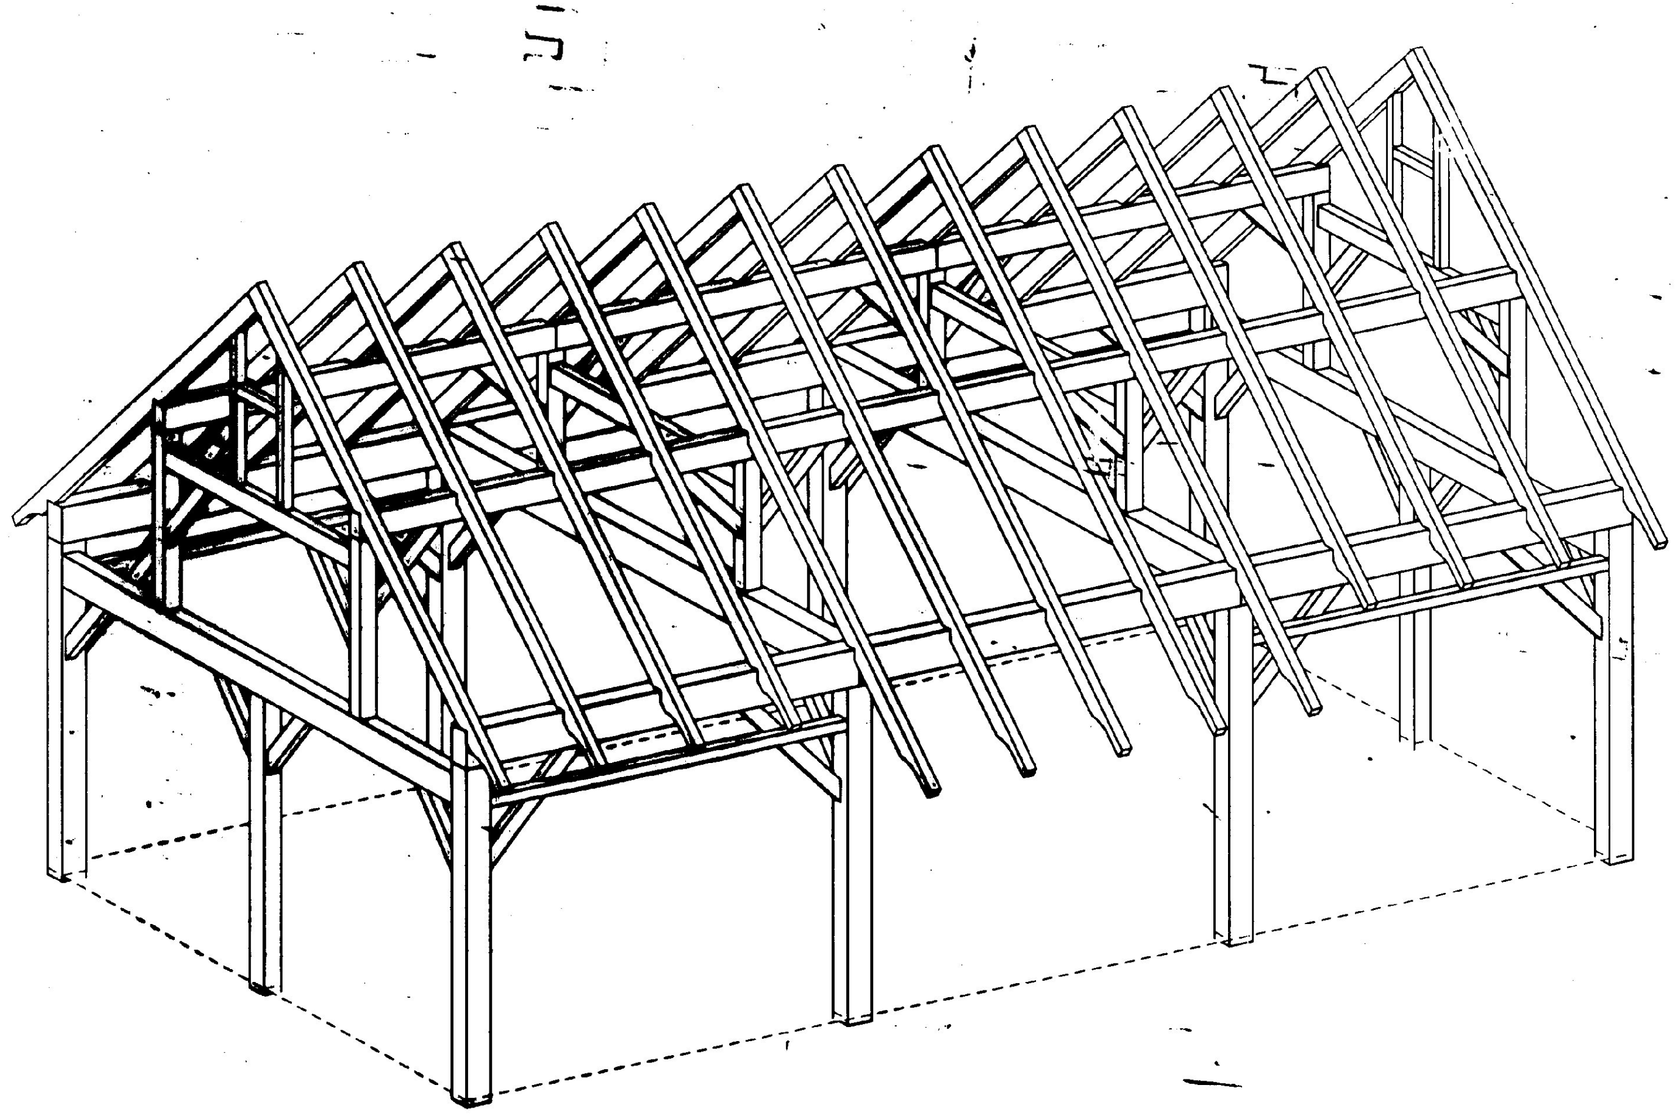

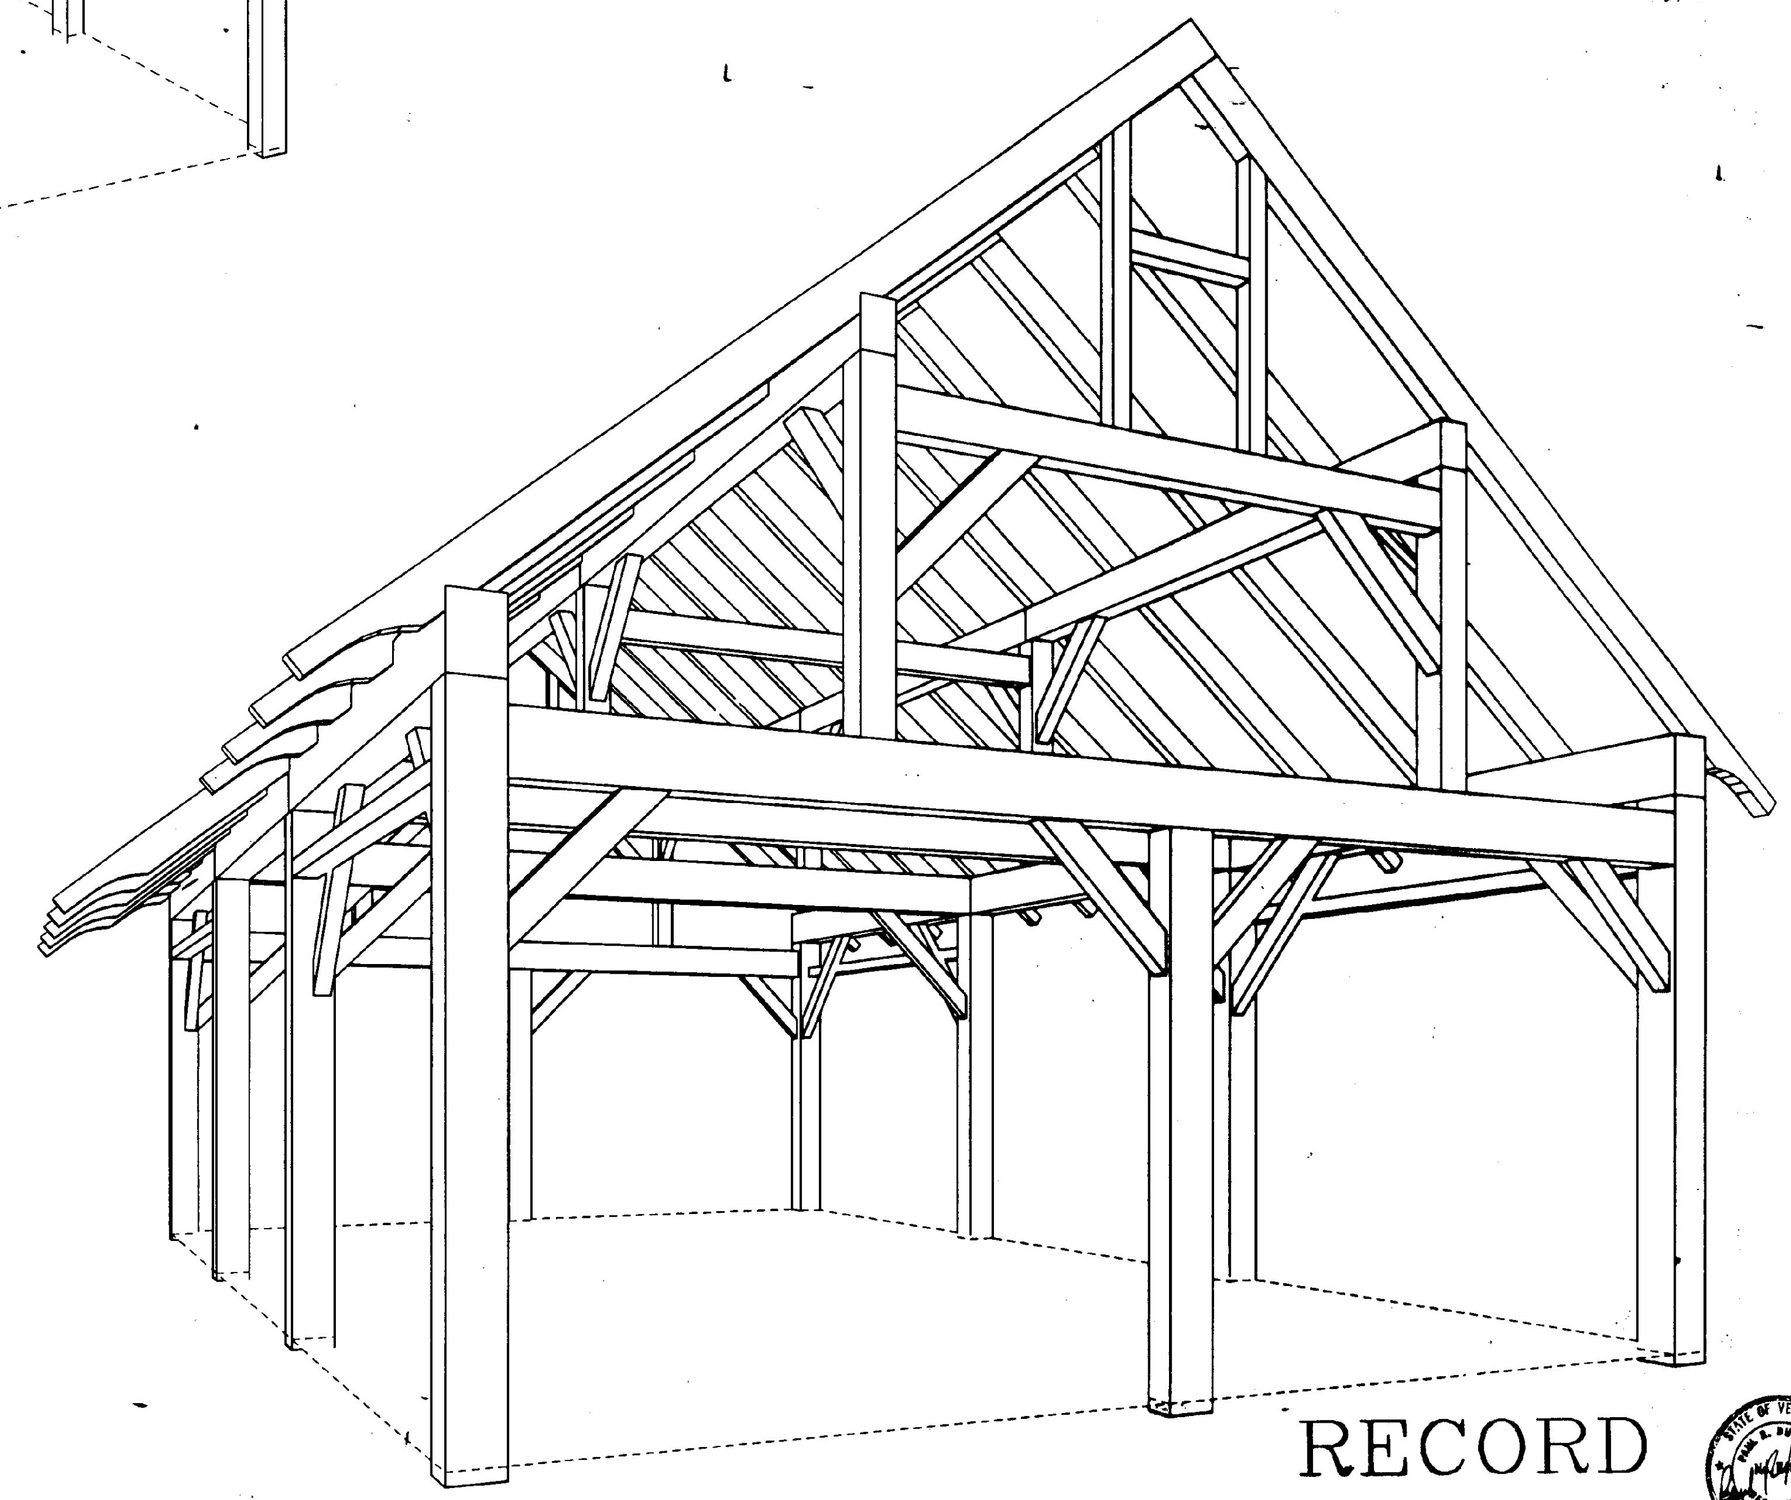

RECORD DRAWING

REVISIONS	BY

VERMONT TIMBER WORKS
SOUTH LONDONDERRY, VT
802-824-5503

SHOP DRAWINGS

PERSPECTIVES

ARCH: TIMOTHY D. SMITH & ASSOCIATES
ENG: DUFRESNE & HENRY
G.C.: NEAGLEY & CHASE

PROJECT: SOUTHEAST VERMONT WELCOME CENTER
PICNIC SHED
GUILFORD, VERMONT

DRAWN : D.F.	CHECKED :
DATE : 9/14/98	
SCALE : 1/4"= 1'-0"	
JOB NO. :	
SHEET F-16	OF SHEETS