



PLAN VIEW

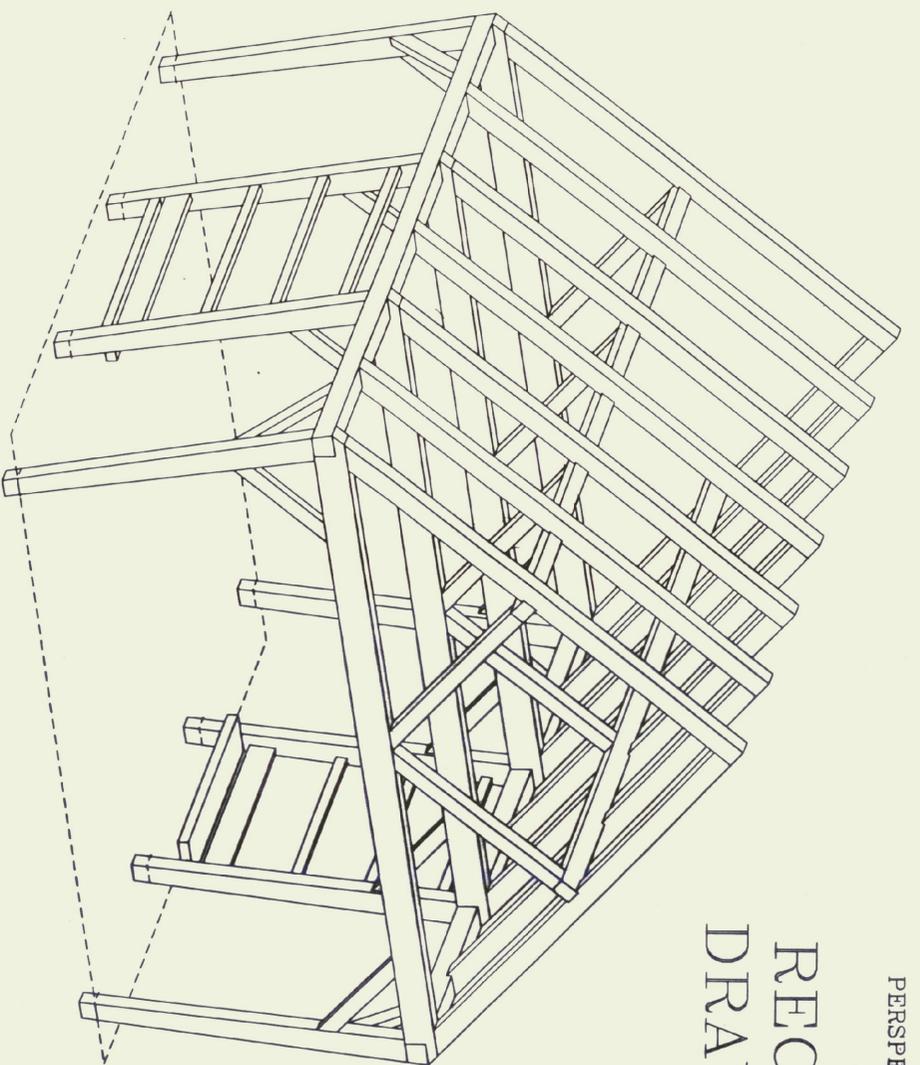


PERSPECTIVE

RECORD
DRAWING

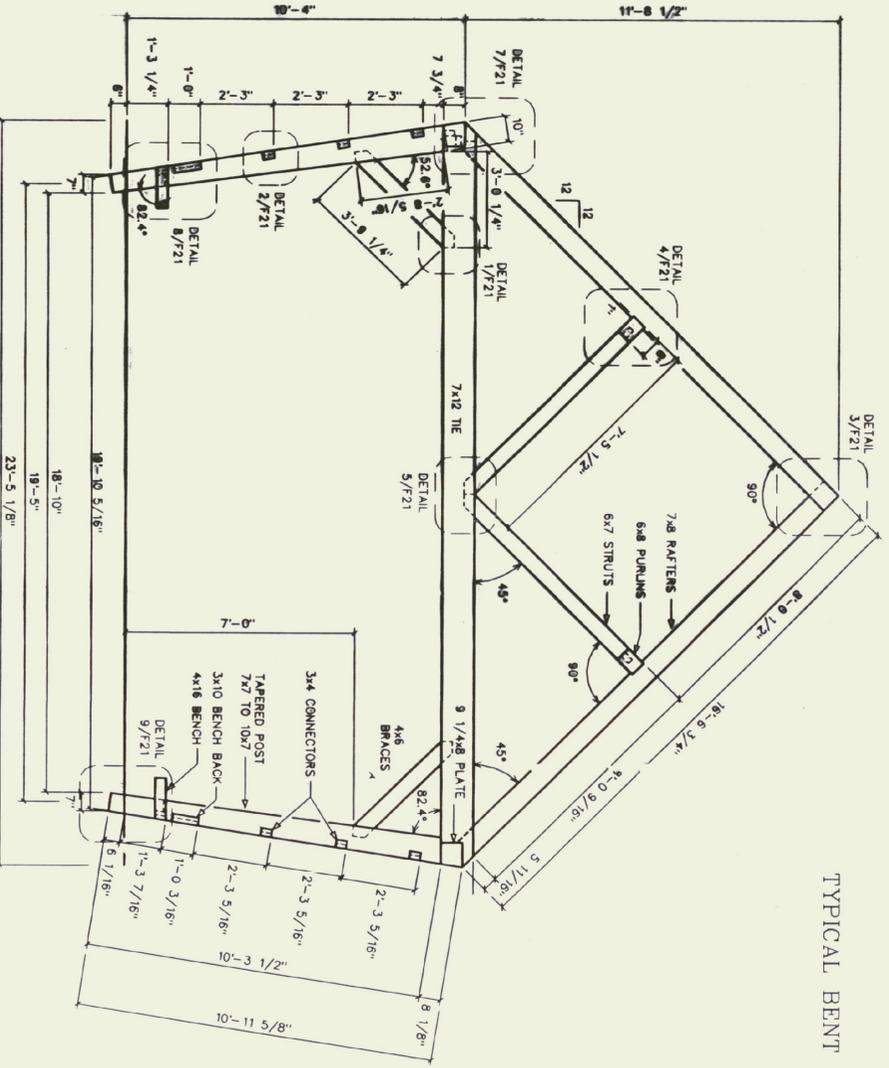

TYPICAL BENT

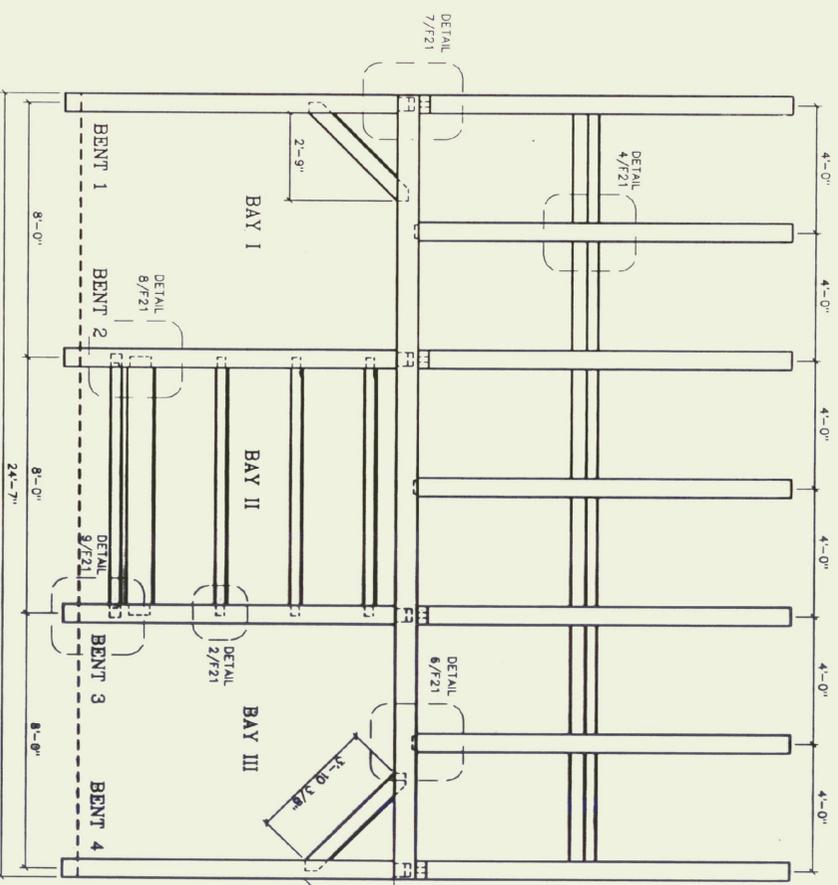

BAY PROFILE



STATE OF VERMONT
TIMOTHY D. SMITH
REGISTERED PROFESSIONAL ENGINEER
9/27/04

PROJECT: **SOUTHEAST VERMONT WELCOME CENTER INFORMATION CRIB**
GUILFORD, VERMONT

ARCH: **TIMOTHY D. SMITH & ASSOCIATES**
ENG: **DUPRESNE & HENRY**
G.C.: **NEAGLEY & CHASE**

SHOP DRAWINGS
CRIB FRAMING

VERMONT TIMBER WORKS
SOUTH LONDONDERRY, VT
802-824-5503

REVISIONS	BY

OF **F-20** SHEETS

DRAWN: **D.F.** CHECKED: **D.F.**
DATE: **9/14/98**
SCALE: **3/8" = 1'-0"**
JOB NO.:
SHEET