




CENTER BRACE DETAIL
DETAIL #1

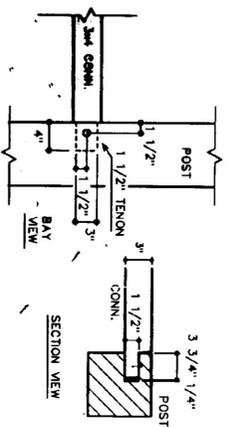



CONNECTOR DETAIL
DETAIL #2

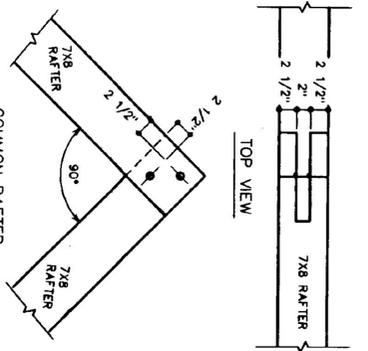


COMMON RAFTER
DETAIL #3

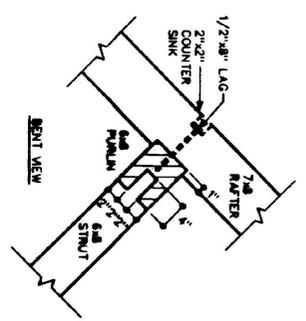



STRUT/PURLIN/RAFTER
DETAIL #4

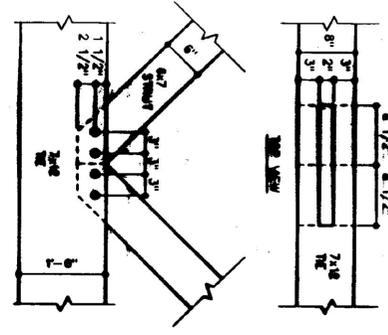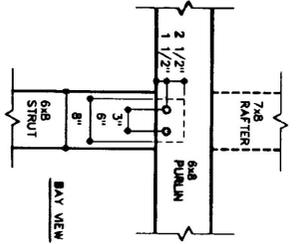



STRUT AT TIE
DETAIL #5

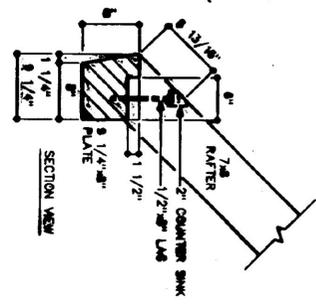




COMMON RAFTER SEAT
DETAIL #6

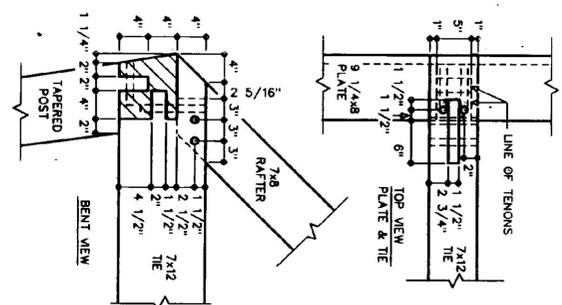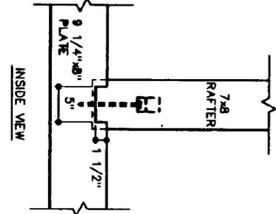


PLATE/TIE/RAFTER
DETAIL #7

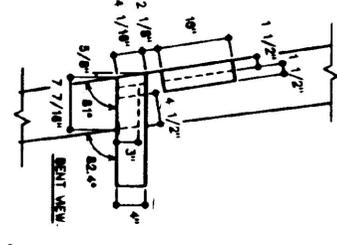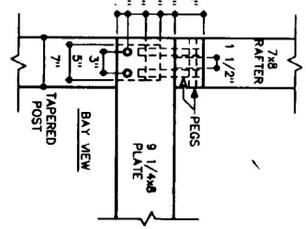

BENCH
DETAIL #8

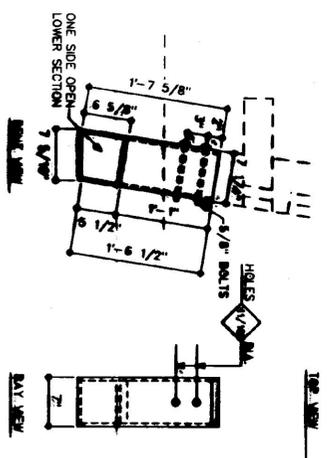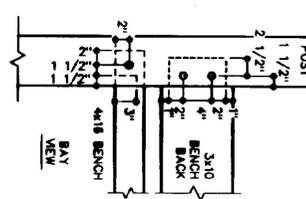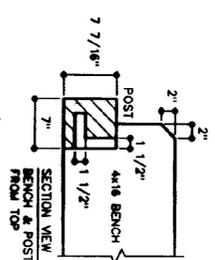

STEEL BASE BOOTS
DETAIL #9 - 8 REQUIRED

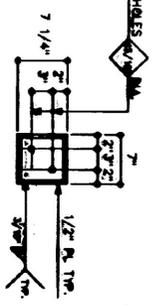

NOTE: 1" CLEAR OAK PEGS TYPICAL FOR ALL EXTERIOR JOINTS

RECORD
DRAWING



SHEET F-21 OF SHEETS	PROJECT: SOUTHEAST VERMONT WELCOME CENTER INFORMATION CRIB GUILFORD, VERMONT	ARCH: TIMOTHY D. SMITH & ASSOCIATES ENG: DUPRESNE & HENRY G.C.: NEAGLEY & CHASE	SHOP DRAWINGS JOINT DETAILS	VERMONT TIMBER WORKS SOUTH LONDONDERRY, VT 802-824-5503	REVISIONS BY
--------------------------------------	---	---	---------------------------------------	--	-----------------