
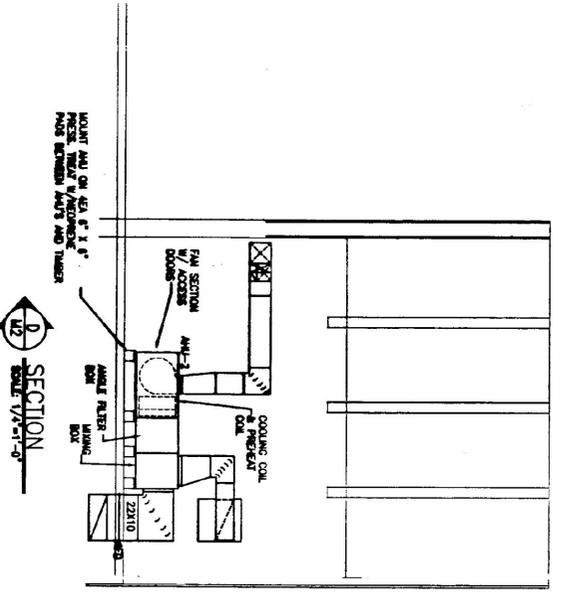
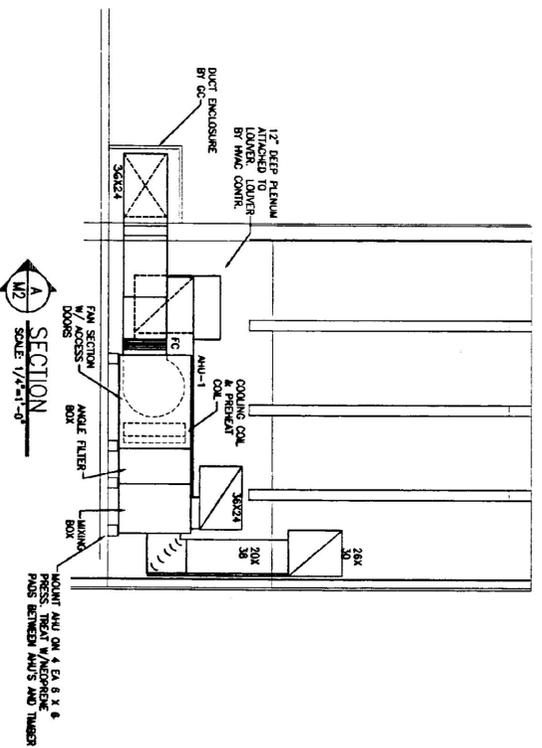
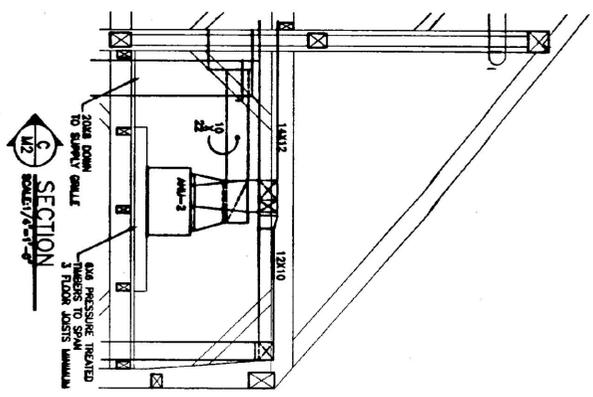


MEZZANINE PLAN

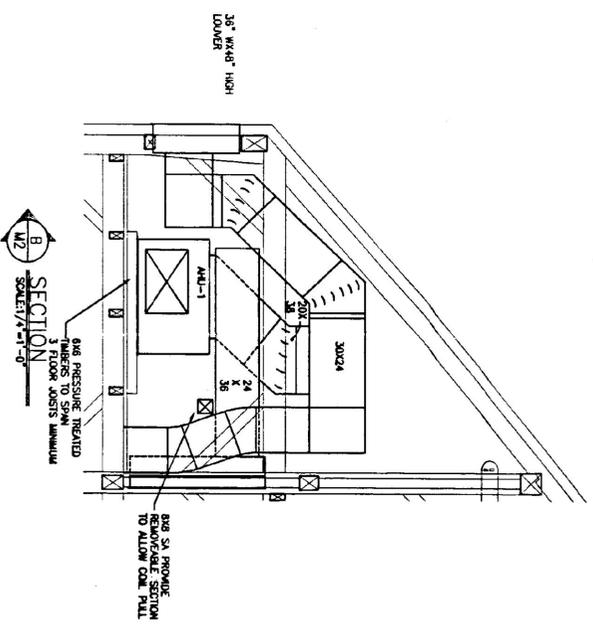

RECORD
DRAWING

| | | | | |
|-----|------|-----------|--------|-------|
| NO. | DATE | REVISIONS | DESIGN | CHECK |
| | | | | |
| | | | | |
| | | | | |
| | | | | |

TIMOTHY D. SMITH & ASSOCIATES, PC ARCHITECTS
 OLD RAILROAD STATION
 802-442-8184
 NORTH BENNINGTON, VERMONT 05257
 FAX 802-442-5241

BURT W. HALL, CONSULTING ENGINEERS, INC.
 640 MAIN STREET
 BURLINGTON, VERMONT 05401

T.J. BOYLE AND ASSOCIATES
 LANDSCAPE ARCHITECTS
 201 COLLIER STREET
 BURLINGTON, VERMONT 05401

PROJECT NO. IM 091-1 (30)
 SOUTHEAST VERMONT WELCOME CENTER
 GUILFORD, VERMONT

STATE OF VERMONT
 AGENCY OF ADMINISTRATION
 DEPARTMENT OF
 BUILDINGS & GENERAL SERVICES

DESIGN BY: RFG
 DRAWN BY: RFG
 CHECK BY: RFG

CHECK BY: RWH

DATE: 1-16-98

SHEET NO. _____ OF _____ SHEETS

M-2